
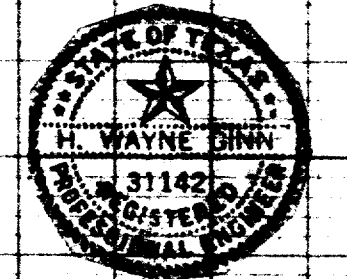


DETAIL "A"  
N.T.S. VOID

TBM - "□" cut on S.E. top curb corner, the back side parking lot, Building 15790 Midway Road. Elevation 637.79

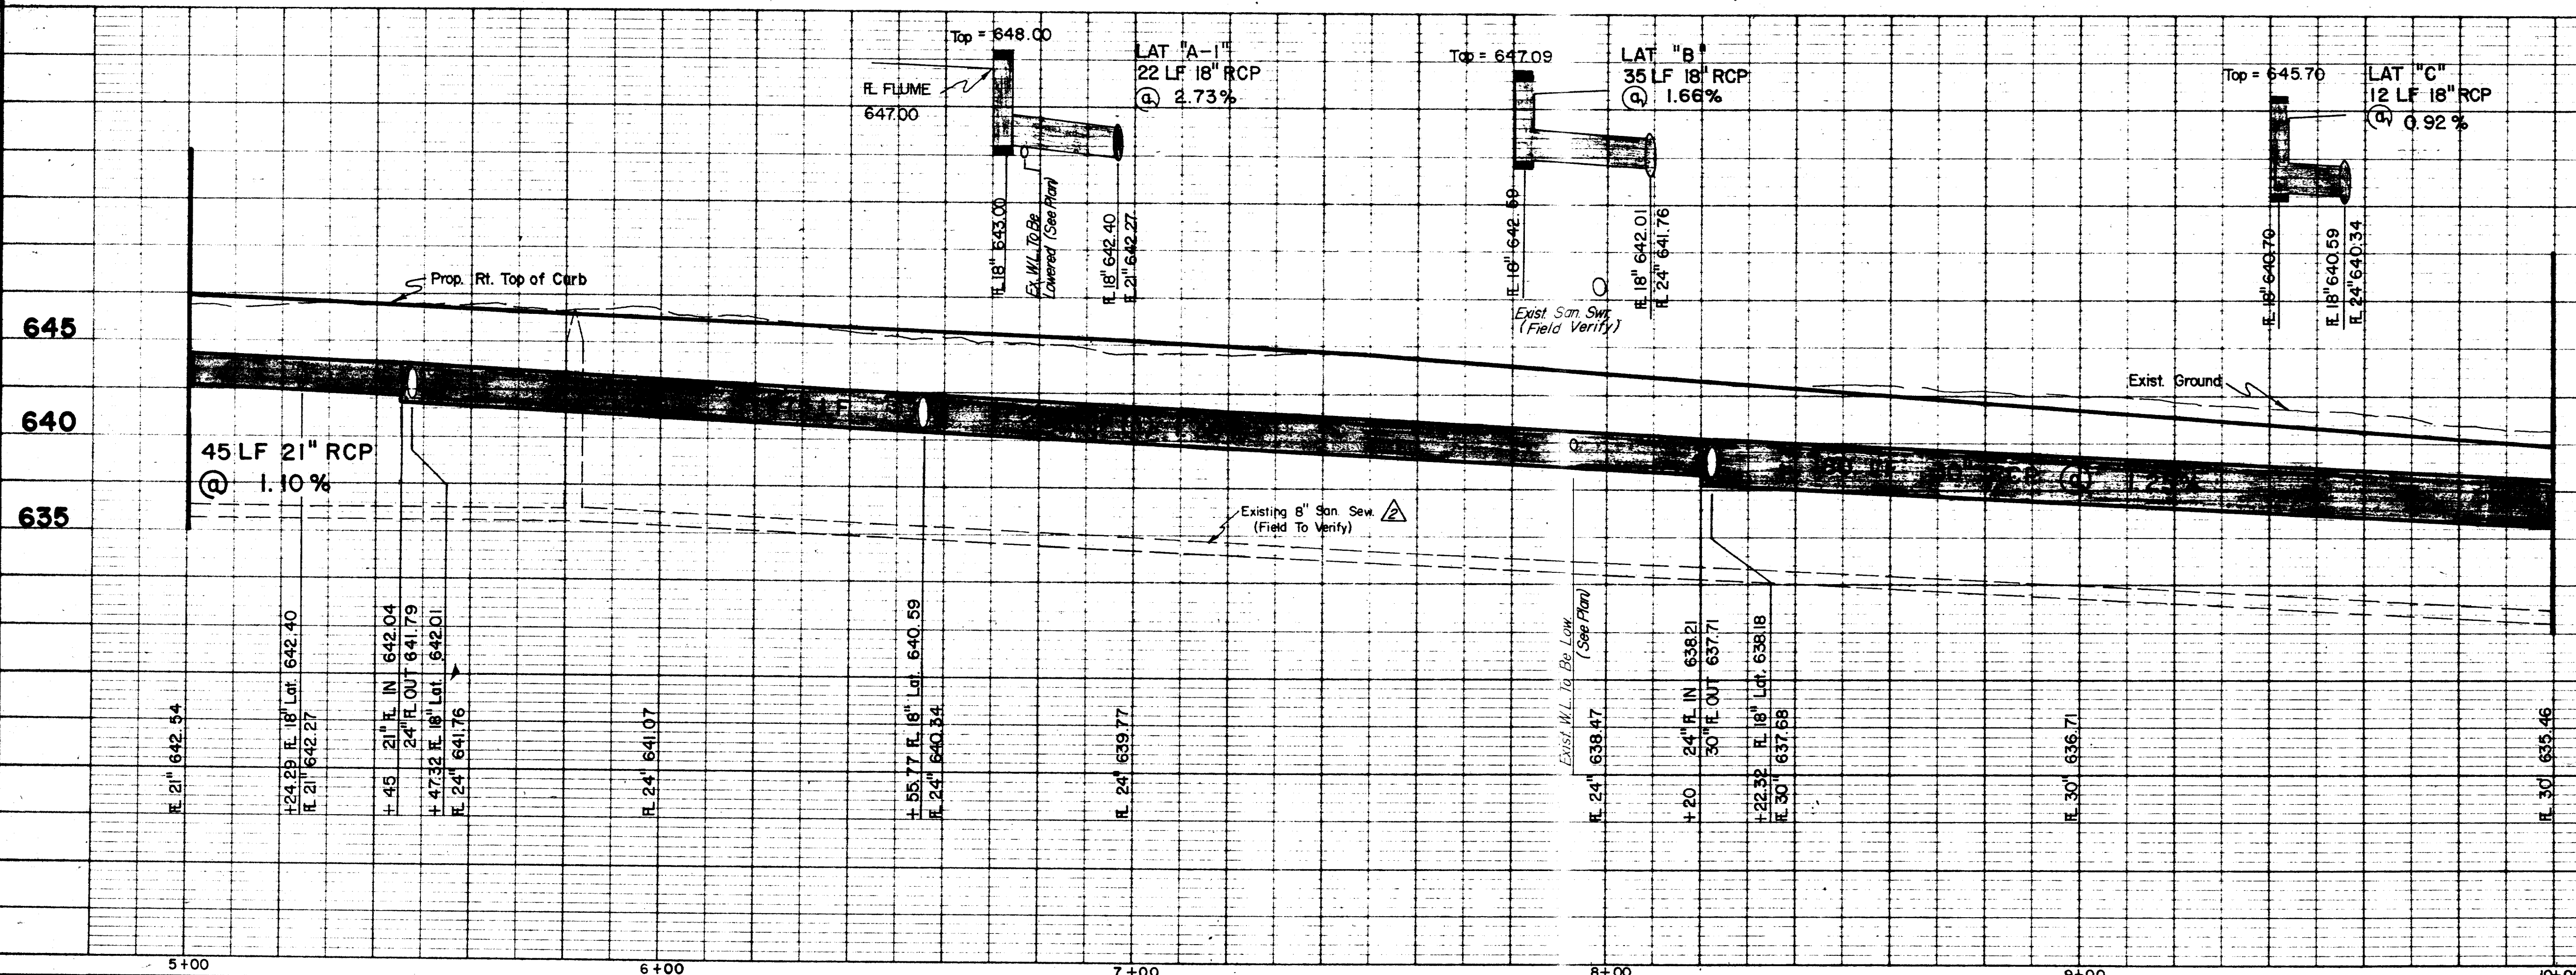

Added Exist. B' San. Sew. to Profile	RLO	10/4/88
Added Exist. Gas Line	RLO	8/18/86
No. _____	By	Date
TOWN OF ADDISON DALLAS COUNTY, TEXAS		
<b>KELLER SPRINGS/DOOLEY RD. IMPROVEMENTS</b>		
<b>DRAINAGE</b>		
DOOLEY RD. STA. 5+00-10+00		
GINN, INC.		
Consulting Engineers Dallas, Texas		
Designed - RLO	Drawn - RLO	Date - JUNE, 1986
Approved - HWG	Checked - JCK	Scale - 1" = 20' H/1" = 5' V
		Job No. - 263
		Sheet 13 Of 30