
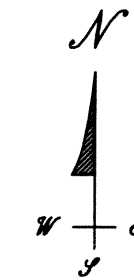


# TOWN OF ADDISON

## KELLER SPRINGS ROAD AND QUORUM DRIVE INTERSECTION IMPROVEMENTS

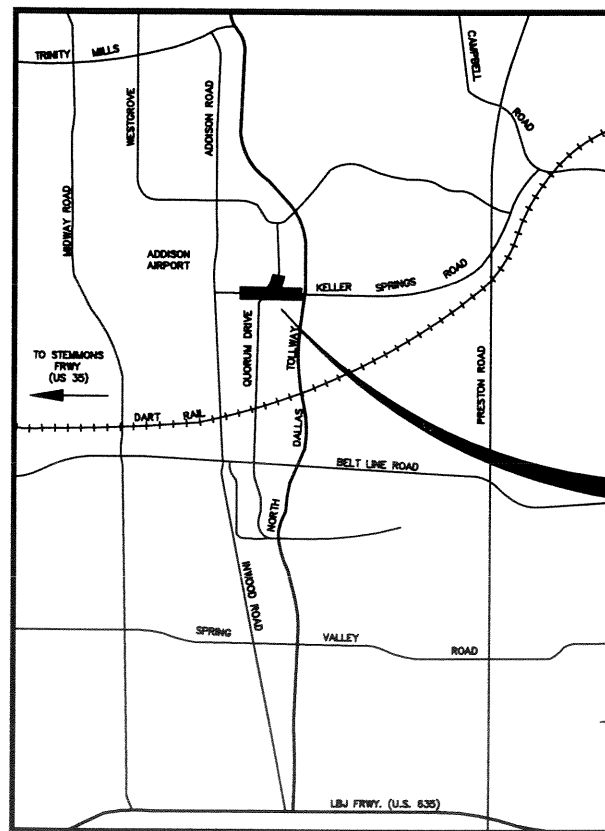

PROJECT  
LOCATION

### SHEET INDEX

- 1A. TRAFFIC CONTROL PLAN PHASES I & II
- 1B. TRAFFIC CONTROL PLAN PHASE III
- 1C. PAVING IMPROVEMENTS STA. 0+00 TO STA. 5+90
2. PAVING IMPROVEMENTS STA. 5+90 TO END
3. GRADING IMPROVEMENTS STA. 0+00 TO STA. 5+90
4. GRADING IMPROVEMENTS STA. 5+90 TO END
5. PAVEMENT MARKINGS STA. 0+00 TO STA. 5+90
6. PAVEMENT MARKINGS STA. 5+90 TO END
7. CROSS SECTIONS STA. 0+50 TO STA. 4+10
8. CROSS SECTIONS STA. 4+50 TO STA. 8+00
9. CROSS SECTIONS STA. 8+50 TO STA. 10+00
10. MISCELLANEOUS DETAILS - SHEET 1
11. MISCELLANEOUS DETAILS - SHEET 2
12. INTERSECTION LAYOUT
13. INTERSECTION LAYOUT TABLES
14. TRAFFIC SIGNAL HEADS DETAIL SHEET
15. TRAFFIC SIGNAL POLE FOUNDATIONS DETAIL SHEET
16. CONTROLLER FOUNDATION AND GROUND BOX INSTALLATION DETAIL SHEET
17. SERVICE POLE AND GROUNDING DETAIL SHEET
18. TRANSFORMER BASE DETAIL SHEET
19. TRAFFIC CONTROL PLAN - SHEET 1 OF 2
20. TRAFFIC CONTROL PLAN - SHEET 2 OF 2

### CONSTRUCTION SET

ISSUED BY  
TOWN OF ADDISON  
PUBLIC WORKS DEPARTMENT

NAME: Jeffrey DATE: 9-8-99



1999



Delvin Black  
Date: 14 Apr 99

AS-BUILTS  
7/10/2000

JIM BOWMAN CONST. CO., INC.  
(214) 349-2884

FF-9