
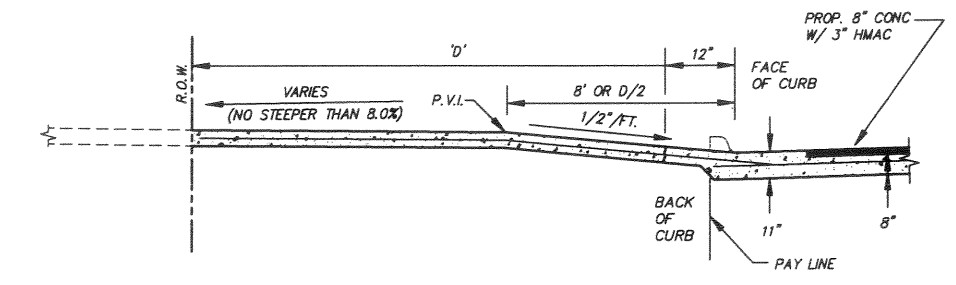
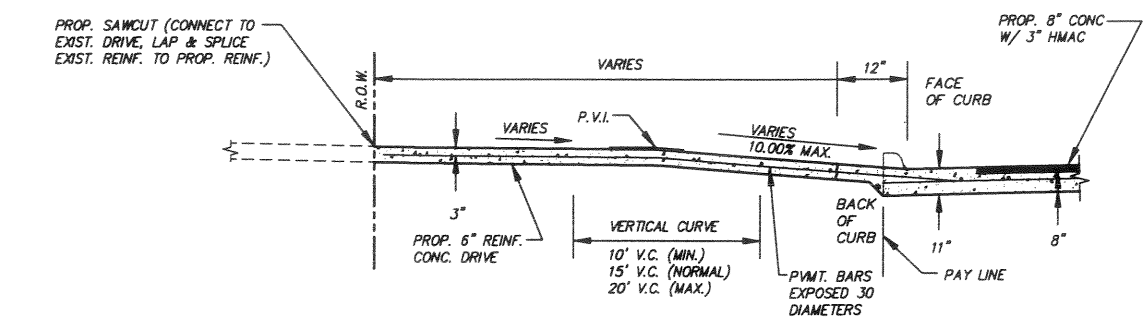
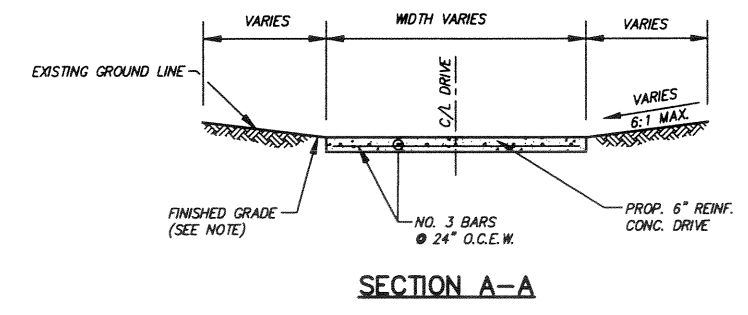
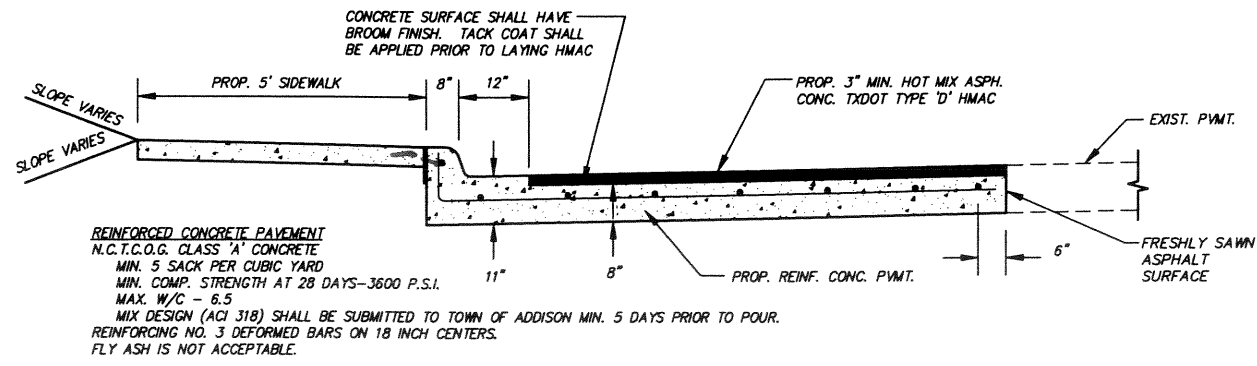
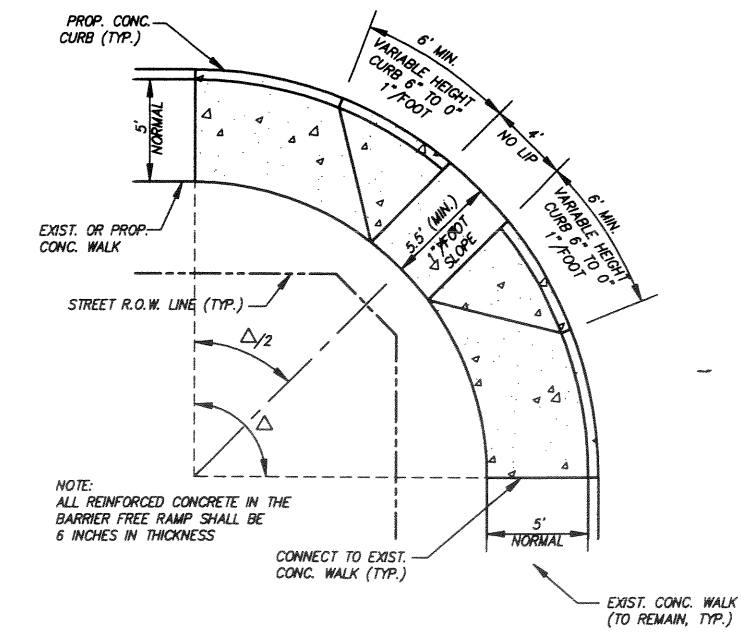
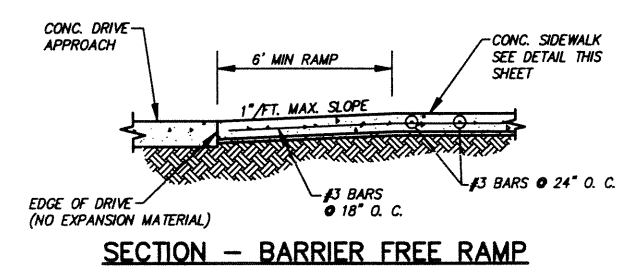


*S.W. Davelle to curb w/ #3 x 12" @ 24" c-c*

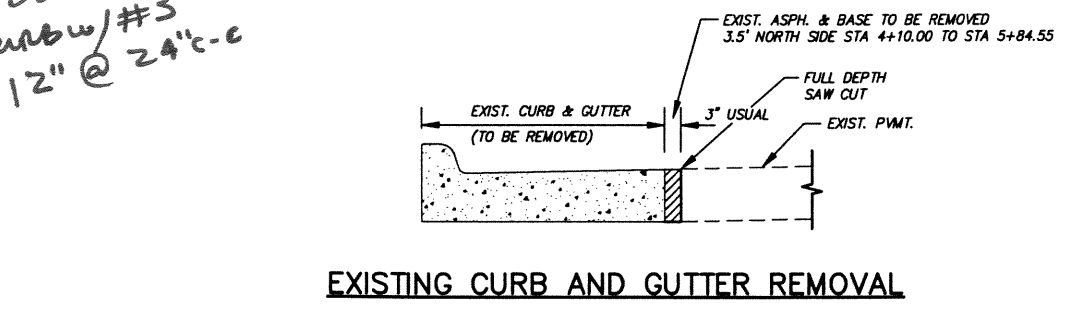

**BARRIER FREE RAMP AT STREET INTERSECTION**

**SECTION B-B (TYPE 1 ENTRANCE)**

**SECTION B-B (TYPE 2 ENTRANCE)**

**DRIVEWAY RETURN SECTIONS**

*As-Built*

NO.	REVISION	BY	DATE

DEB DESIGNED  
JPS DRAWN  
JRP CHECKED

TOWN OF ADDISON

SCALE	HORIZ N/A	VERT N/A	DATE
			APR 1999

**TEAGUE NALL AND PERKINS**  
INC. CONSULTING ENGINEERS

915 Florence Street Fort Worth, Texas 76102 (817) 336-5773

2001 West Irving Blvd. Irving, Texas 75061 (972) 254-1765

STATE OF TEXAS REGISTERED PROFESSIONAL ENGINEER DELVIN BLACK 31640

*Delvin Black*  
Date: 14 Apr 99

TOWN OF ADDISON, TEXAS  
KELLER SPRINGS ROAD/QUORUM DRIVE  
INTERSECTION IMPROVEMENTS  
MISCELLANEOUS DETAILS  
SHEET 1