


NOTE:  
 THE CONCRETE MIX USING TYPE III CEMENT SHALL BE DESIGNED TO ALLOW THE SECTION TO BE OPENED TO TRAFFIC AFTER A MAXIMUM CURE TIME OF 12 HOURS.

**TYPICAL PAVEMENT SECTION**

SCALE: HOR. 1/4" = 1'  
 VERT. 1" = 1'

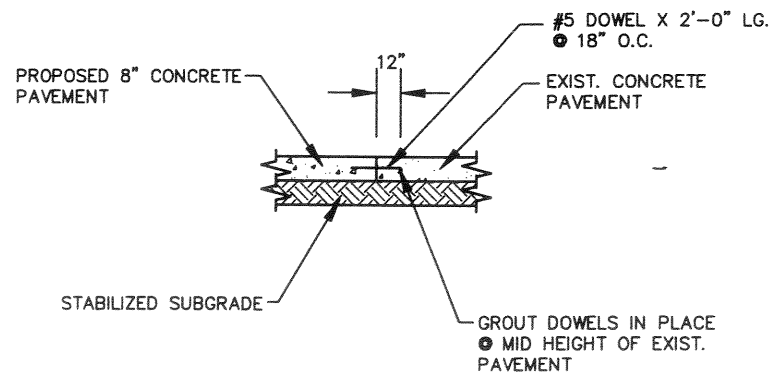

**CONSTRUCTION JOINT TO EXISTING CONCRETE PAVEMENT**

SCALE: 1/4" = 1'

*As-Built*


NO.	REVISION	BY	DATE

DESIGNED: DEB  
 DRAWN: JPS  
 CHECKED: JRP

TOWN OF ADDISON

SCALE: AS SHOWN  
 DATE: APR 1999

**TEAGUE NALL AND PERKINS**  
 CONSULTING ENGINEERS  
 915 Florence Street Fort Worth, Texas 76102 (817) 336-5773  
 2001 West Irving Blvd Irving, Texas 75061 (972) 254-1765

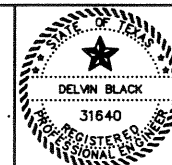

Date: 14 Apr 99

TOWN OF ADDISON, TEXAS  
 KELLER SPRINGS ROAD/QUORUM DRIVE  
**INTERSECTION IMPROVEMENTS**  
 MISCELLANEOUS DETAILS  
 SHEET 2

TWP PROJ. ADD9727  
 SHEET 11 OF 20