

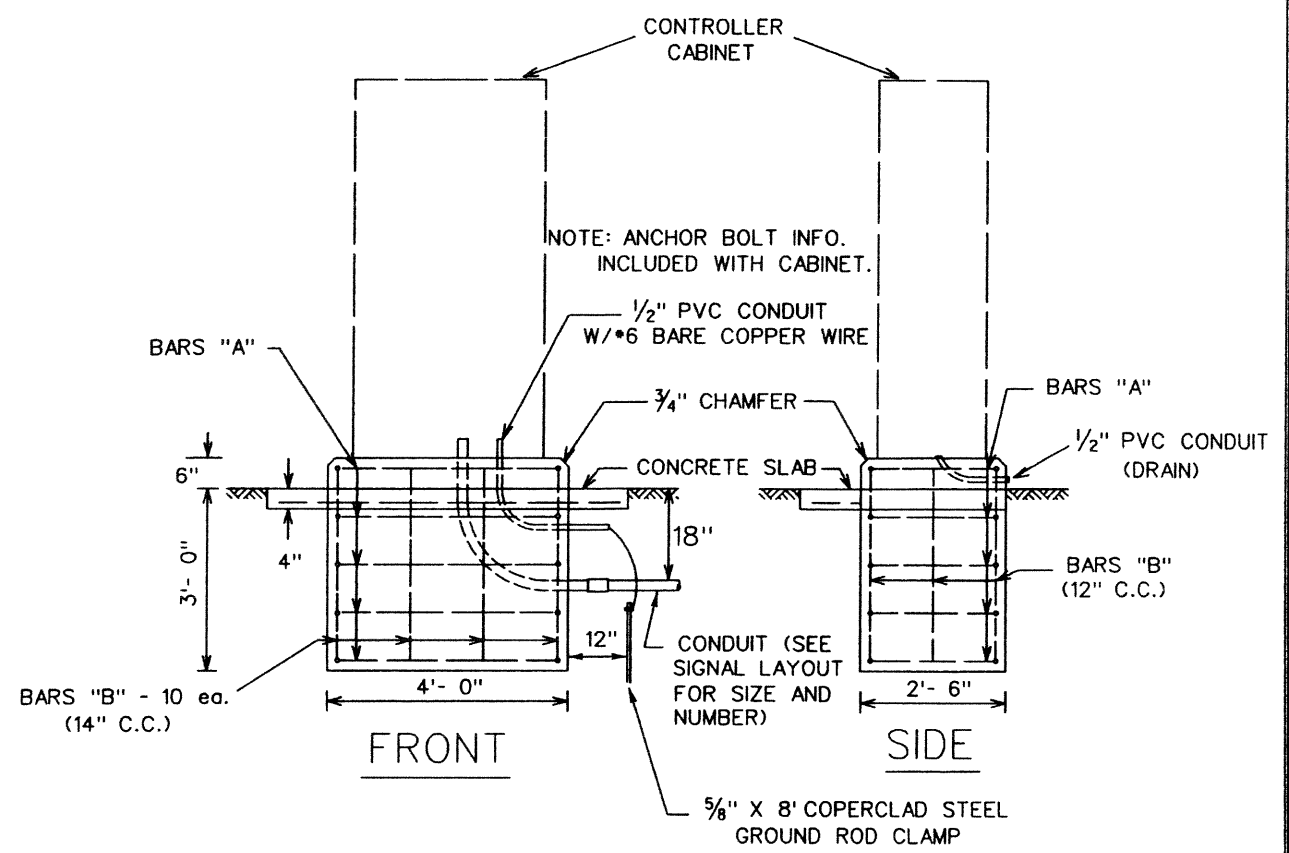
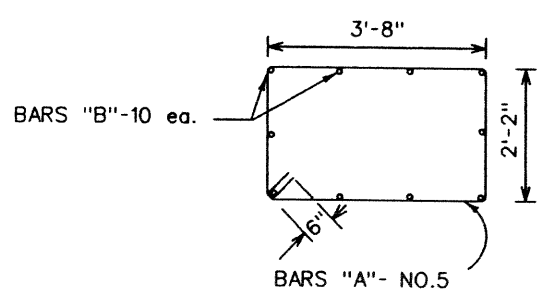


BAR	NO. BARS	SIZE	LENGTH	SPACING
A	6	5	12'-8"	9.5" C.C.
B	10	5	3'-2"	VAR.
C	2	3	4'-8"	16.5" C.C.
D	2	3	5'-8"	18" C.C.
E	3	3	2'-8"	16.5" C.C.
F	4	3	1'-2"	18" C.C.

PROVIDE 2" MIN. COVER FOR TOP AND SIDES

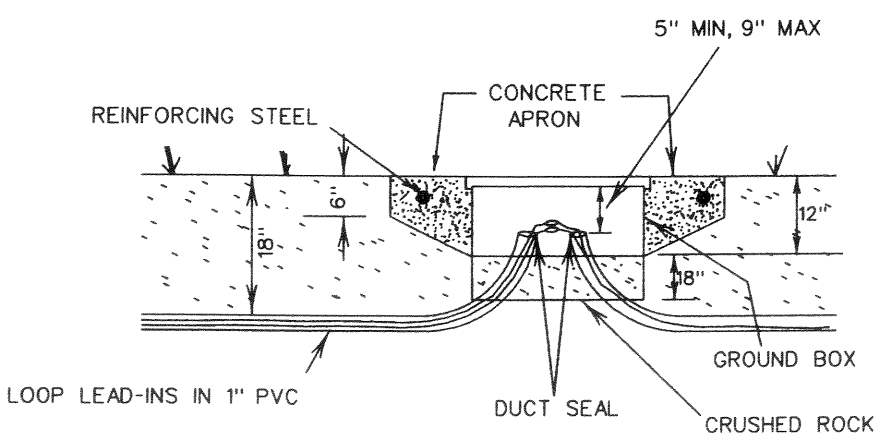

CONTROLLER FOUNDATION DETAILS

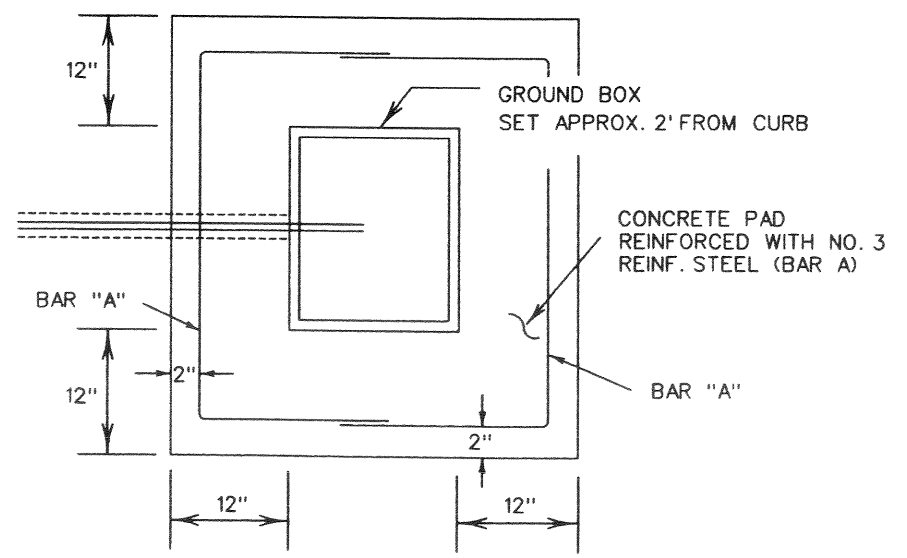

PLAN

ELEVATION

GROUND BOX INSTALLATION DETAILS

As-Built

SCOTT C. BOOKER
74759
REGISTERED PROFESSIONAL ENGINEER

DATE: 8-21-98

DATE	REVISION	BY
TOWN OF ADDISON DALLAS COUNTY, TEXAS		
DETAIL SHEET CONTROLLER FOUNDATION AND GROUND BOX INSTALLATION		
PROJECT No.		
PARSONS TRANSPORTATION GROUP <small>2630 W. FREEWAY #132 • FORT WORTH, TEXAS 76102 • (817) 877-5803</small>		
DESIGNED :	S.C.B.	DRAWN : C.W.W. FILE : DET-55
APPROVED :	R.W.J.	CHECKED : A.M. SHEET 16 OF 20