

As-Built


NO.	REVISION	BY	DATE

DESIGNED
DEB
DRAWN
JPS
CHECKED
JRP

TOWN OF
ADDISON

SCALE
HORIZ
1"=50'
VERT
N/A
DATE
APR 1999

TEAGUE NALL AND PERKINS
CONSULTING ENGINEERS
915 Florence Street
Fort Worth, Texas 76102
(817) 336-5773
2001 West Irving Blvd.
Irving, Texas 75061
(972) 254-1765

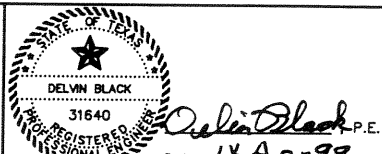

TOWN OF ADDISON
KELLER SPRINGS ROAD/QUORUM DRIVE
PAVING IMPROVEMENTS
TRAFFIC CONTROL PLAN
PHASE III

TMP PROJECT
ADD 9727
SHEET
1B
OF