

TWO ROWS TYPE 1 C RAISED PAVEMENT MARKER TO BE PLACED 200 mm APART ON 900 mm CENTERS

100 mm WHITE REFLECTIVE STRIPE

MATCH EXISTING PAVEMENT STRIPING

COMMERCIAL TYPE BARRIER FREE RAMPS (TYP.)

CROSSWALK 300 mm WHITE REFLECTIVE STRIPE

MARSH LN.

STOP BAR 600 mm WHITE REFLECTIVE STRIPE

TWO ROWS TYPE 1 C RAISED PAVEMENT MARKER TO BE PLACED 200 mm APART ON 900 mm CENTERS

1.5 m WIDE x 100 mm THICK REINFORCED CONCRETE SIDEWALK

100 mm SOLID YELLOW REFLECTIVE STRIPE

100 mm SOLID WHITE REFLECTIVE STRIPE

COMMERCIAL TYPE BARRIER FREE RAMPS (TYP.)

100 mm WHITE REFLECTIVE STRIPE ON 3.048 m CENTERS

1.5 m WIDE x 100 mm THICK REINFORCED CONCRETE SIDEWALK


BUTTON THRU LANES

LANE LINES, TYPE W TRAFFIC BUTTONS WITH TYPE 1 C RAISED PAVEMENT MARKERS SPACED PER PM3-92



CHANGE ORDER NO. 3 MAY 22, 1998 - OMIT LEFT TURN LANE AND BUTTONS

NOTE: DIMENSIONS ARE TO BACK OF CURB.

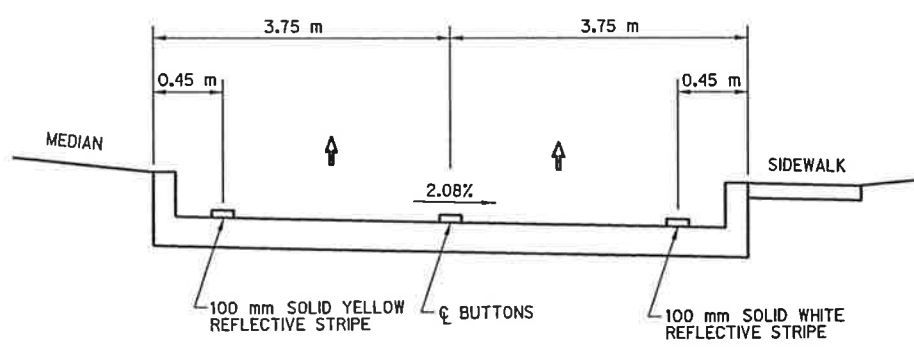

TYPICAL HALF SECTION

- SIDEWALK NOTES:
1. SIDEWALKS SHALL CONFORM TO MISCELLANEOUS DETAILS.
  2. BARRIER FREE RAMPS SHALL BE CONSTRUCTED AT ALL STREET CROSSINGS AND DRIVEWAYS. (NOT A SEPARATE PAY ITEM. AREA WILL BE INCLUDED AND PAID AS SQUARE METER OF SIDEWALK).
  3. BARRIER FREE RAMPS SHALL CONFORM TO MISCELLANEOUS DETAILS.

STRIPING AND SIDEWALK PLAN									
KELLER SPRINGS ROAD									
DALLAS COUNTY, TEXAS									
TEXAS DEPARTMENT OF TRANSPORTATION									
Half Associates									
ENGINEERS - ARCHITECTS - SCIENTISTS - PLANNERS - SURVEYORS									
DESIGN	DRAWN	NOTES	FED. NO.	STATE	FEDERAL AID	PROJECT NO.	SHEET		
			NO.	NO.			NO.		
DATE	FILE	SCALE	STATE	COUNTY	CONTROL	SECTION	JOB	HIGHWAY	
JULY 98	709STP1	1:500 HORIZ	TX	DALLAS	098	48	222	CS	

Handwritten signature and date: M. J. Romanowski 7/7/98