


REFER TO RFI # 919
TUNNEL MAIN 8" UNDERDRAIN PERFORATIONS

1 PLUMBING & FIRE PROTECTION PLAN
SCALE: 1" = 50'

- KEY NOTES:
- 1 EXISTING ELECTRICAL VAULT TO REMAIN.
 - 2 CONNECT 20" PD TO 60"x2" WYE FITTING REFER TO SHEET C40. SEAL CONNECTION WATERTIGHT. I.E. = 627.44'. APPROXIMATE GROUND ELEVATION = 836'. COORDINATE LOCATION OF 20" PD WITH ALL NEW AND EXISTING UTILITIES IN THE AREA PRIOR TO CONSTRUCTION.
 - 3 INCLUDE A #12 COPPER WIRE ALONG ENTIRE LENGTH OF PVC PIPE APPROX. 12" ABOVE TOP OF PIPE AS A LOCATOR.
 - 4 NOT USED.
 - 5 TRANSFORMER BY ELECTRICAL CONTRACTOR.
 - 6 IMBED CONTROL CONDUIT IN CONCRETE ADJACENT TO POWER CONDUITS. REF: SHEET E164 FOR POWER CONDUITS.

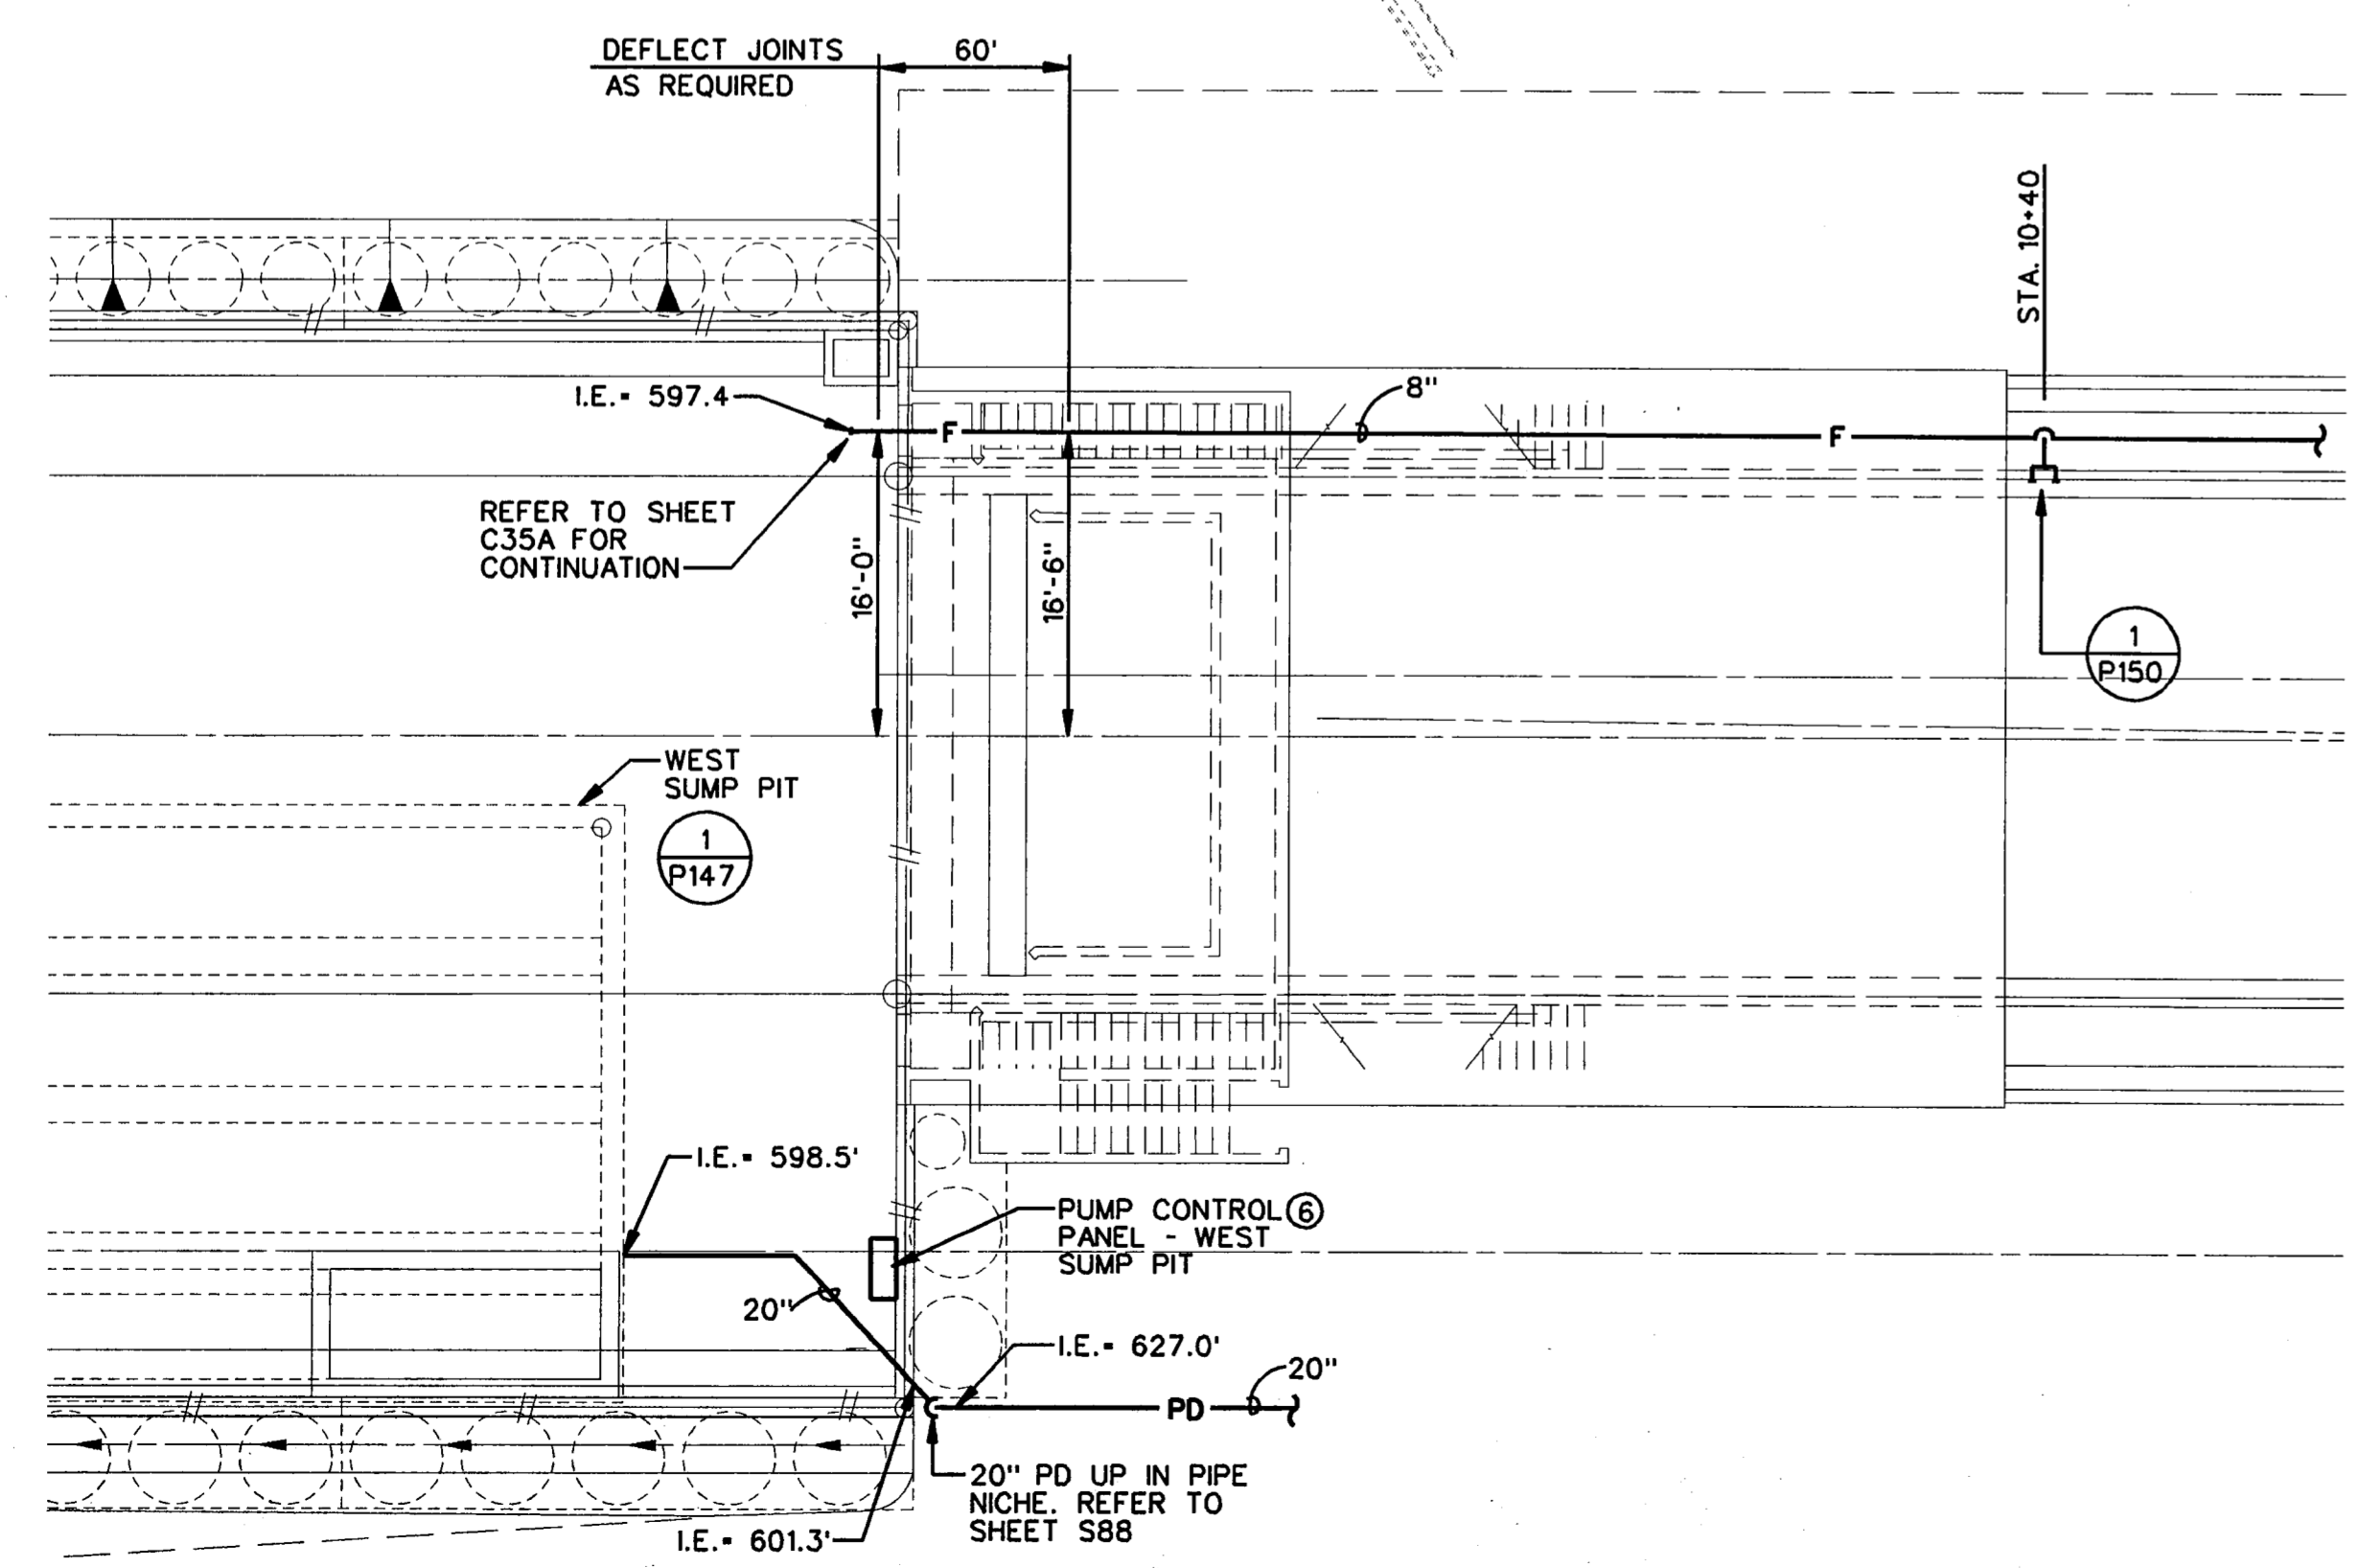

2 ENLARGED PLAN AT WEST PORTAL
SCALE: 1" = 10'

FINAL RECORD
DRAWING
Date: 12/25/99



THE SEAL APPEARING ON THIS DOCUMENT WAS AUTHORIZED BY MIKE L. ASHCRAFT, P.E., 56590 ON SEPTEMBER 9, 1996

2 REVISION PER RFI # 919

ADDENDUM No.1		HDR		2-12-97	
No.	REVISION	BY	DATE		
TEXAS TURNPIKE AUTHORITY ADDISON AIRPORT TUNNEL					
TUNNEL FIRE PROTECTION & PLUMBING PLANS					
HDR HDR Engineering, Inc.				SECTION XIII	
DRAWN: WTD	DATE: 12/05/96	DESIGNED: M.L.A.	DATE: 08/28/96		
CHECKED: BL	DATE: 08/28/96	SCALE: 1" = 50'			
CONTRACT No. DNT-260 SHEET P144 OF 166					

FILE: p:\additun\dgm\cdtup101.dgn
DATE: 23-Apr-96 20:01