


FILE: p:\oddtun\oddtun\dtdup106.dgn
DATE: 23-Apr-96 20:01



GENERAL NOTE:
A. DIMENSIONS FOR NEW PUMP DISCHARGE LINE LOCATION ARE APPROXIMATE. COORDINATE WITH FIELD DETERMINED LOCATIONS OF EXISTING UTILITIES AND WITH ALL NEW WORK.

FINAL RECORD DRAWING
Date: 12/25/99

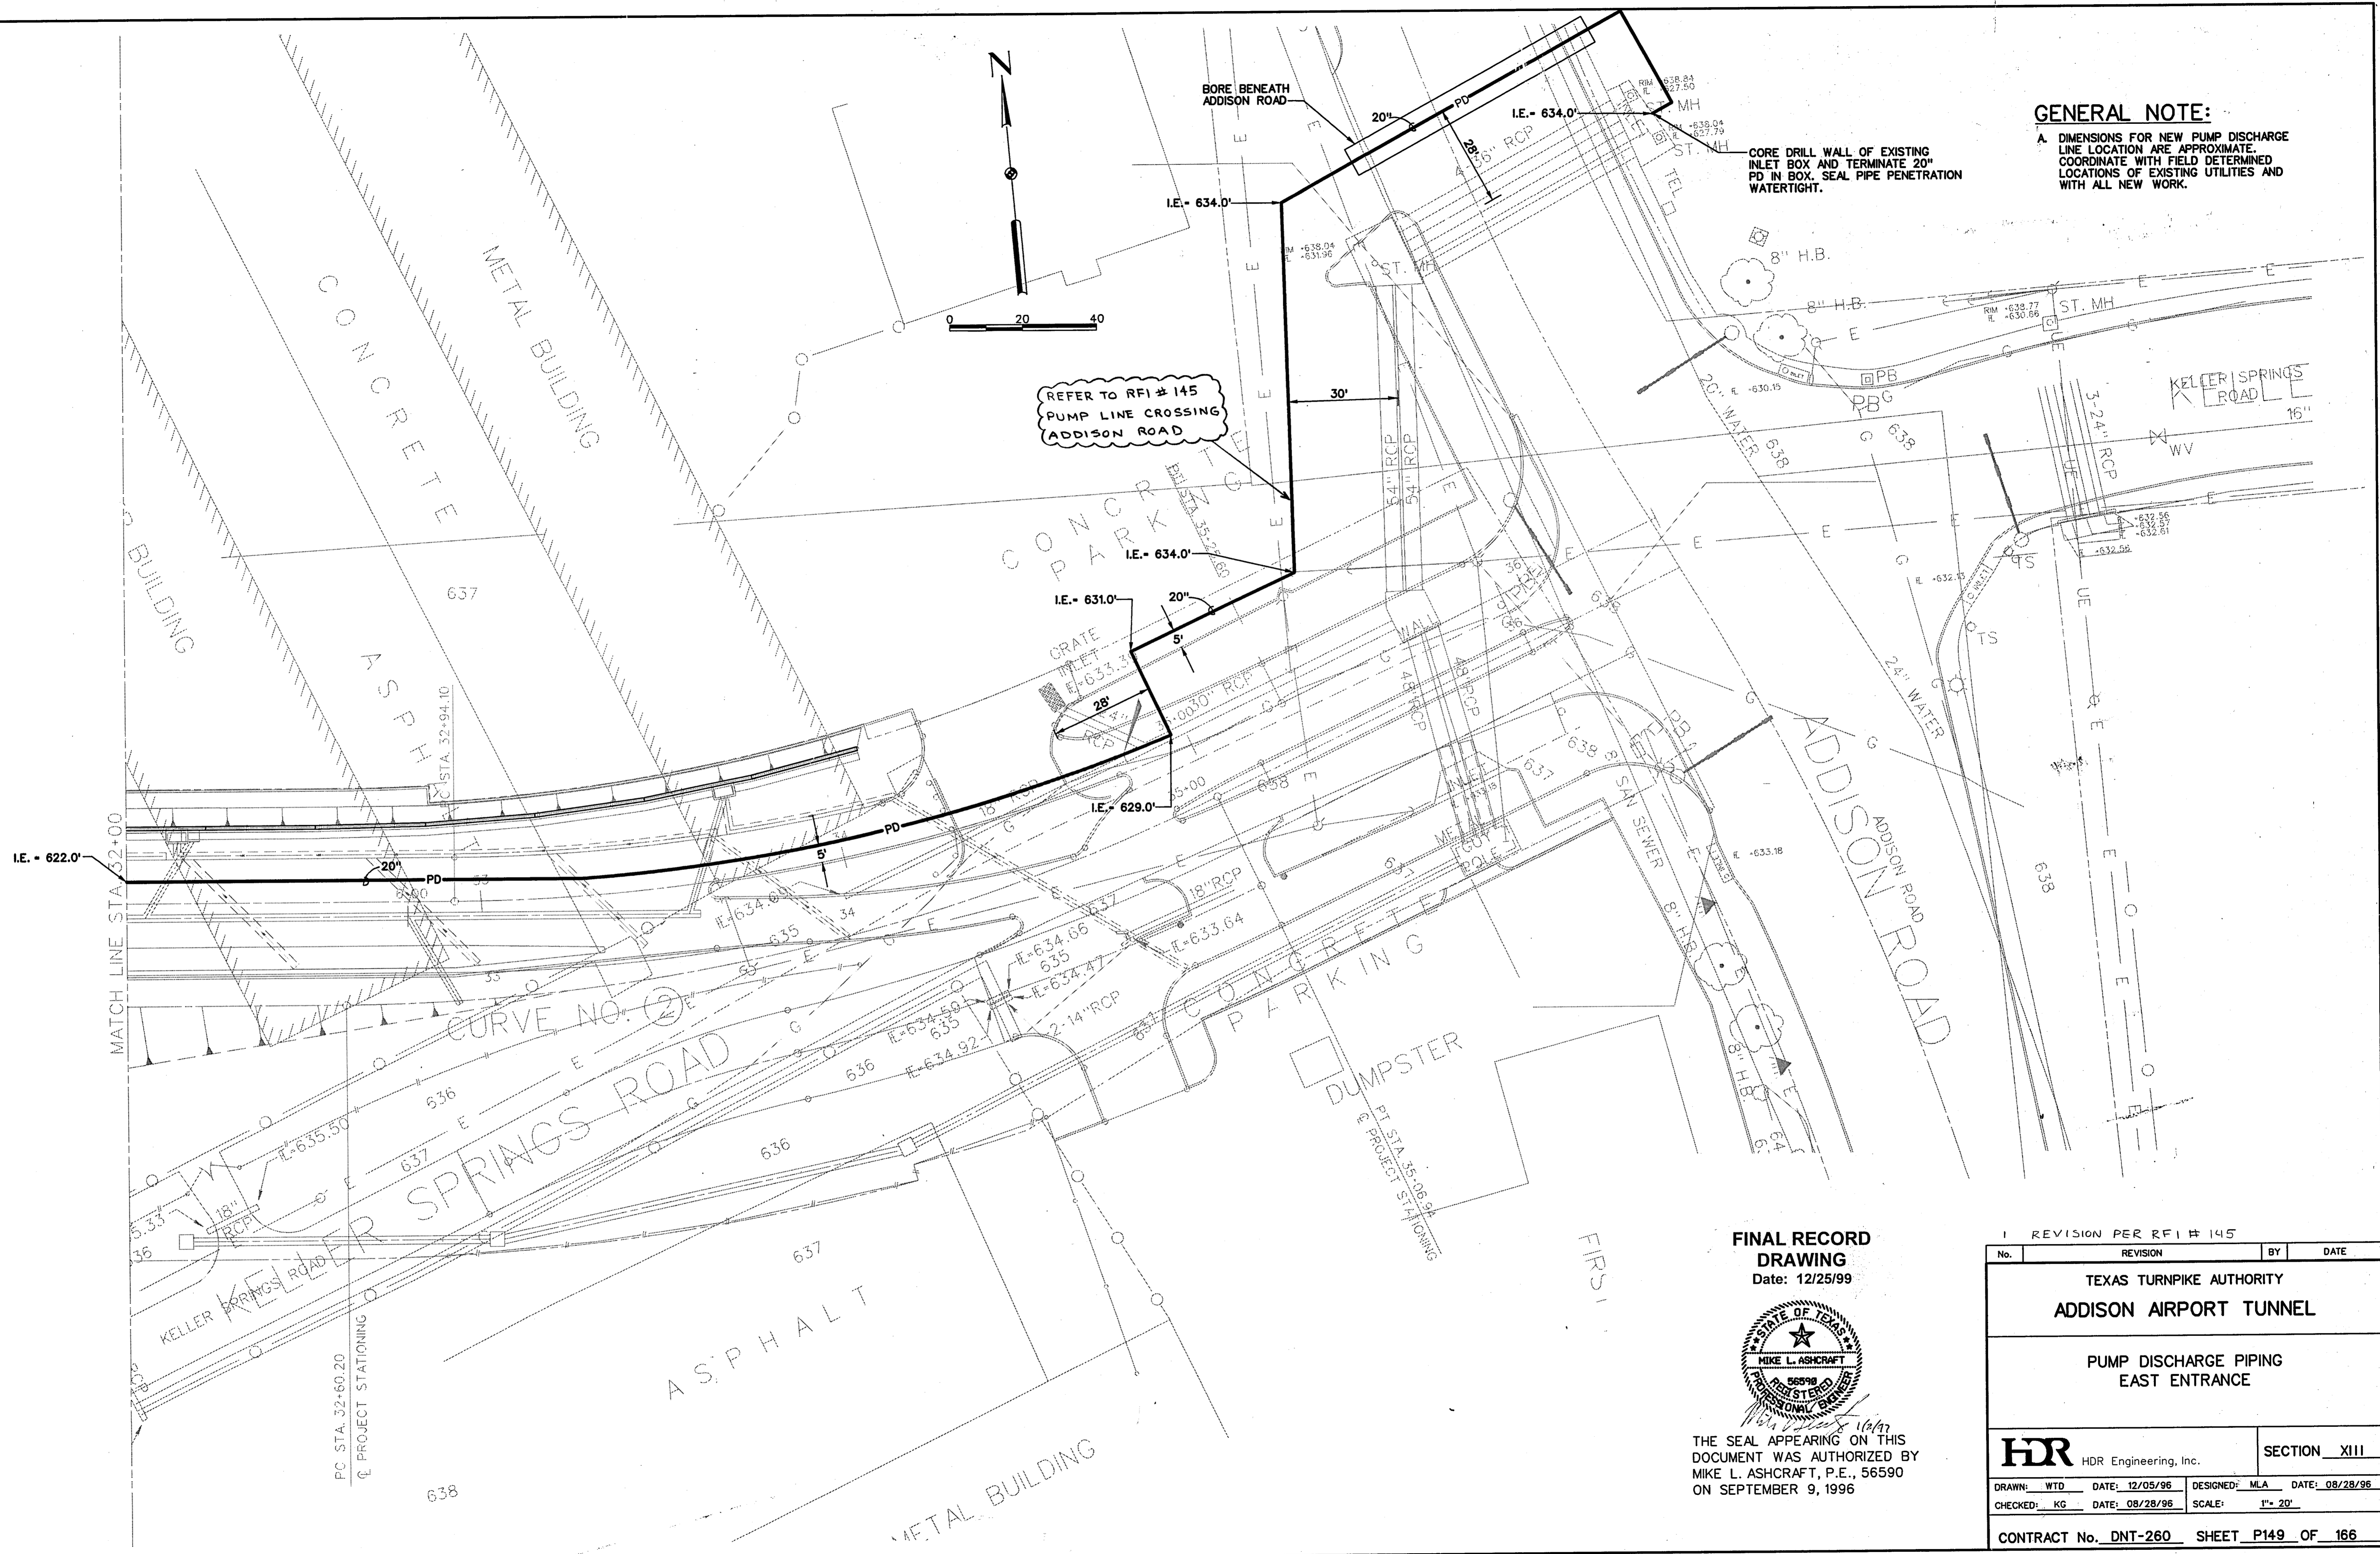

THE SEAL APPEARING ON THIS DOCUMENT WAS AUTHORIZED BY MIKE L. ASHCRAFT, P.E., 56590 ON SEPTEMBER 9, 1996

1 REVISION PER RFI # 145			
No.	REVISION	BY	DATE
TEXAS TURNPIKE AUTHORITY ADDISON AIRPORT TUNNEL			
PUMP DISCHARGE PIPING EAST ENTRANCE			
HDR Engineering, Inc.			SECTION <u>XIII</u>
DRAWN: WTD	DATE: 12/05/96	DESIGNED: MLA	DATE: 08/28/96
CHECKED: KG	DATE: 08/28/96	SCALE:	1" = 20'
CONTRACT No. <u>DNT-260</u> SHEET <u>P149</u> OF <u>166</u>			