




**A** TUNNEL SECTION  
SCALE: 1/4" = 1'-0"

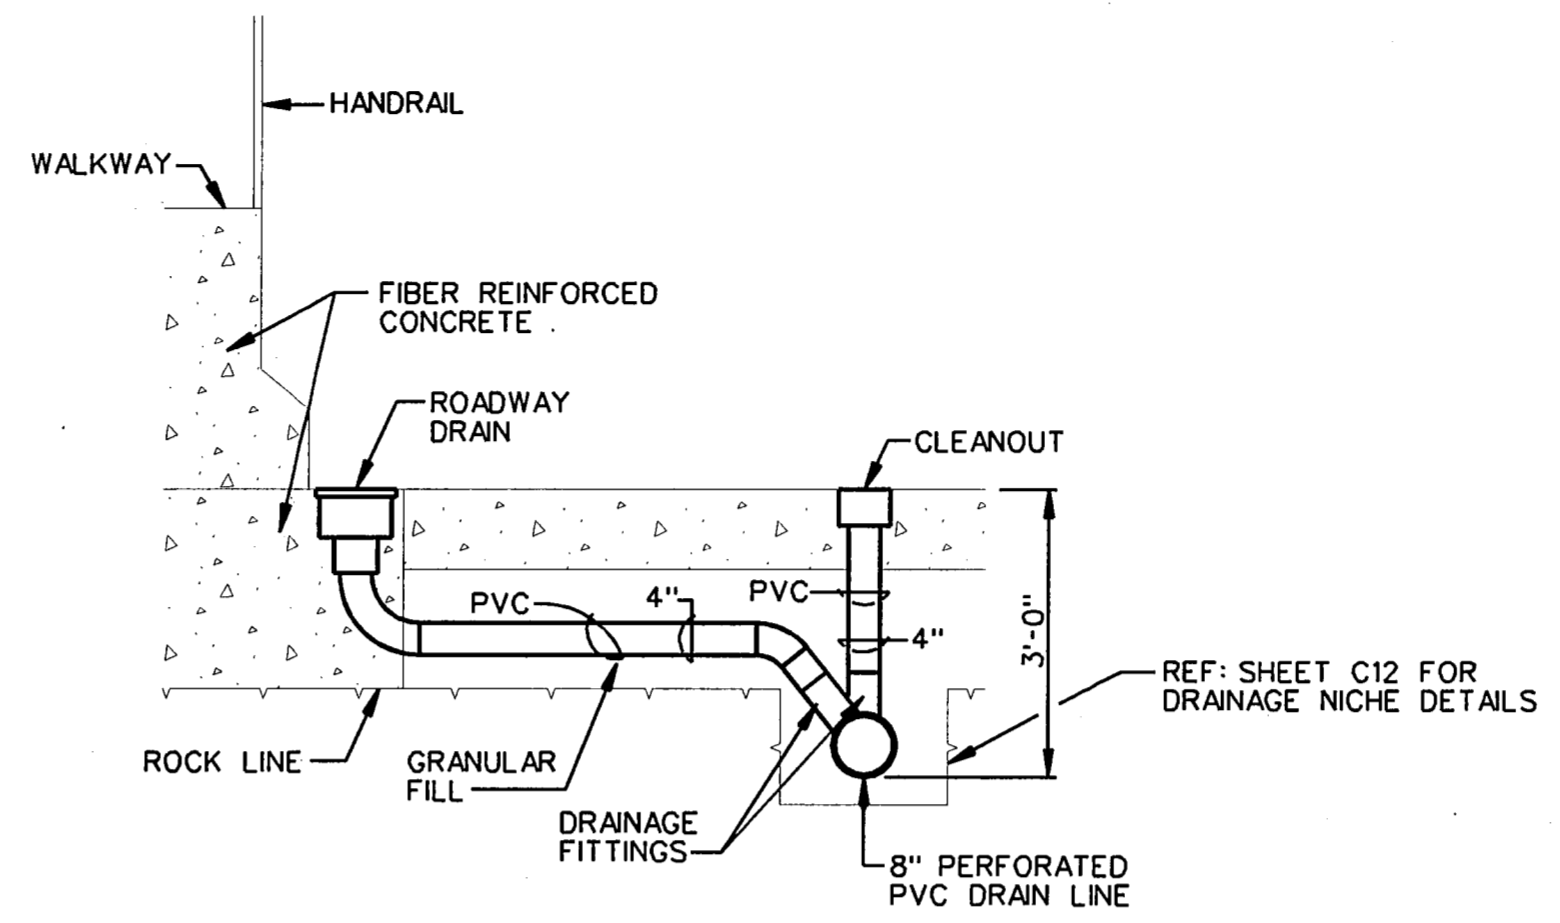


**D** SECTION AT ROADWAY DRAIN  
SCALE: 1" = 1'-0"

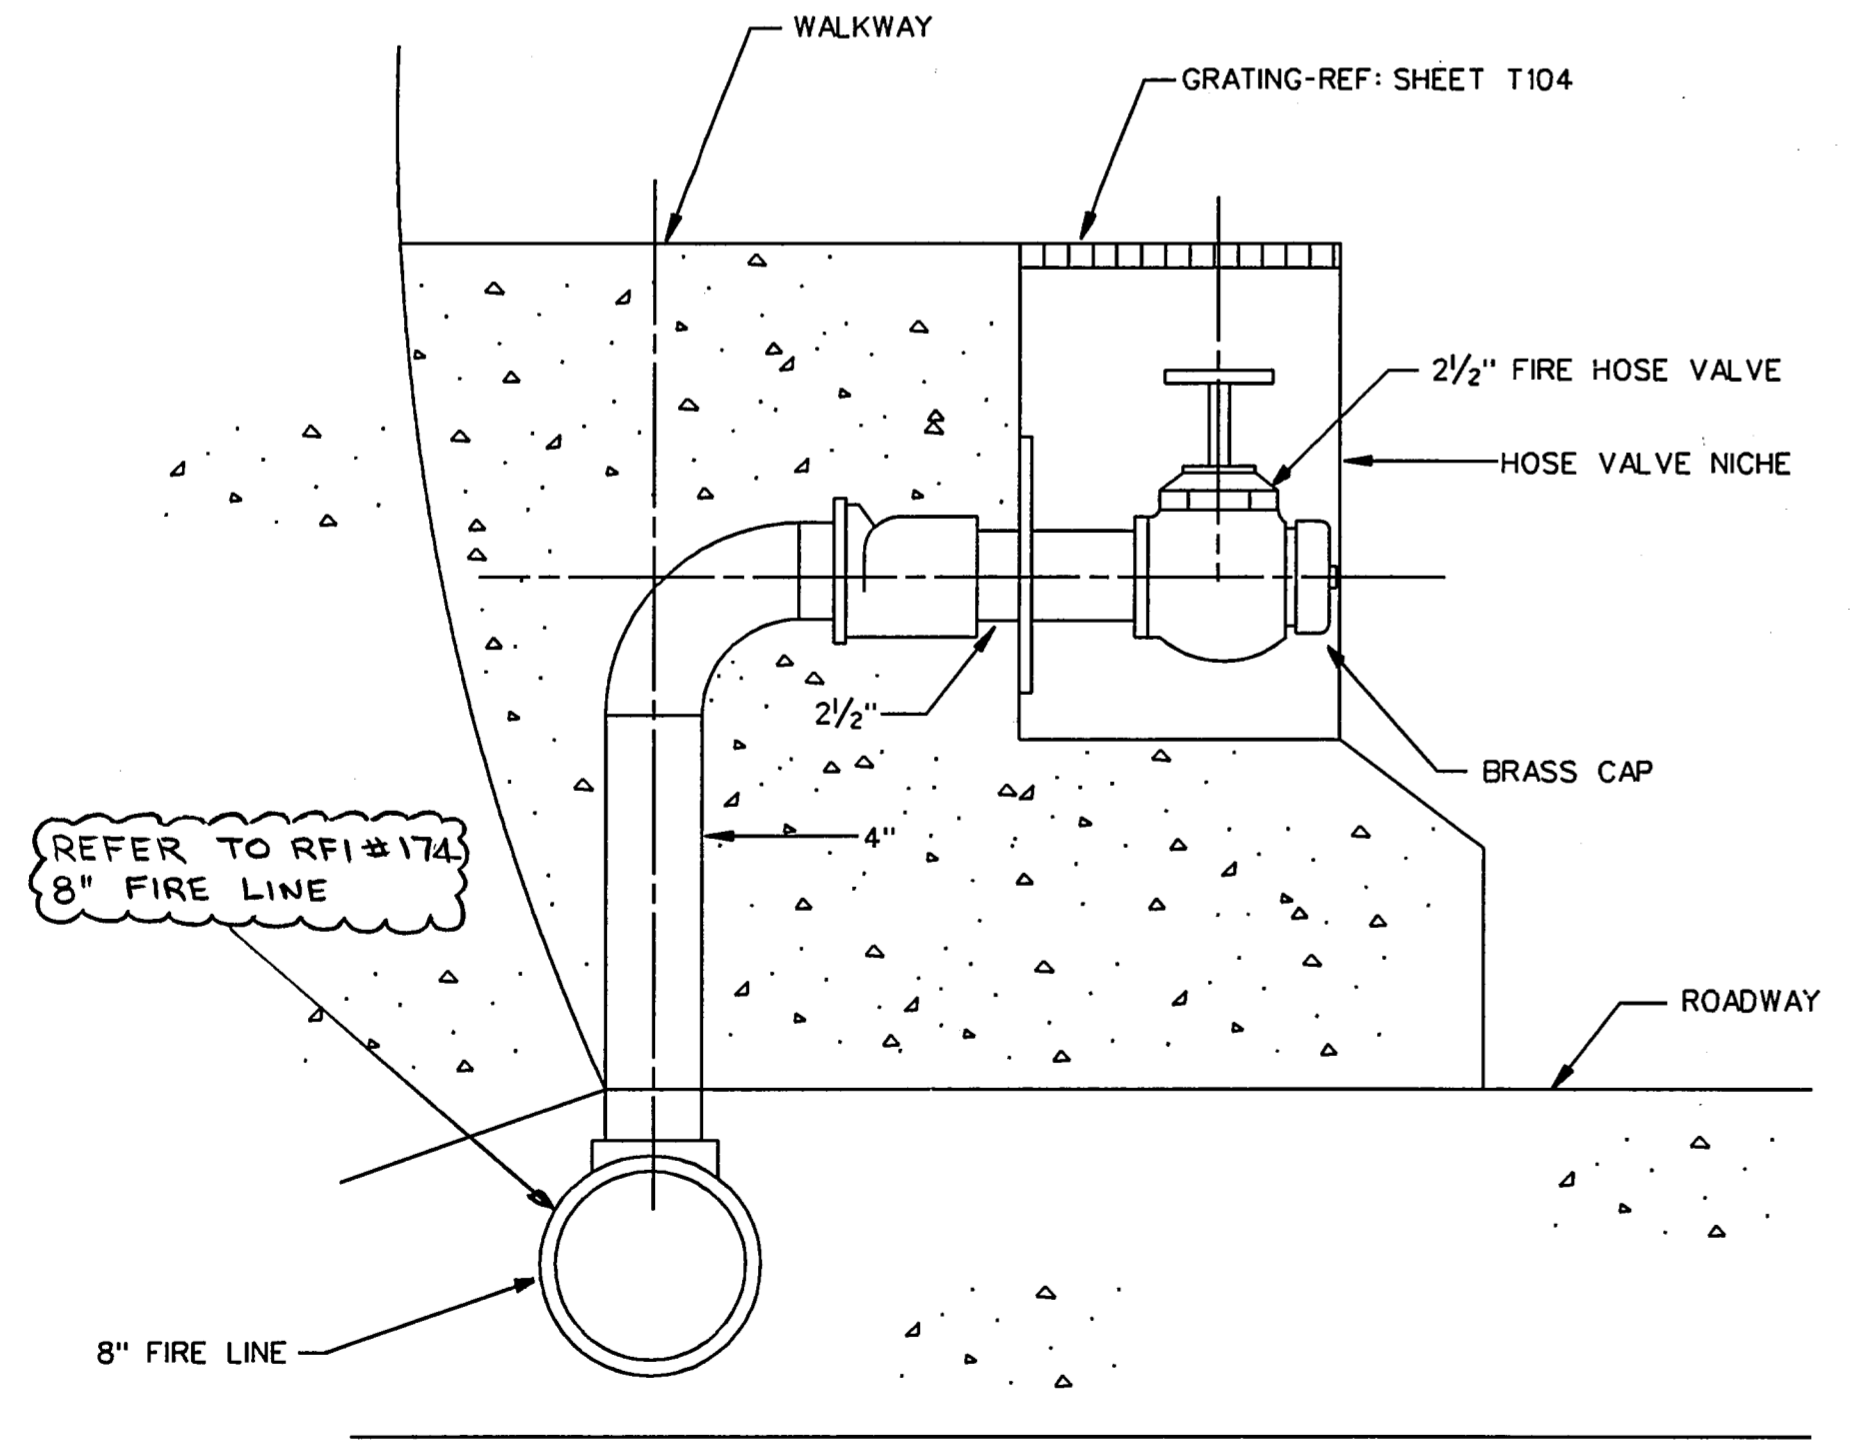

**B** SECTION AT FIRE HOSE VALVE  
SCALE: 1/2" = 1'-0"

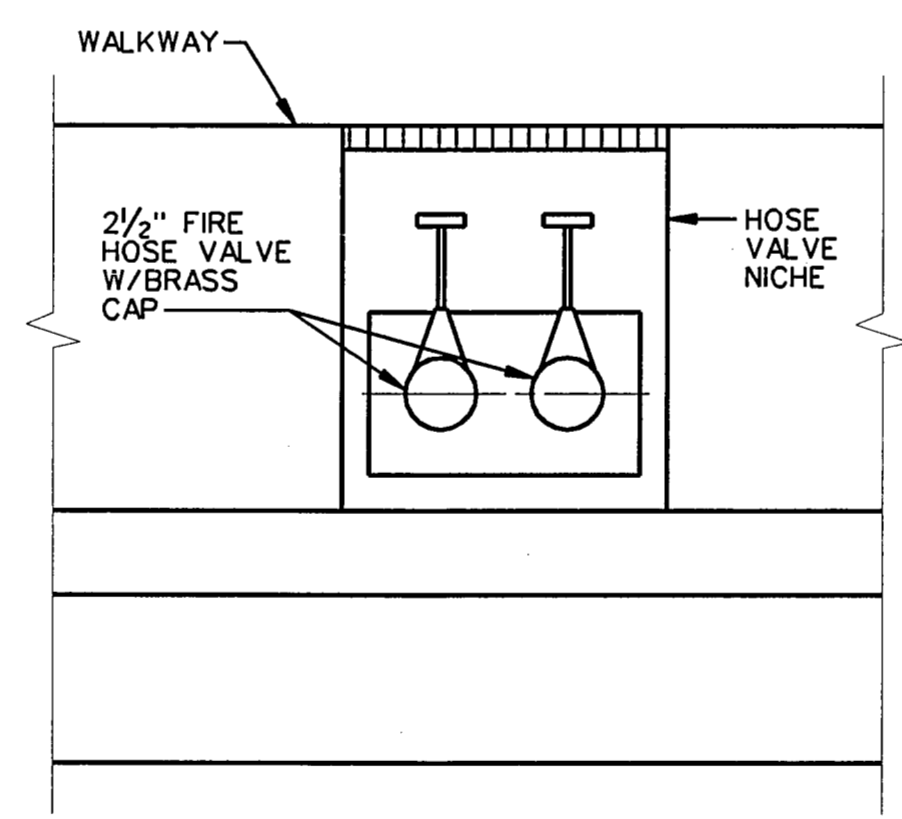

**C** ELEVATION AT FIRE HOSE VALVE  
SCALE: 1/2" = 1'-0"

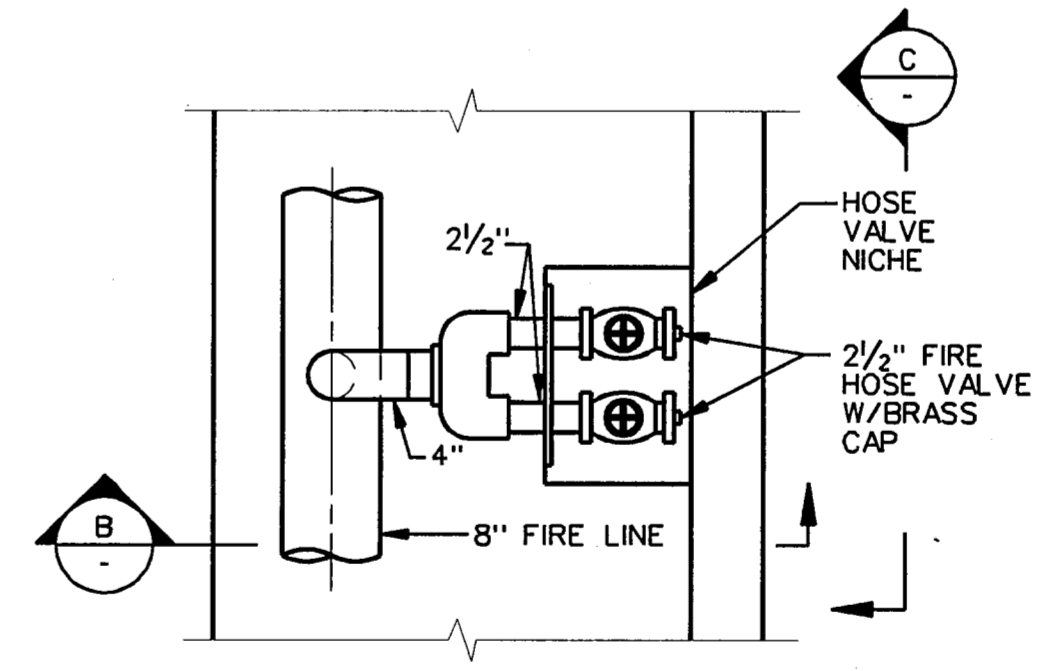

**1** PLAN AT FIRE HOSE VALVE  
SCALE: 1/2" = 1'-0"



THE SEAL APPEARING ON THIS DOCUMENT WAS AUTHORIZED BY MIKE L. ASHCRAFT, P.E., 56590 ON SEPTEMBER 9, 1996

**FINAL RECORD DRAWING**  
Date: 12/25/99

No.	REVISION	BY	DATE
TEXAS TURNPIKE AUTHORITY <b>ADDISON AIRPORT TUNNEL</b>			
TUNNEL FIRE PROTECTION & PLUMBING SECTIONS			
HDR HDR Engineering, Inc.			SECTION XIII
DRAWN: WTD	DATE: 12/05/96	DESIGNED: MLA	DATE: 08/28/96
CHECKED: BL	DATE: 08/28/96	SCALE: AS SHOWN	
CONTRACT No. DNT-260 SHEET P150 OF 166			

FILE: p:\additun\dgn\aditup07.dgn  
DATE: 23-Apr-96 20:01