


LEGEND:
 (X) SIGN NUMBER
 COSS - CANTILEVER OVERHEAD SIGN STRUCTURE

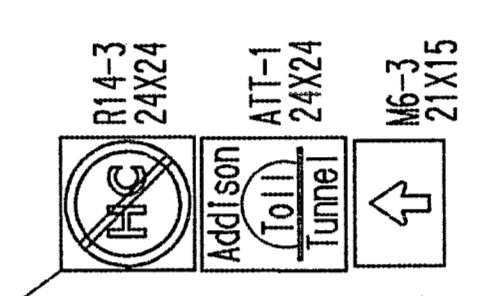

END 4" SOLID WHITE EDGE LINE
 STA. 34+13.90

4" SOLID WHITE EDGE LINES

TY Y TRAFFIC BUTTONS (NON-REF) @ 5' C/C
 W/ TY 11-A-A RPMs (REF) @ 20' C/C, TYP.

150 LF 4" BROKEN WHITE LANE LINE
 W/ RPMs @ 40' C/C, TYP.

KELLER SPRINGS ROAD

ADDISON ROAD

THE SEAL APPEARING ON THIS DOCUMENT WAS AUTHORIZED BY RICHARD K. LAIRD, P.E. NO. 59187 ON JANUARY 12, 1999. ALTERATION OF A SEALED DOCUMENT WITHOUT PRIOR NOTIFICATION TO THE RESPONSIBLE ENGINEER IS AN OFFENSE UNDER THE TEXAS ENGINEERING PRACTICE ACT.

FINAL RECORD DRAWING
 Date: 12/25/99



REVISOR PER RFI # 197, RFI # 200

No.	REVISION	BY	DATE
NORTH TEXAS TOLLWAY AUTHORITY ADDISON AIRPORT TUNNEL			
SIGNING AND PAVEMENT MARKING LAYOUT STA. 33+00 TO ADDISON ROAD			
MATED CONSULTING ENGINEERS, INC. 6540 PETERSON LANE SUITE 225 DALLAS, TEXAS 75240 (972) 233-6700			SECTION XIII
DRAWN SA	DATE 5/97	DESIGNED RKL	DATE 5/97
CHECKED SCF	DATE 5/97	SCALE 1" = 50'	
CONTRACT No. DNT-260 SHEET 10 OF 52			