



EDGE LINES AND LANE LINES FOR DIVIDED HIGHWAYS

Raised pavement markers Type II-C-R, clear face toward normal traffic and red face toward wrong-way traffic, shall be spaced on 80-foot centers. As required by the Engineer or shown elsewhere in the plans, Type II-C-R markers shall be placed on 40-foot centers for the below listed conditions:
 1. Vertical curves with grades over 2 percent and less than 1000 feet long,
 2. horizontal curves,
 3. or continuously illuminated sections.

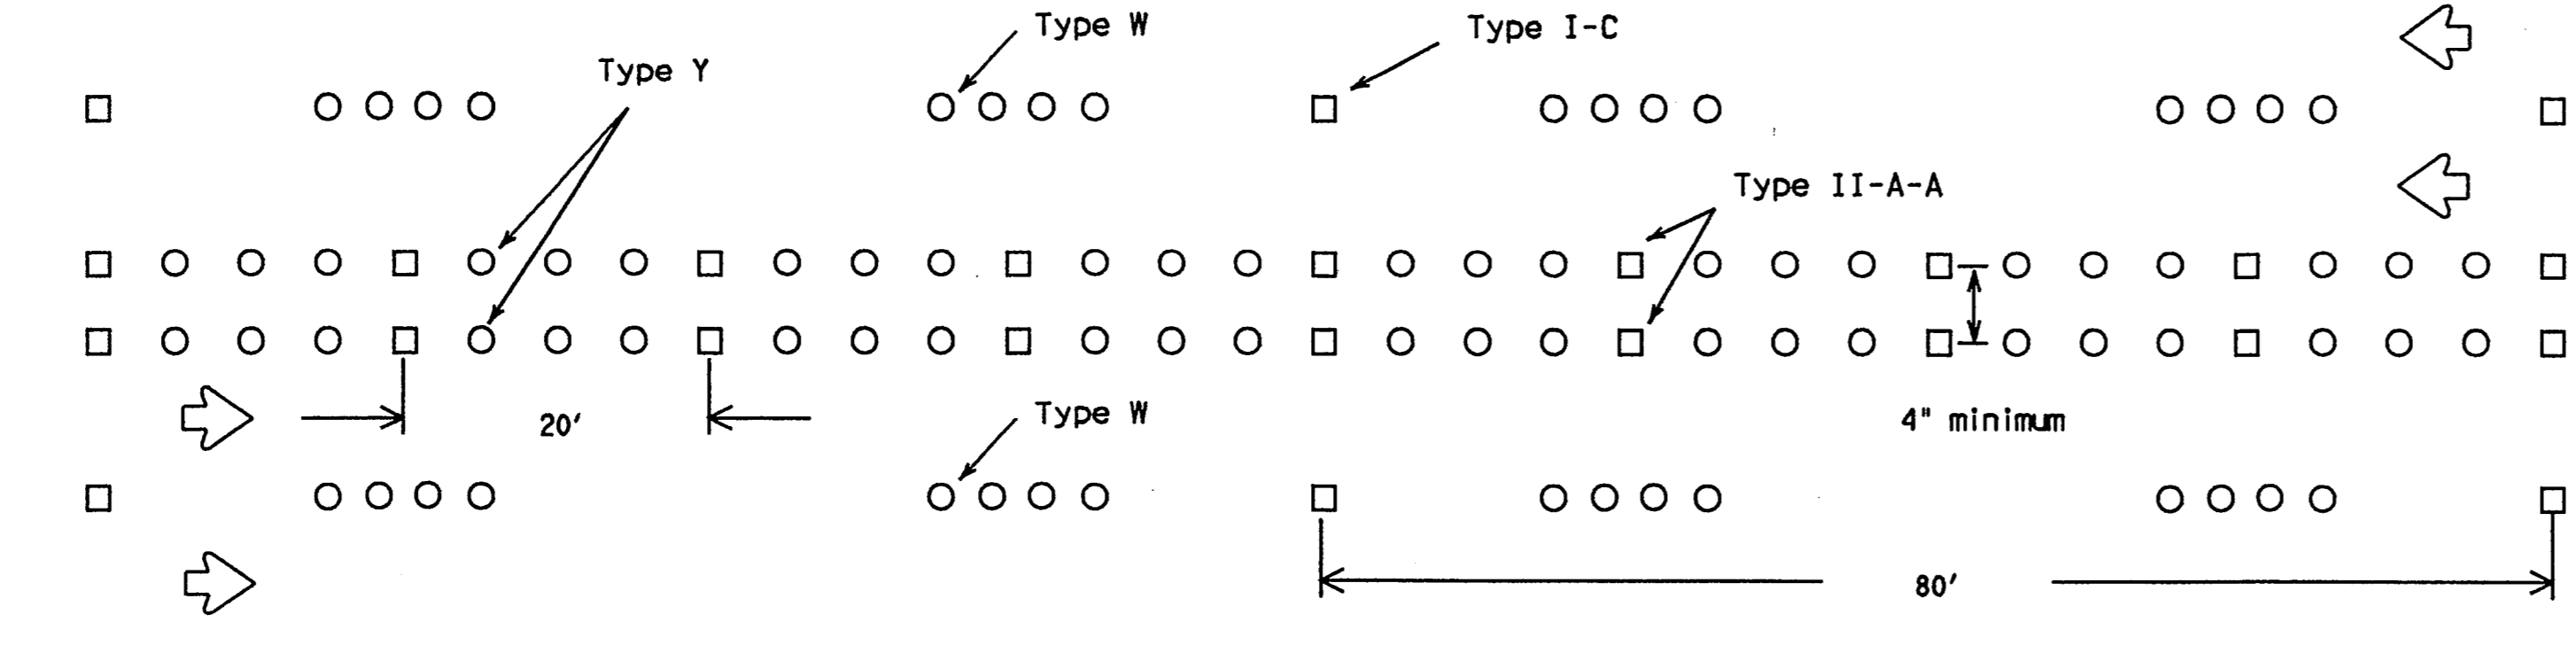

LANE LINES & CENTERLINES FOR MULTI-LANE UNDIVIDED HIGHWAYS

Raised pavement marker Type I-C, clear face toward normal traffic, shall be placed on 80-foot centers.

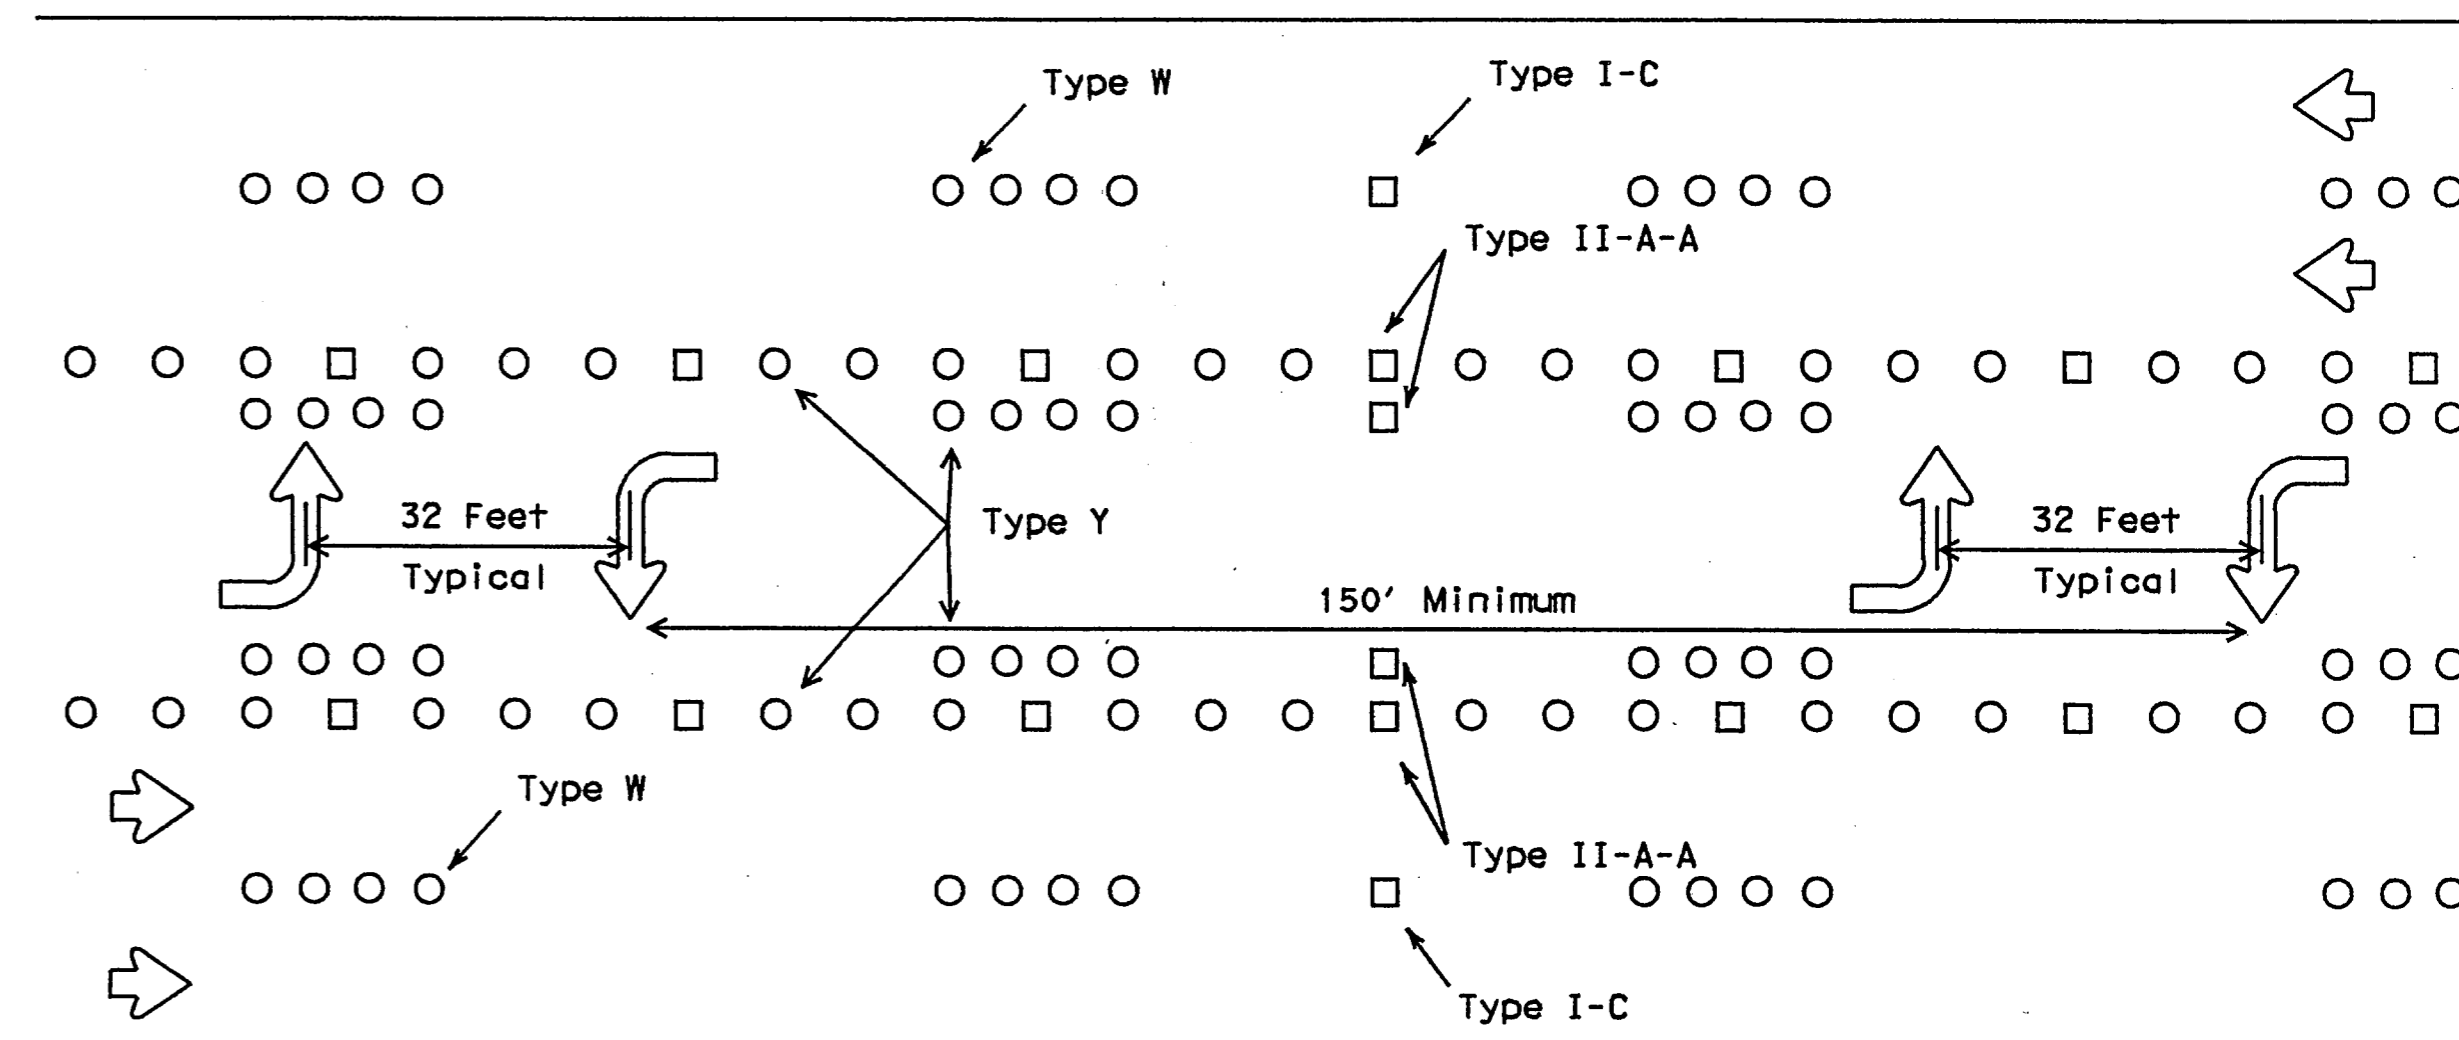


TWO-WAY LEFT TURN LANE


- LEGEND:
- TRAFFIC BUTTON (NONREFLECTORIZED)
 - RAISED PAVEMENT MARKER (REFLECTORIZED)

GENERAL NOTES:

All raised pavement markers placed in broken lines shall be placed in line with and midway between the stripes.
 First and last raised pavement marker in a no-passing line shall be a reflective marker.
 On concrete pavements, the raised pavement markers should be placed to one side of the longitudinal joints.

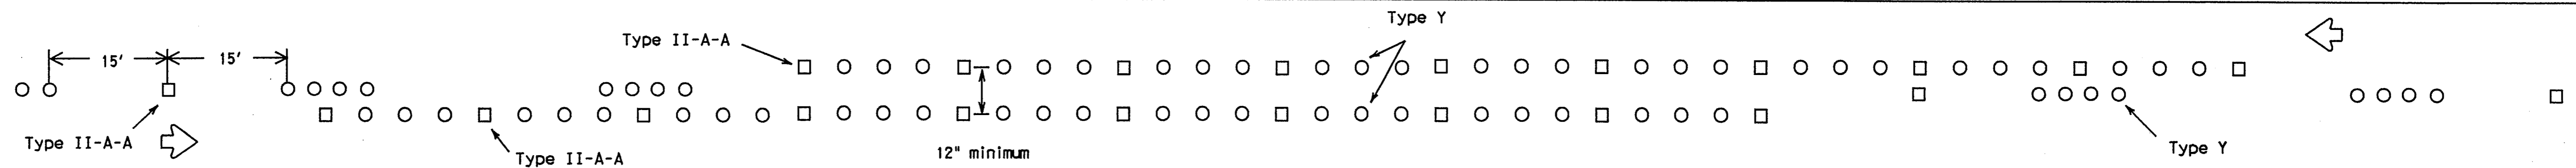

CENTERLINE & NO-PASSING ZONE BARRIER LINES FOR TWO LANE TWO-WAY HIGHWAYS

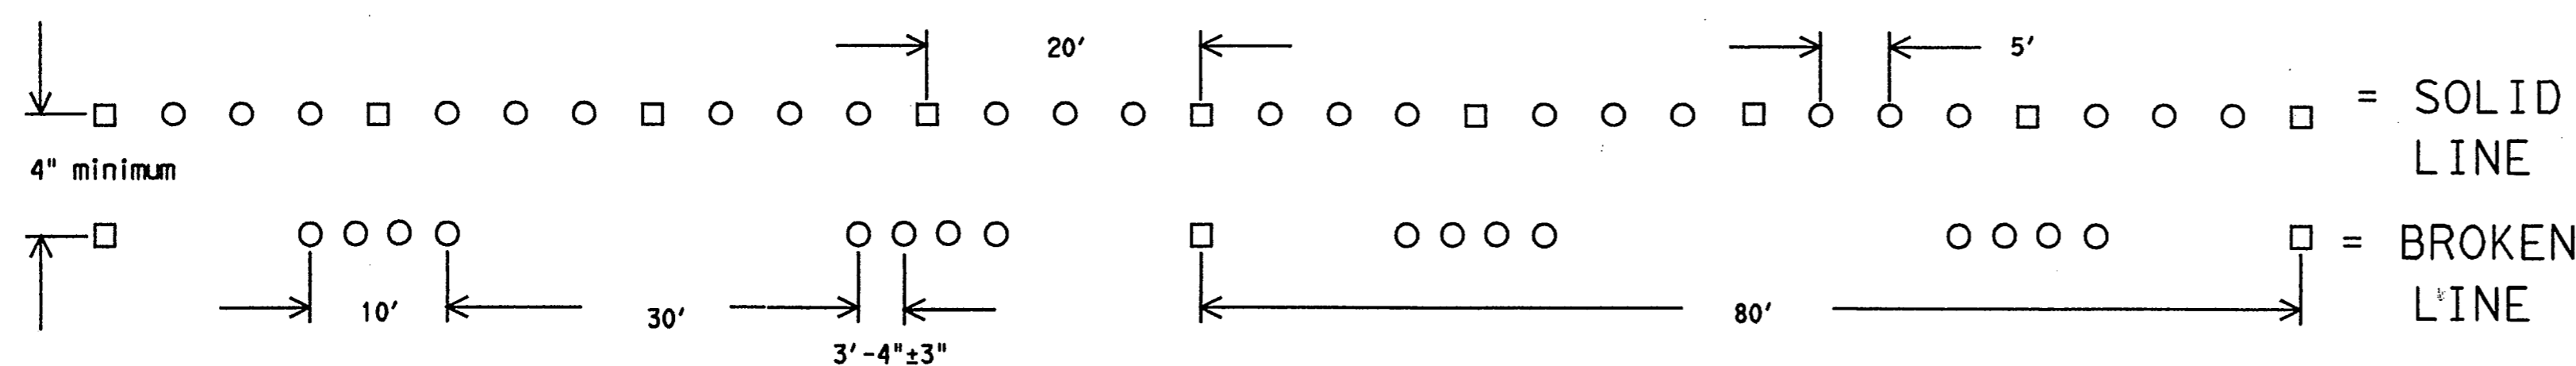

PATTERN DETAIL

STANDARD PLANS
TEXAS DEPARTMENT OF TRANSPORTATION
Traffic Operations Division

TYPICAL STANDARD PAVEMENT MARKINGS
RPM TO SIMULATE STANDARD PAVEMENT MARKINGS
PM(3)-92

ORIG. DRAW. DATE:	DN: L-R	CK: -	DN: - DN	CK: -	NEG. NO.:
REVISIONS	STATE DISTRICT	FEDERAL REGION	FEDERAL AID PROJECT		SHEET
2-82	6	6			35
7-86			COUNTY	CONTROL SECTION	JOB
10-86					HIGHWAY
4-92					

FINAL RECORD DRAWING
 Date: 12/25/99

DN: LR
 CK: CW
 DW: DN
 CK: MT

LEVELS DISPLAYED: 1 2 3 100

DATE: 12/25/99
 ACC: d58hplc/usr/d580504
 FILE: