

17' 18'

3'-9" 3'-6"

Three Posts (230)

Three Posts (330)

19' thru 28'

4'-0"

25'

26' 27'

3'-9" 3'-6" 3'-3" 3'-0"

19' thru 24'

4'-0"

Two Posts (220)

Two Posts (320)

4' thru 16'

4'-0"

4' thru 18'

4'-0"


Sign Width (W)

Sign Width (W)

Max. Wind Beam Spacing

ZONE 3 (Types 300)

Max. Wind Beam Spacing

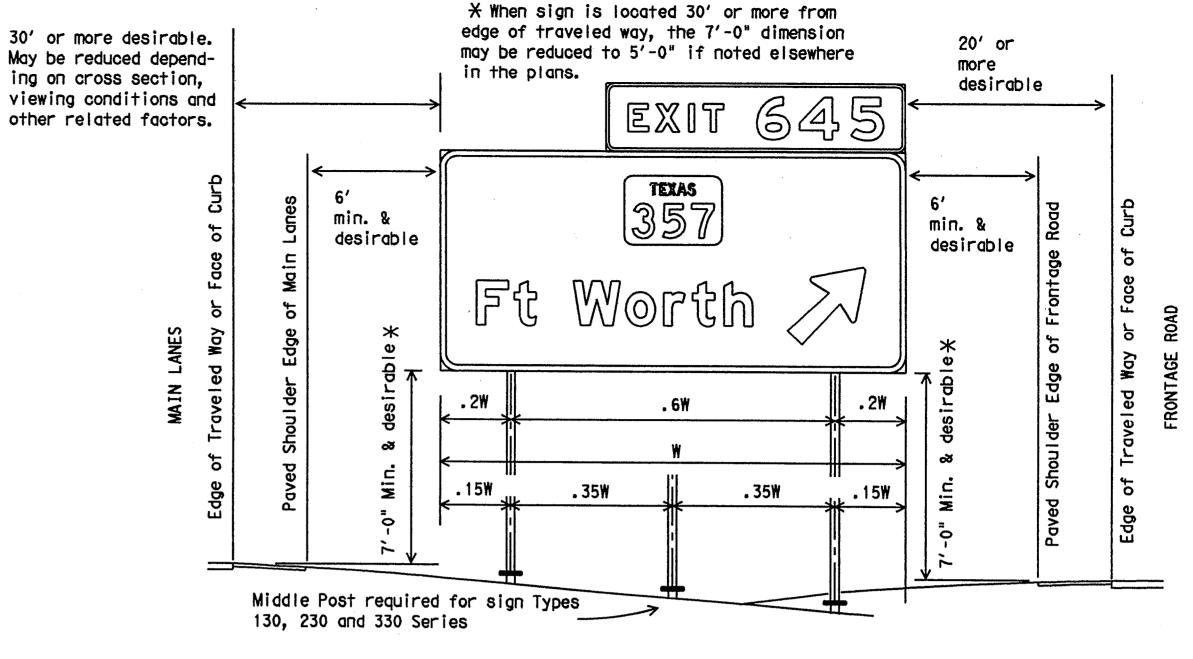

TYPICAL SIGN INSTALLATION AND LOCATION

LATERAL CLEARANCE NOTES:


Lateral clearances of signs mounted on median side of main lanes are the same as shown above where space will permit.

Where a sign is to be located behind guardrail, an allowable minimum clearance of two feet may be used, measured from the face of the guardrail to the near edge of sign.

POST SPACING NOTES:

Post spacing on a two post sign may vary a maximum of plus or minus 10% of total sign width to fit field conditions.

Post spacing on a three post sign may vary a maximum of plus 5% of total sign width to fit field conditions.

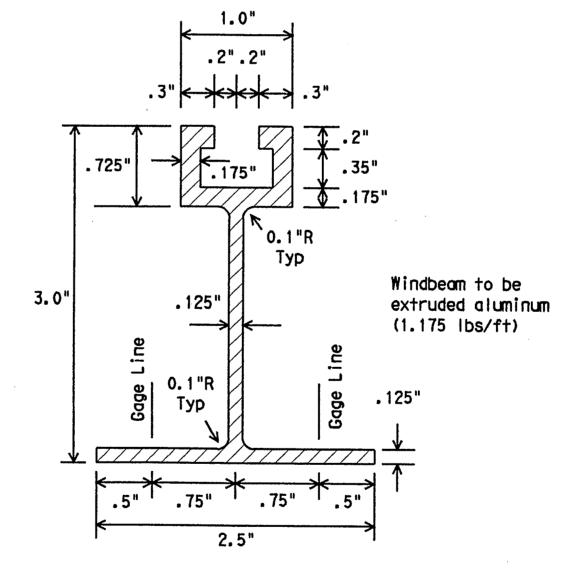

WINDBEAM CROSS SECTION

SPECIFICATION REFERENCE TABLE MATERIALS AND TESTS DIVISION SPECIFICATIONS D-9-7120

GENERAL NOTES:

- 1. Design conforms with AASHTO Specifications for the design and construction of structural supports for highway signs.
- 2. Materials and fabrication shall conform to the requirements of the Department material specifications.
- 3. Structural steel shall conform to the Item, "METAL FOR STRUC-
- 4. Parts shall be saw cut either before galvanizing and the galvanized cut cleaned of zinc build-up, or saw cut after galvanizing and the cut surface treated with zinc-based solder or zinc-rich paint in accordance with ASTM A780. (Cut surface will not be treated until plate is installed and all bolts fully tightened.)
- 5. Exit number panel shall be mounted to the right hand side of the parent sign for right exits and to the left for left hand exits. The number panel shall be mounted with two uprights so its right edge is even with the right edge of the parent sign or vice-versa for left hand exits.



SIGN MOUNTING DETAILS-LARGE ROADSIDE SIGNS STRUCTURE

SMD(2-1)-95

RIG DRAW DATE: August 1995 DN: - LR CK: -DW: - DN CK: -STATE FEDERAL DISTRICT REGION FEDERAL AID PROJECT 6 CONTROL SECTION JOB HIGHWAY

FINAL RECORD DRAWING Date: 12/25/99

27A