


**DEVELOPMENT PLANS**  
**FOR**  
**BELTWOOD NORTH**  
**PHASE 2**  
**ADDISON, TEXAS**

SHEET INDEX	
SHEET NO.	DESCRIPTION
	COVER SHEET
	DRAINAGE AREA MAP
	PAVING PLAN & PROFILE
	WATER & SEWER SHEET

CONNELL DEVELOPMENT CO.  
P.O. BOX 34047  
DALLAS, TEXAS 75234  
357-4694

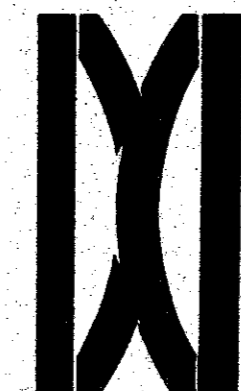

DATE MAY, 1978	SCALE NONE	SHEET
DONALD C. MOREAU - CONSULTING ENGINEER		OF
2355 STEMMONS FRWY • SUITE 1004 • DALLAS, TEXAS • 638-8430		

*As Built 7-20-79*