


0 1 2 3 4 5 6 7 8 9 10 11 12 13 14 15 16 0 1 2 3 4 5 6 7

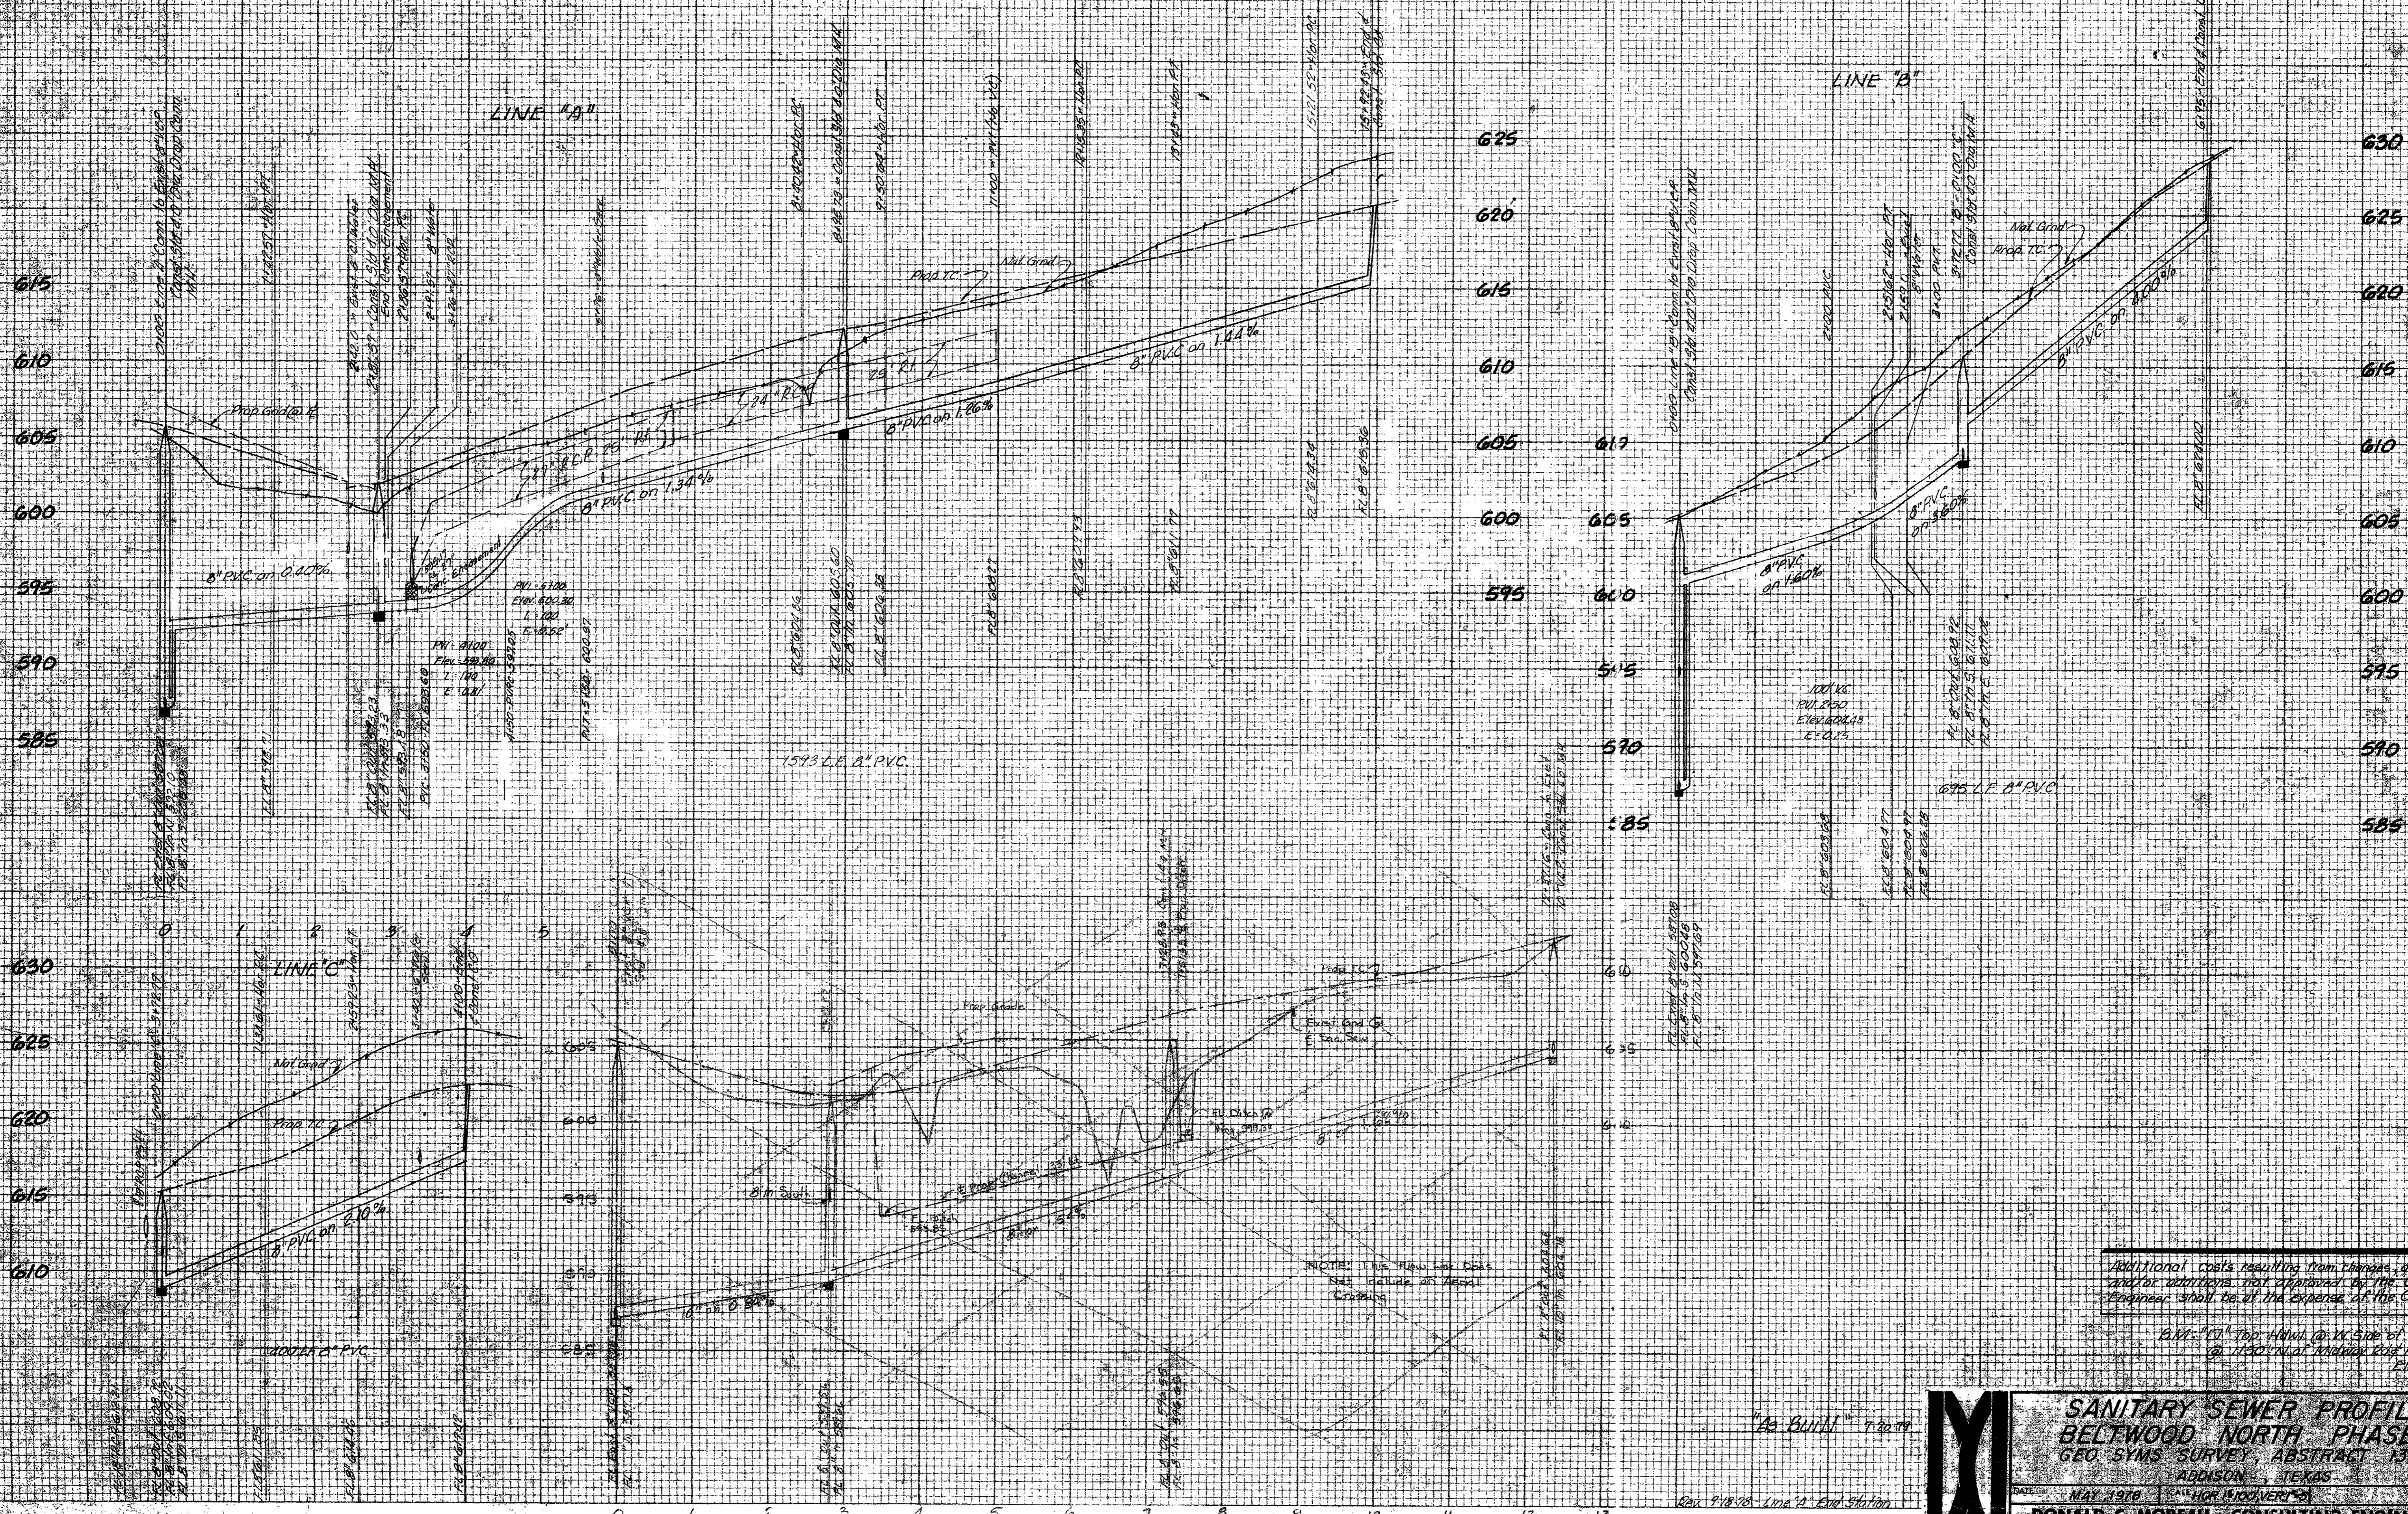

Additional costs resulting from changes, omissions and/or additions not approved by the Owner's Engineer shall be at the expense of the Contractor.

611' E.T. Top 14\"/>

"As Built" Report

SANITARY SEWER PROFILES
BELTWOOD NORTH PHASE 2
 GEO SYMS SURVEY, ABSTRACT 1344
 ADDISON, TEXAS
 DATE: MAY 1978
 DONALD C. MOREAU CONSULTING ENGINEER