


NOTE:
 1. CONTRACTOR SHALL MAINTAIN FIRE LANE ACCESS AROUND EXISTING BUILDING AT ALL TIMES.

CONCRETE REPLACE
 $385 \times 19 = 7315 \text{ FT}^2$
 $= 812.78 \text{ SY}$
 $@ \$34/\text{SY} = \$27,634.44$



4			
3			
2			
1			
NO.	DATE	REVISION	APPROV.
TOWN OF ADDISON, TEXAS			
MIDWAY/BELTLINE SANITARY SEWER PHASE II			
LINE A-1			
FROM STATION 60+00 TO STATION 64+00			
Carter & Burgess <small>Consultants in Engineering, Architecture, Planning and the Environment CARTER & BURGESS, INC. 7950 EMBROOK DRIVE, SUITE 250 DALLAS, TX 75247-4961</small>			
Unit	Scale	Horiz. 1"=20' Vert. 1"=5'	Date 04-05-98
Designed J. Lindner	Checked J. Lindner	Job No. 93327601D	
Drawn R. Howman	Approved J. Lindner	Sheet 18 of 63	

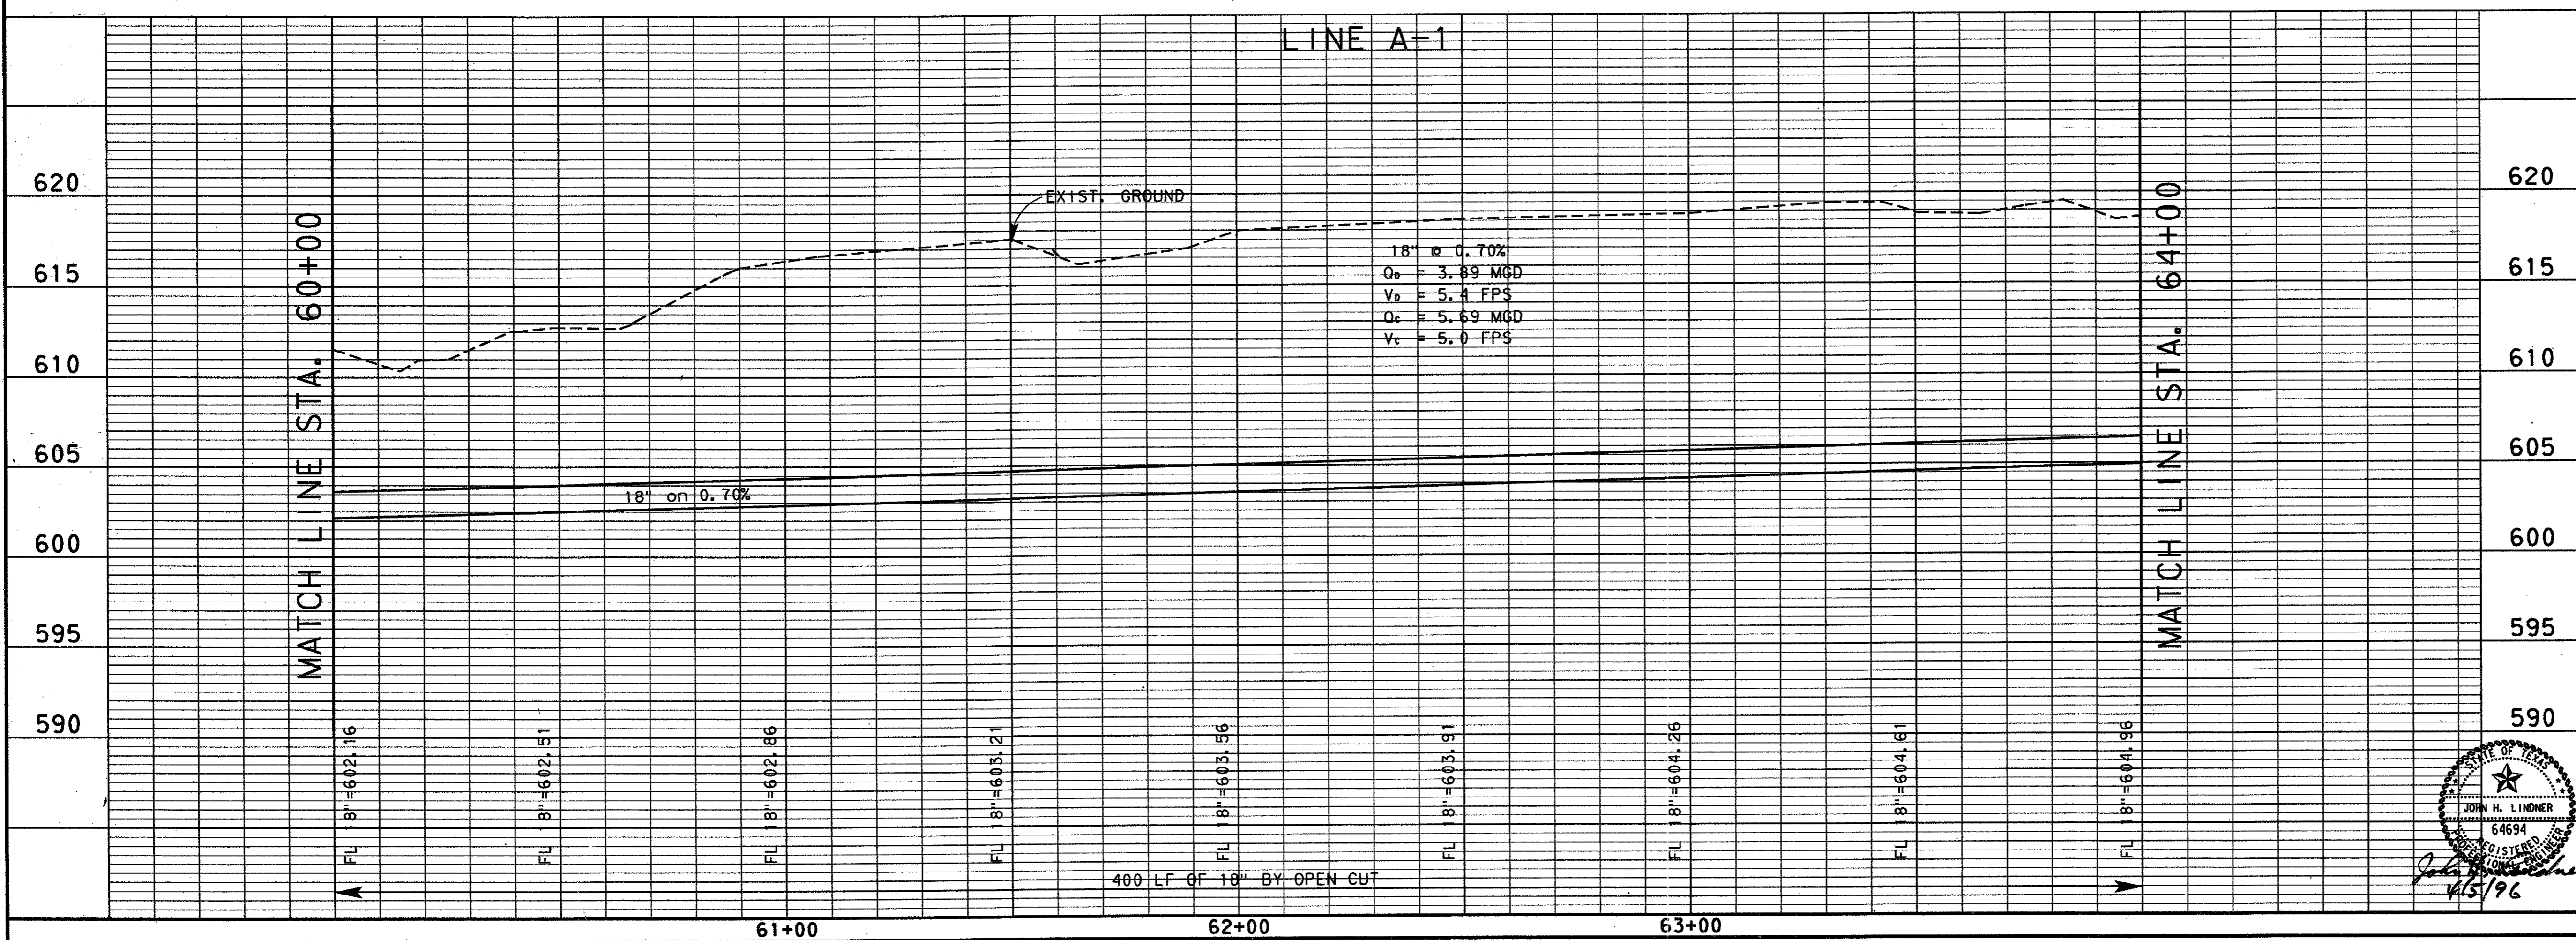