


*Bill  
First  
FINDS  
ALLOWABLE*

REVISIONS: NO. DATE BY  
 1 4-23-96 J.H.L.  
 2  
 3  
 4

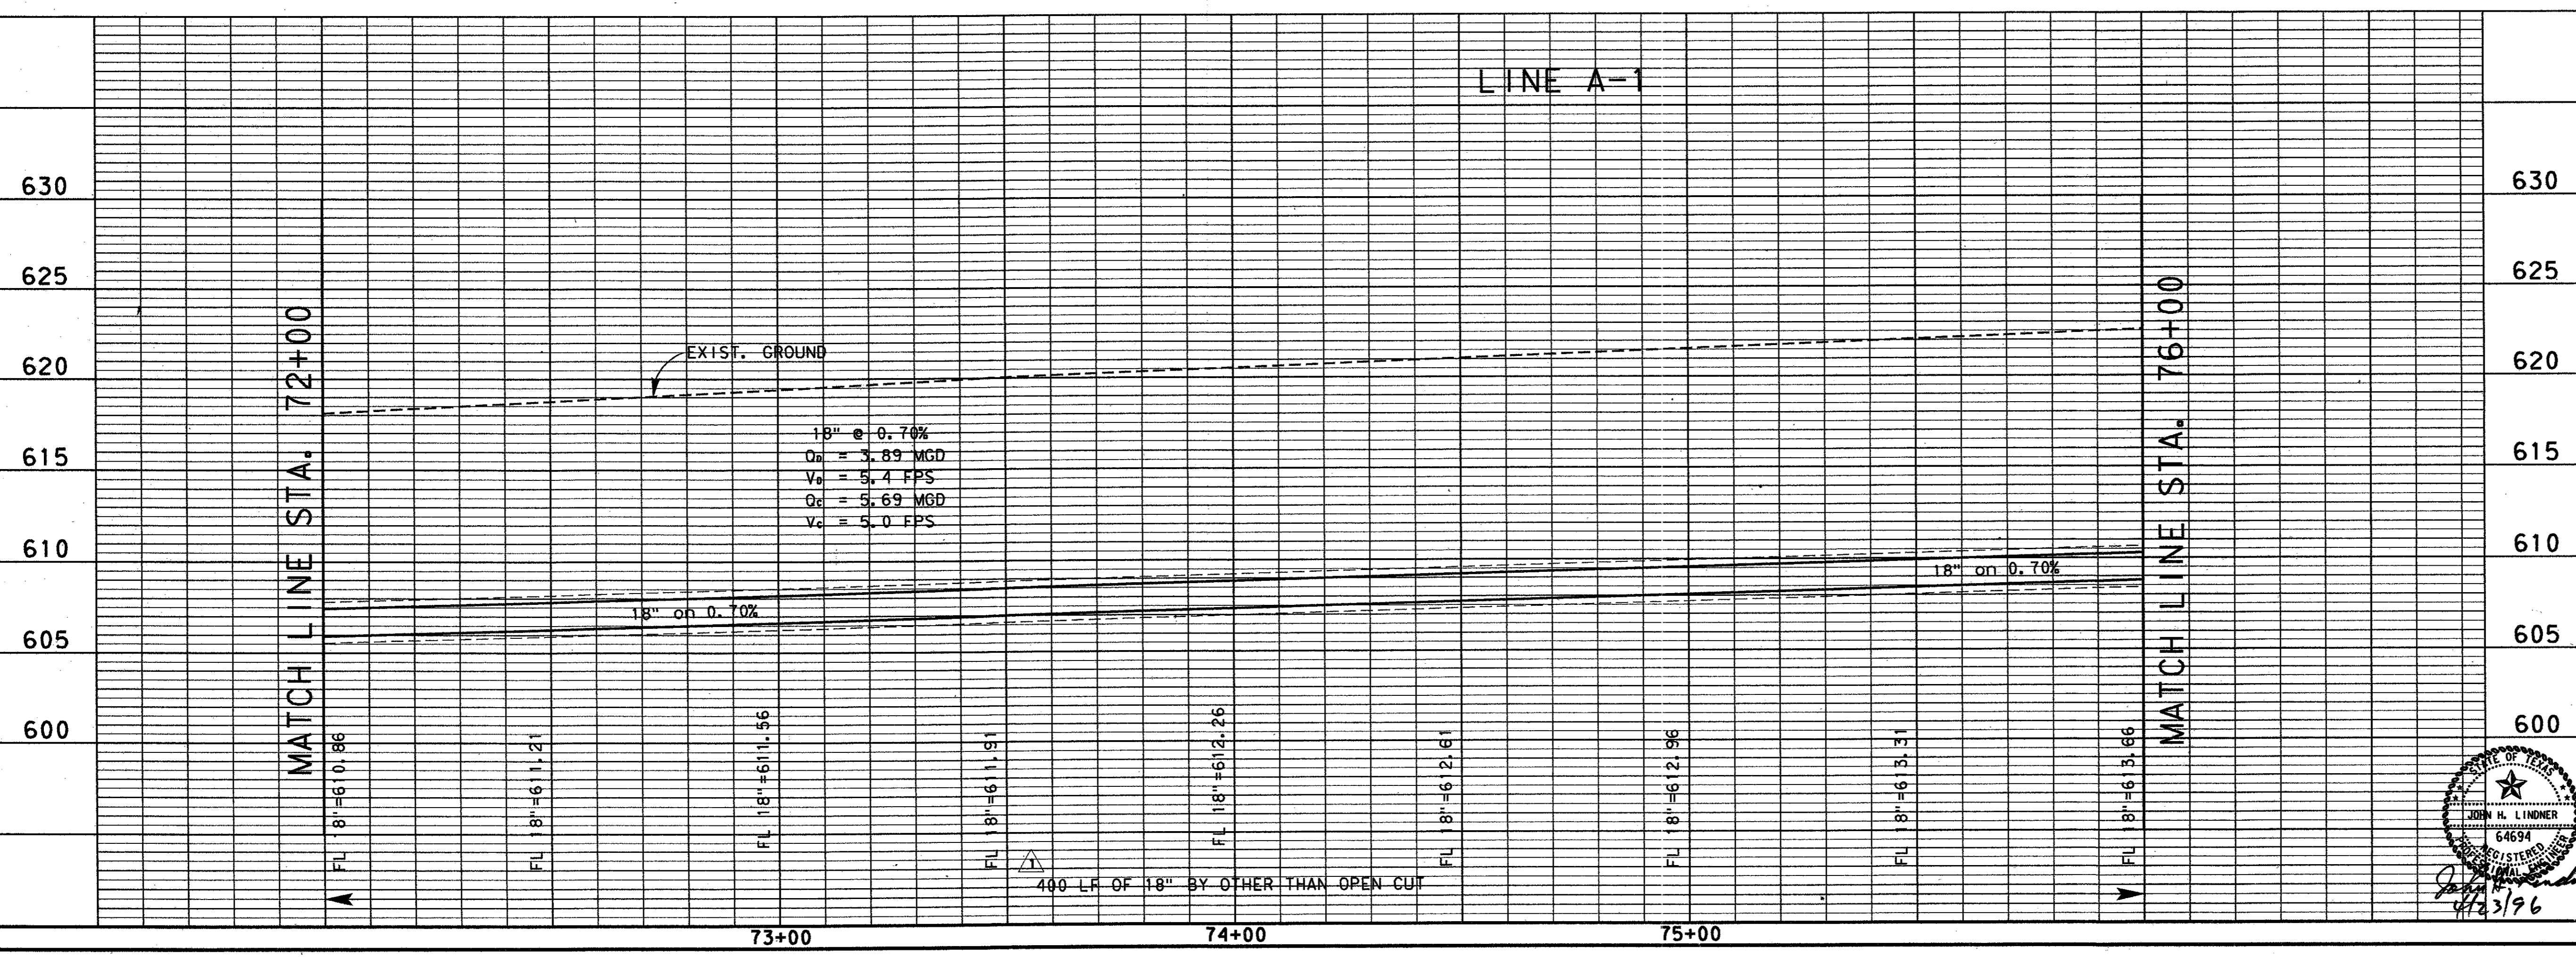

18" @ 0.70%  
 $Q_{max} = 3.89$  MGD  
 $V_{max} = 5.4$  FPS  
 $Q_c = 3.69$  MGD  
 $V_c = 5.0$  FPS

4			
3			
2			
1	4-23-96	ADDENDUM NO. 1	J.H.L.
NO.	DATE	REVISION	APPROV.
TOWN OF ADDISON, TEXAS			
MIDWAY/BELTLINE SANITARY SEWER PHASE II			
LINE A-1 FROM STATION 72+00 TO STATION 76+00			
<b>Carter &amp; Burgess</b> <small>Consultants in Engineering, Architecture, Planning and the Environment.</small> <b>CARTER &amp; BURGESS, INC.</b> <small>7950 ELMBROOK DRIVE, SUITE 250 DALLAS, TX 75247-4961</small>			
Unit	Scale	Horiz. 1"=20' Vert. 1"=5'	Date 04-05-96
Designed	J. Lindner	Checked	J. Lindner
Drawn	R. Howman	Approved	J. Lindner
Job No.	93327601D		Sheet 21 of 63
32765518.DGN			