



675 4.5" PVC S.W. PIPE  
 All sanitary sewer pipe to be installed per city of Addison specifications

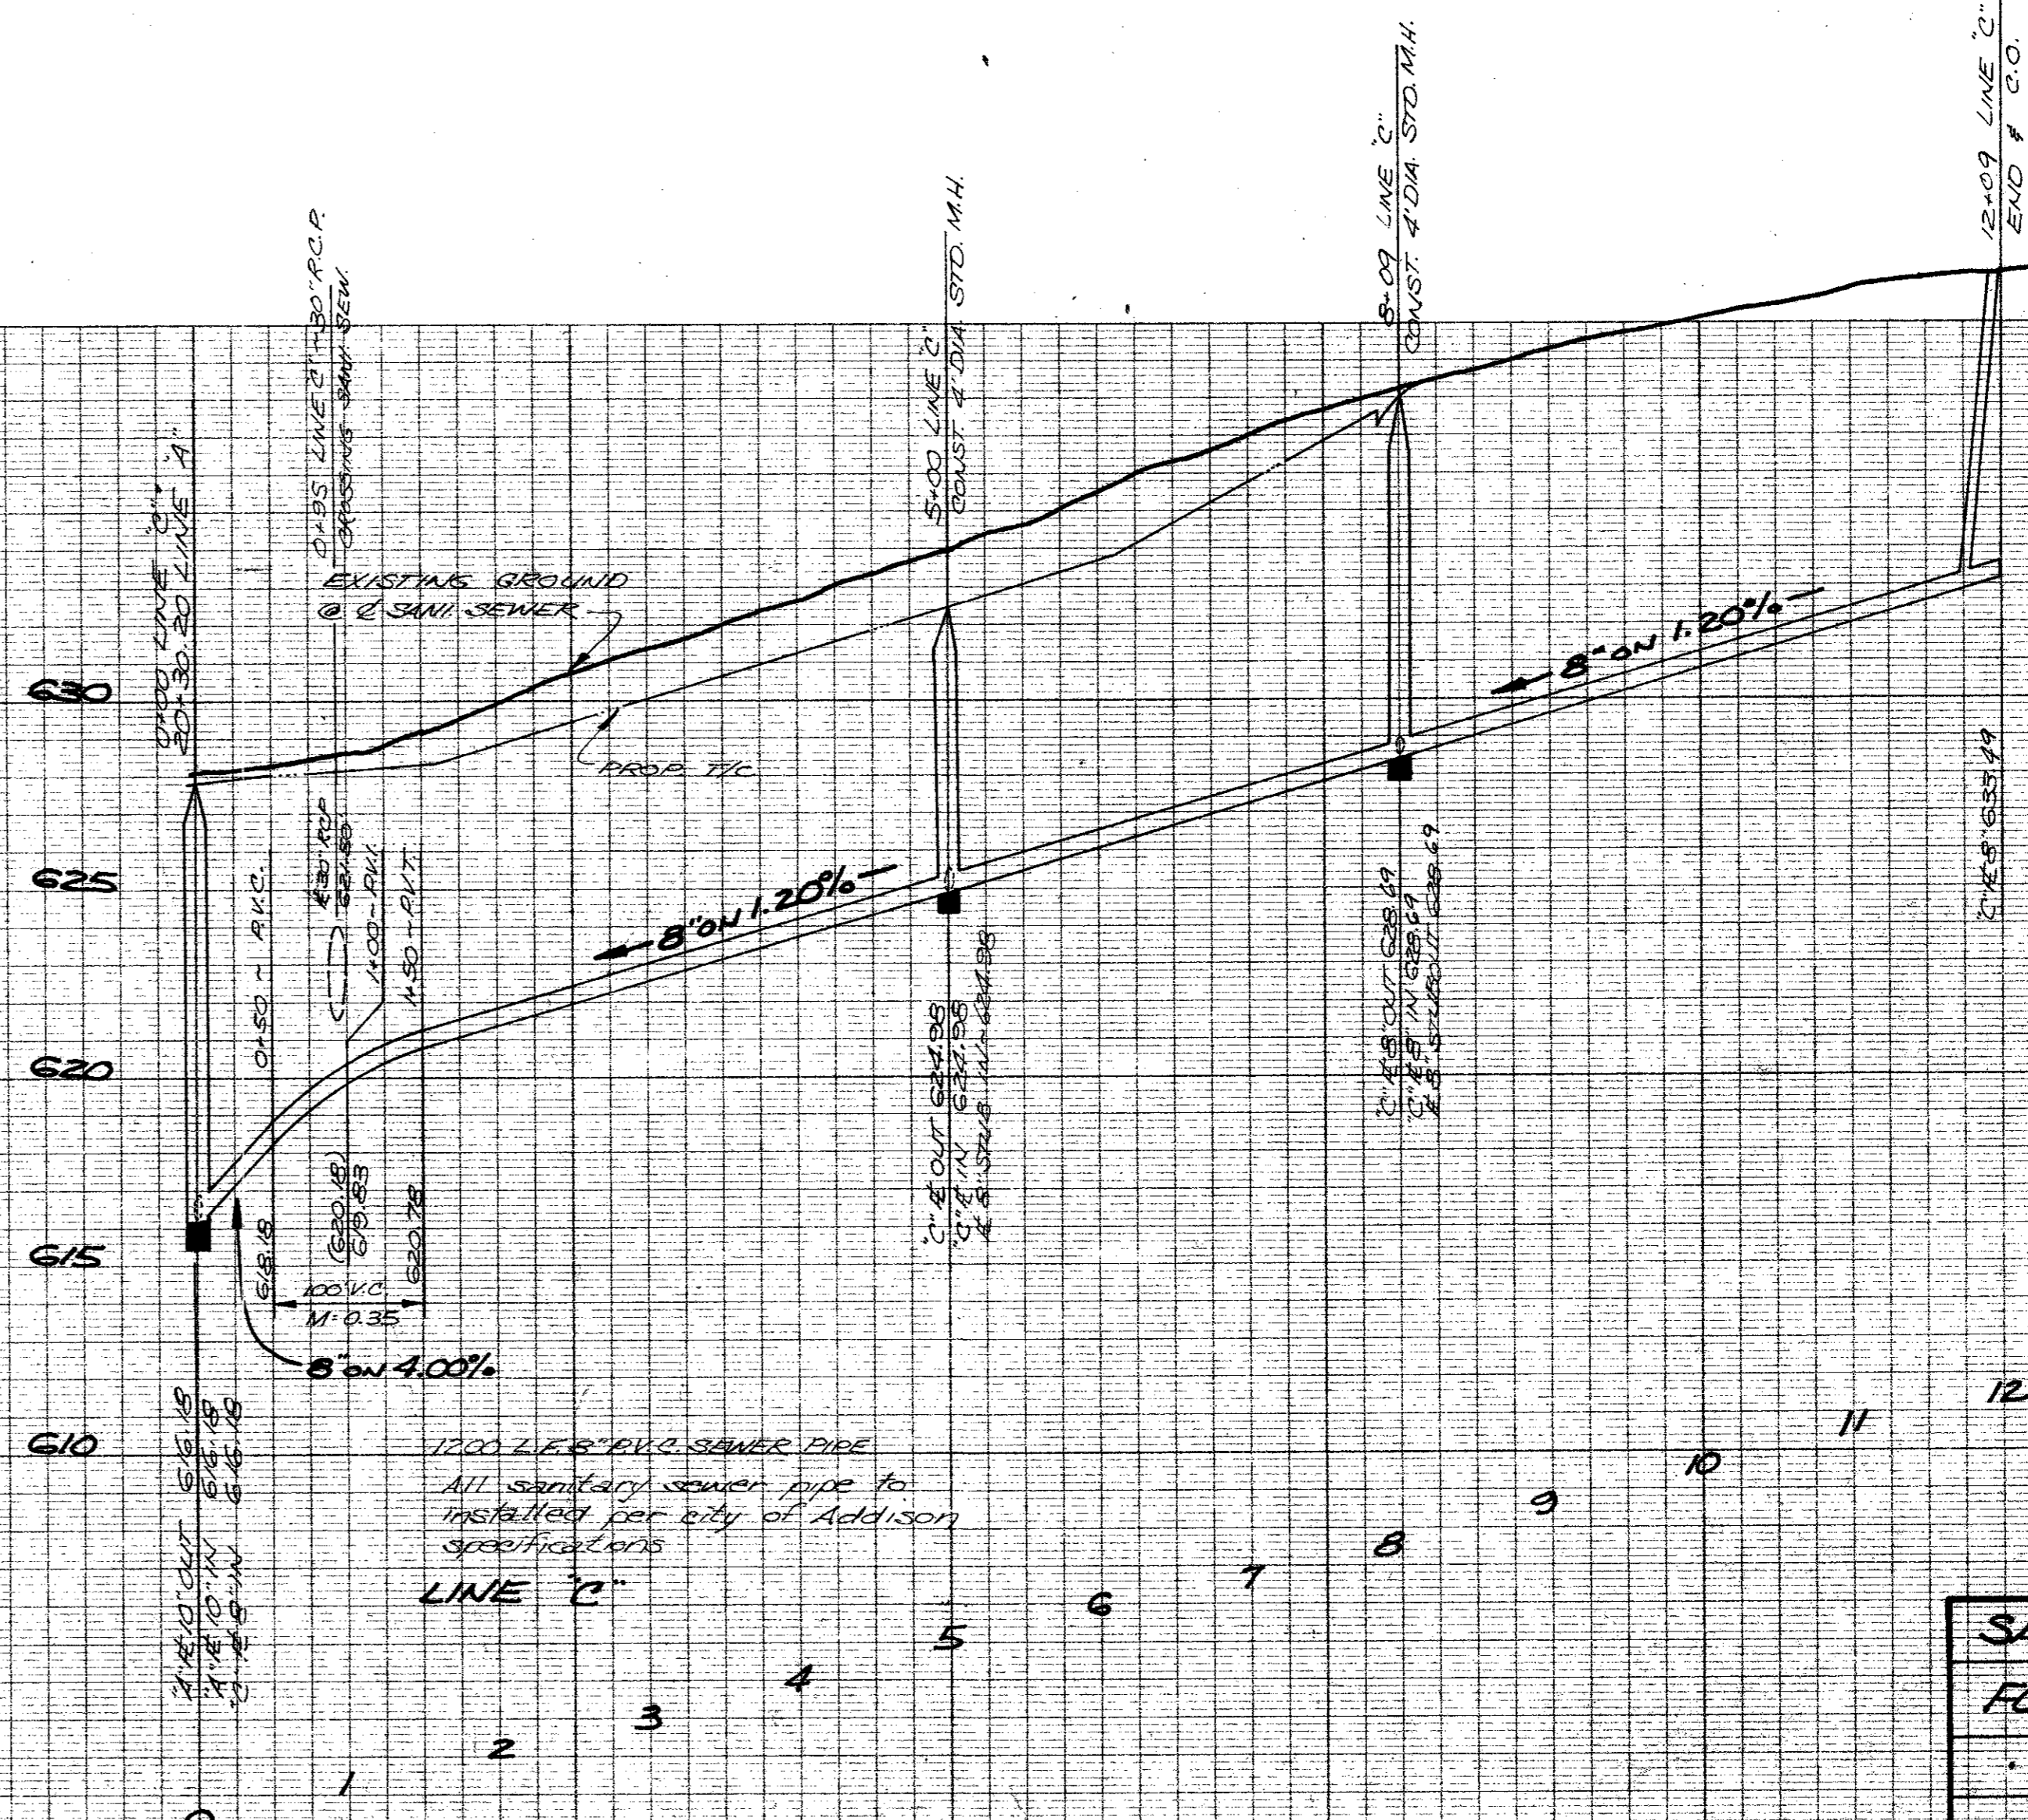

1200 4.5" PVC S.W. PIPE  
 All sanitary sewer pipe to be installed per city of Addison specifications

AS BUILT  
 AUG. 13, 1979

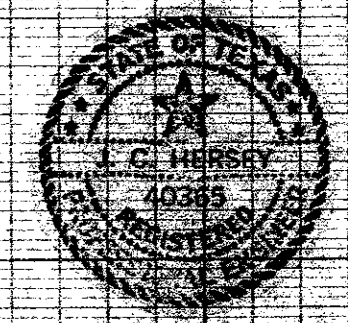

LINES 'B' & 'C'

<b>SANITARY SEWER WATER</b>					
<b>FOR LEDGE MONT LANE</b>					
<b>CITY OF ADDISON</b>					
<b>DALLAS COUNTY, TEXAS</b>					
<b>THREADGILL - DOWDEY and ASSOCIATES</b>					
<b>CONSULTING ENGINEERS DALLAS, TEXAS</b>					
DESIGN	DRAWN	CHECKED	DATE	SCALE	JOB SHEET
DMD	HTM	DMD	4/78	1"=100' 1"=4'	433.6 2

BENCH MARK: Bolt in Brazos Power Pole (No. 16-12-6) on the south side of Keller Springs Rd. #350 west of the west line of Ledge Mont Lane  
 Elev. 636.67