


NOTE:
Paving & subgrade preparation and materials to be installed in accordance with City of Dallas general specifications and standards.

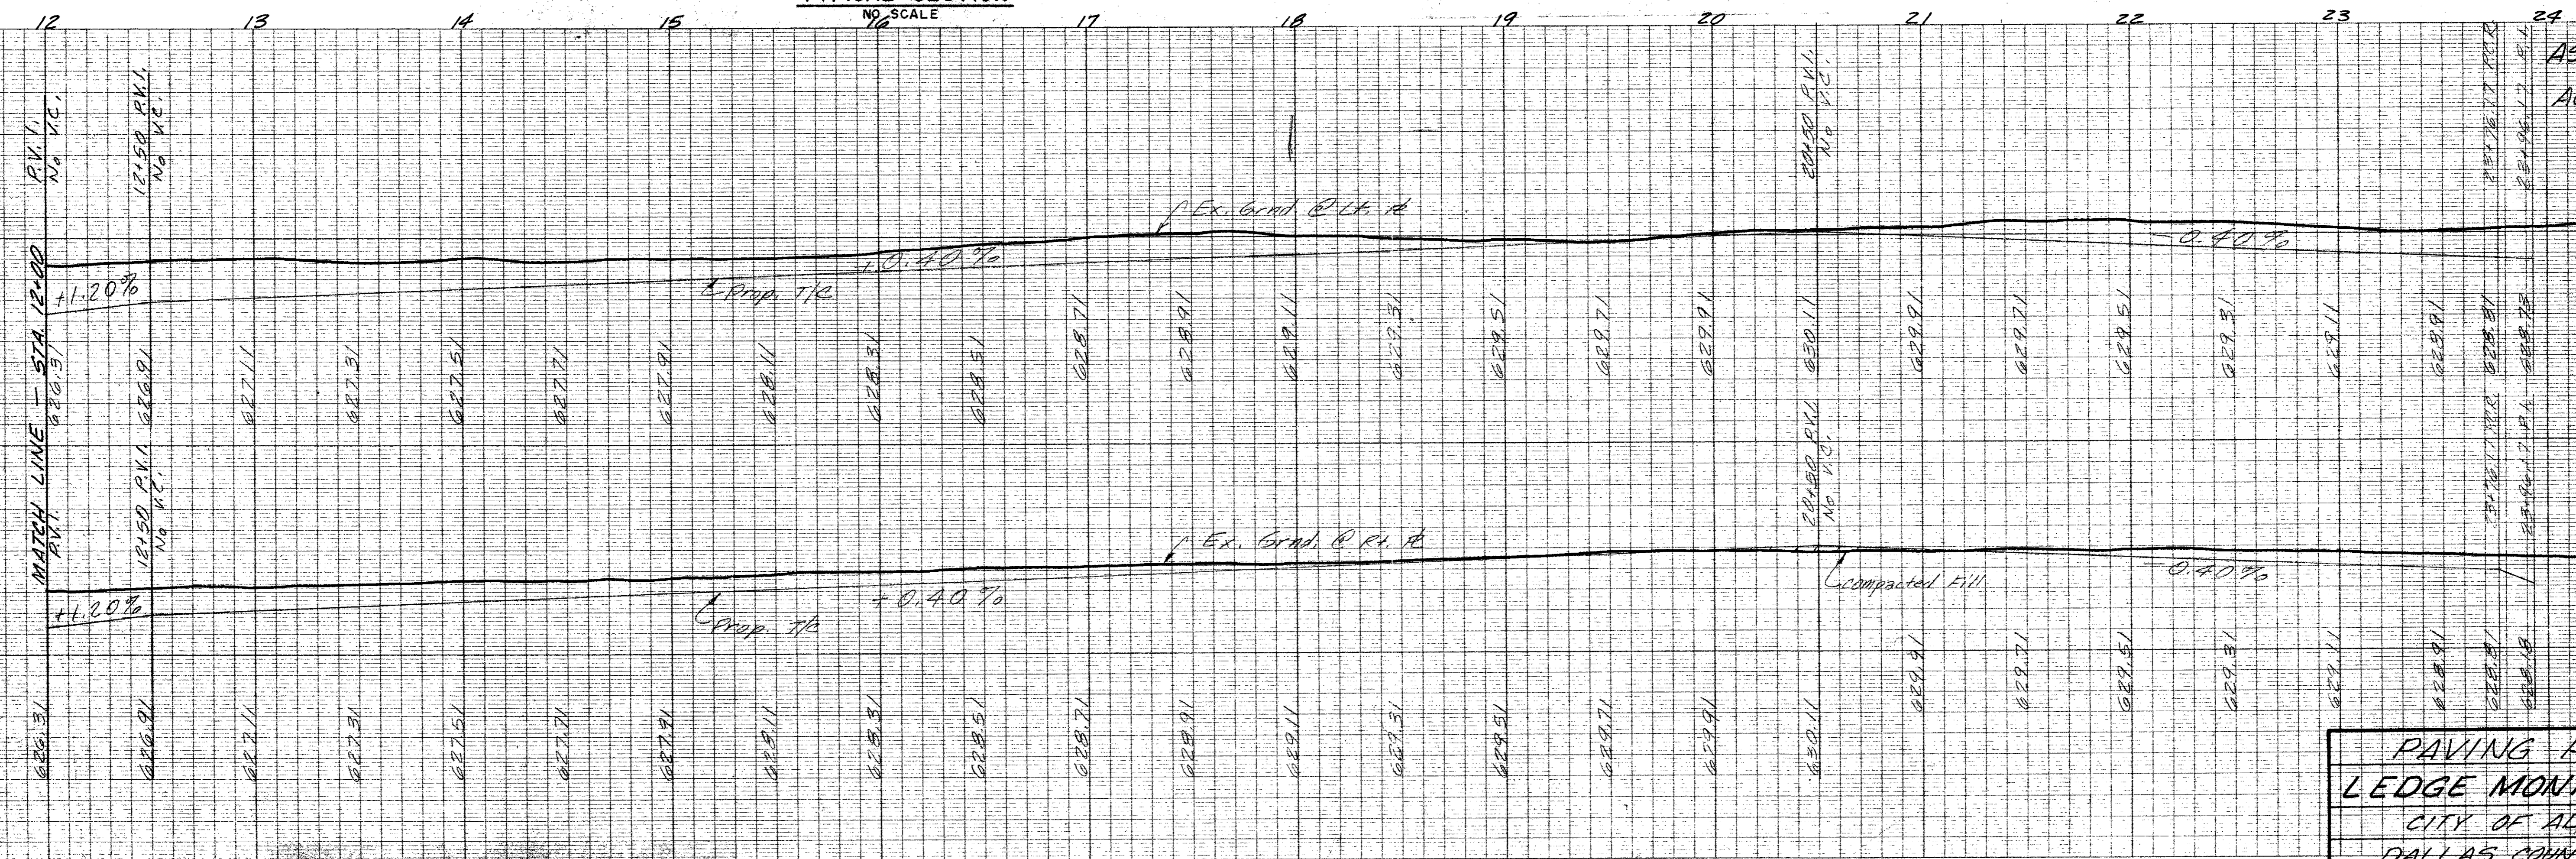

NO. 1265-PLAN PROFILE PLATE A
"CLEARPRINT PAPER CO."
MADE IN U.S.A.

NO.	DATE	BY	REVISION
1	5/7-79	RE	Revised low part nos at 11450, new at 12-00, made 12150 P.M.L. - No V.C.

BENCH MARK: Bolt in Brazos Power Pole (No. A6-12-6) on the south side of Keller Springs Road, 3350' west of the west line of Ledge Mont Lane. Elev. 636.67

BENCH MARK: 60d nail in power pole east side Addison Road, northwest corner of Bent Tree Oaks Addition. Elev. 644.05

PAVING PLANS
LEGE MONT LANE
CITY OF ADDISON
DALLAS COUNTY, TEXAS

THREADGILL - DOWDEY and ASSOCIATES
CONSULTING ENGINEERS DALLAS, TEXAS

DESIGN	DRAWN	CHECKED	DATE	SCALE	JOB	SHEET
AR.W.	R.E.	J.G.B.	4-78	1/4" = 1'-0"	124-V	2/2

PLATE No