



AS BUILT  
DATE 3/29/82

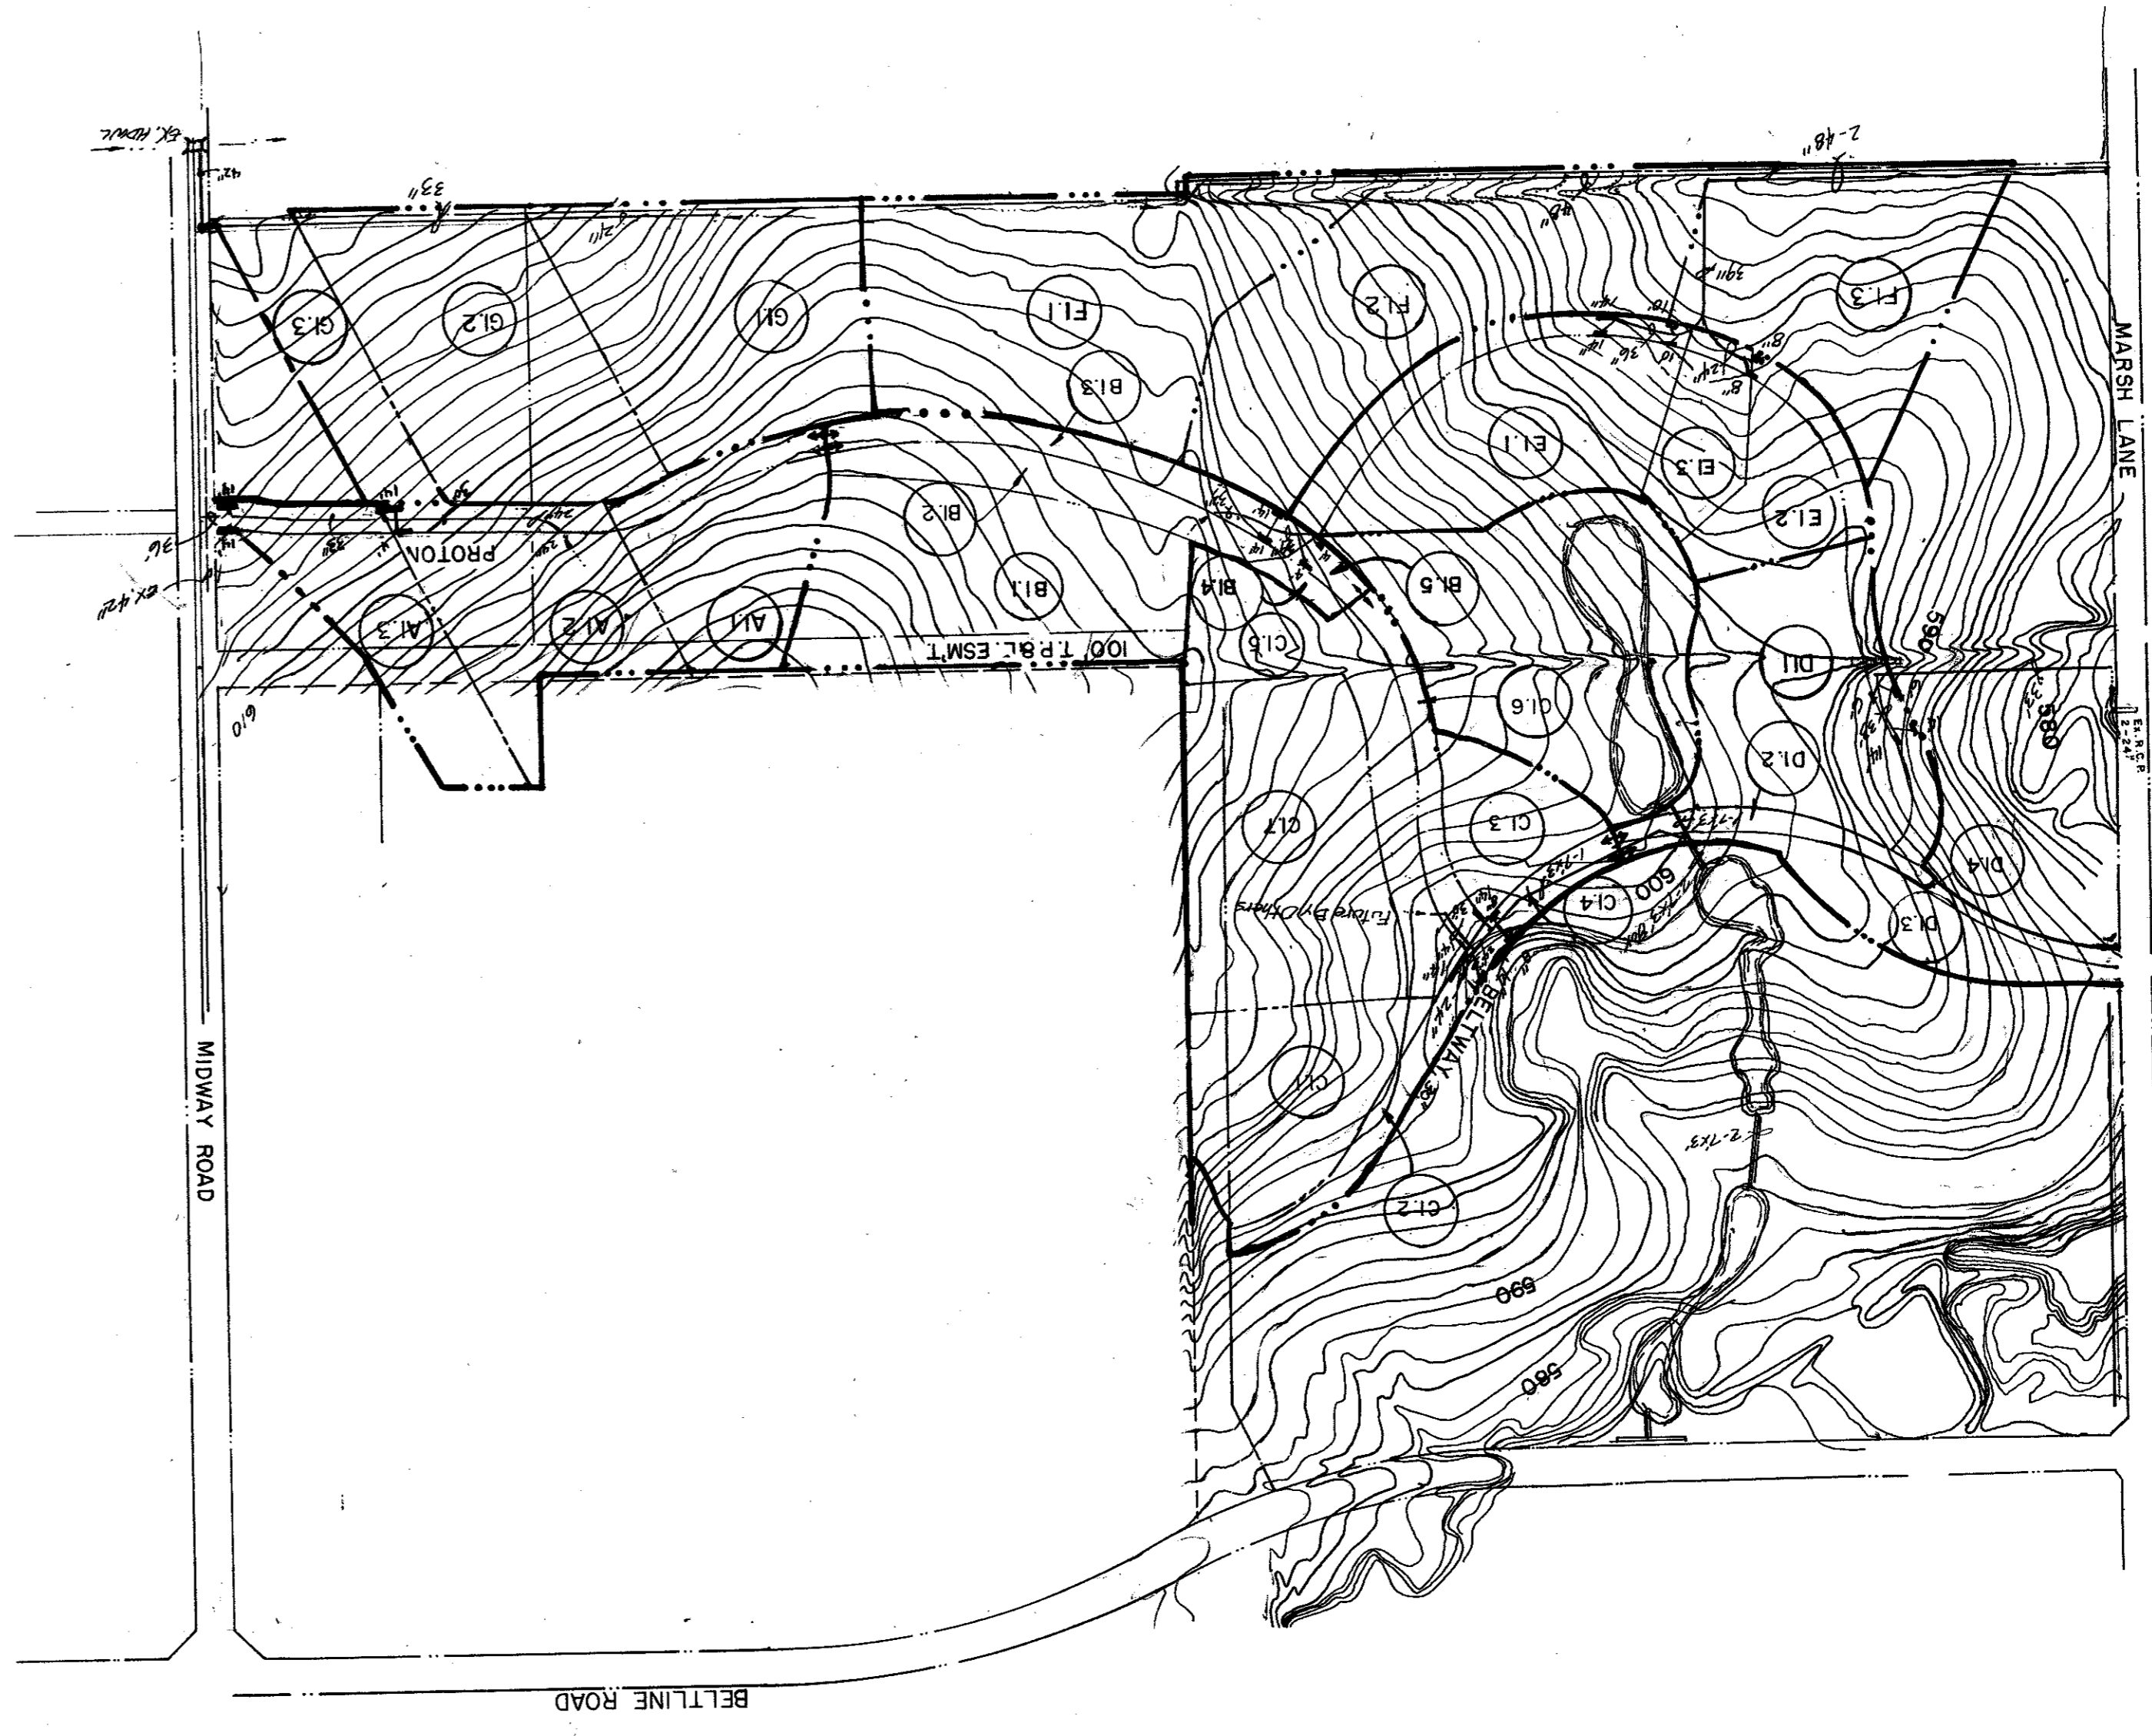

6  
7

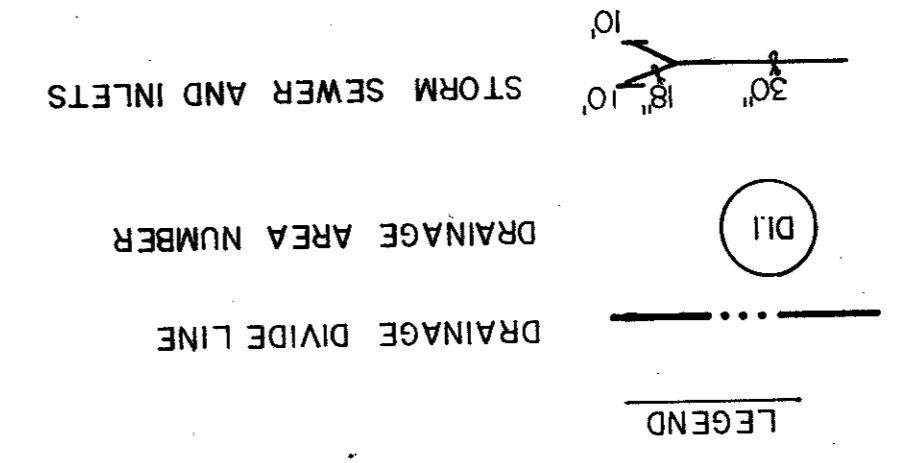

LINE NO.	ACRES	C	TIME	I	O	SIZE	REMARKS
A1.1	6.06	0.7	15	6.6	28.0	2-14"	FROM FUTURE SYSTEM
A1.2	7.3	"	15	6.6	33.7	2-14"	5.8 BY PASS
A1.3	4.7	0.8	10	7.5	31.7	2-14"	"
B1.1	10.6	0.7	15	6.6	49.0	"	INTO FUTURE SYSTEM
B1.2	2.6	"	"	12.0	"	"	TO B1.3
B1.3	"	0.9	10	7.5	17.6	2-14"	NO BY PASS
B1.4	0.6	0.7	"	6.6	2.8	"	TO B1.5
B1.5	0.5	0.9	"	7.5	3.4	2-4"	NO BY PASS
C1.1	6.3	0.3	15	6.6	12.5	2-14"	12.5 TO C1.2
C1.2	1.8	0.9	"	"	10.7	2-14"	10.7 + 12.5 TO C1.6
C1.3	2.9	0.7	"	"	13.4	"	13.4 TO C1.4
C1.4	0.6	0.9	"	"	3.6	2-8"	1.0 BY PASS
C1.5	5.1	0.7	"	"	23.6	"	23.6 TO C1.6
C1.6	2.0	0.9	"	"	11.9	2-14"	7.5 BY PASS
C1.7	10.0	0.7	15	6.6	46.2	2-14"	FUTURE DEVELOPMENT
D1.1	10.3	0.7	15	6.6	53.5	2-14 82-6"	SAG
D1.2	1.3	0.9	10	7.5	8.8	"	INTO D1.1
D1.3	2.7	0.8	"	7.5	18.2	"	INTO MARSH LANE
D1.4	0.6	0.9	"	4.0	"	"	"
E1.1	8.2	0.7	15	6.6	38.0	2-14"	10.0 BY PASS
E1.2	3.8	"	"	17.5	2-8"	"	"
E1.3	2.8	"	"	"	12.9	2-10"	SAG (68.4 TOTAL)
F1.1	15.4	0.7	15	6.6	71.1	"	"
F1.2	14.0	"	"	6.6	64.7	"	"
F1.3	9.2	"	"	"	42.5	"	"
G1.1	10.6	0.7	15	6.6	49.0	"	"
G1.2	11.7	0.8	"	"	61.8	"	"
G1.3	4.1	0.8	"	"	21.6	"	"