
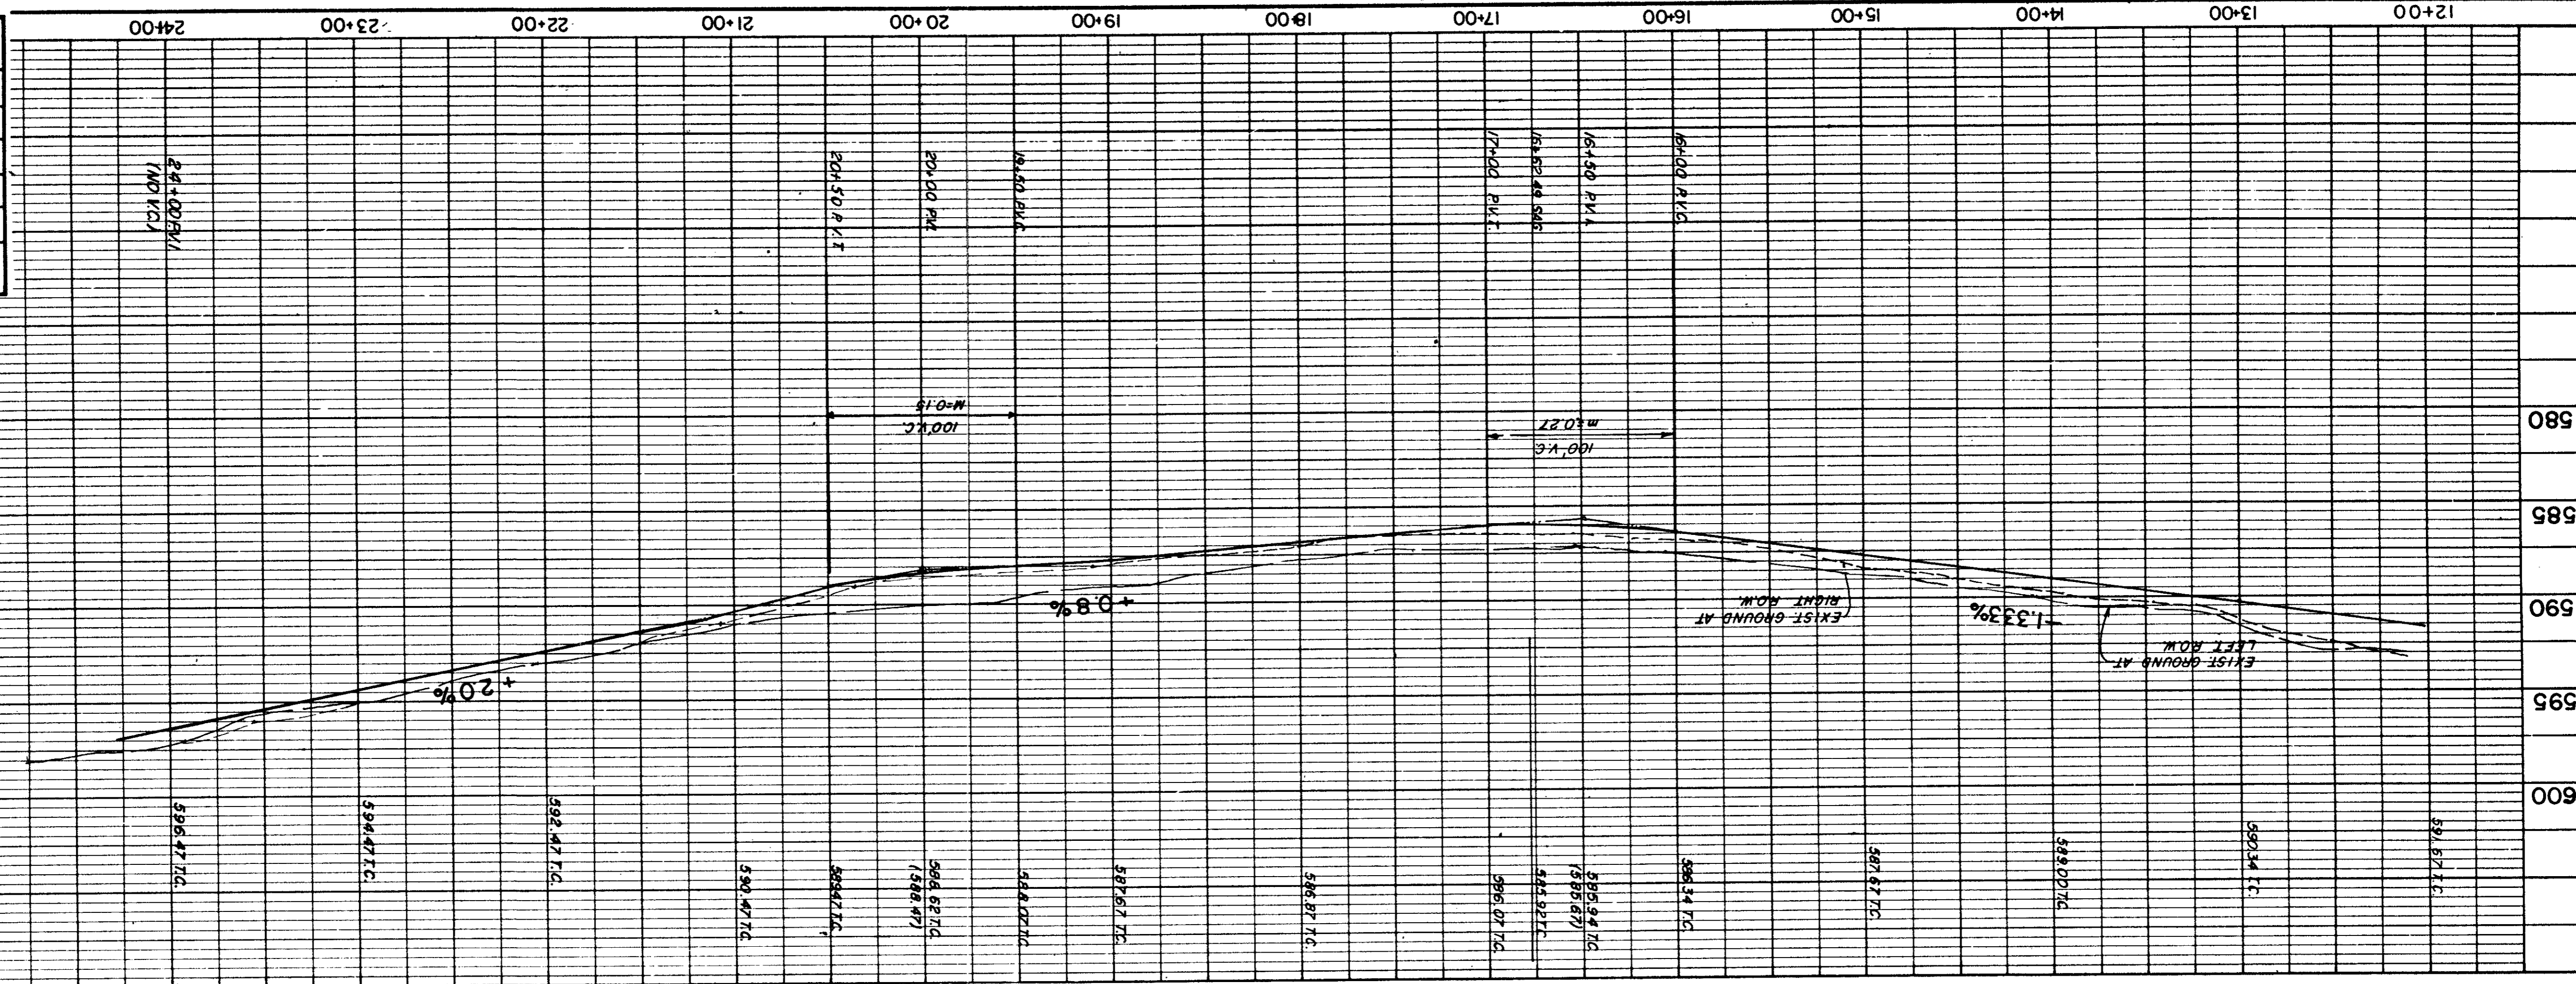


RAYMOND L. GOODSON JR. INC., ENGINEERS	
DESIGN DRAWN	DATE
SCALE	NOTES
FILE NO.	
CITY OF ADDISON, TEXAS	
LES LACS AVENUE	
STA 12+00 to STA 24+00	
PAVING PLAN & PROFILE	
RLG. INC.	JULY 1981
1"=50'H	
INC.	
80-95	

DATE 8/29/82
AS BUILT

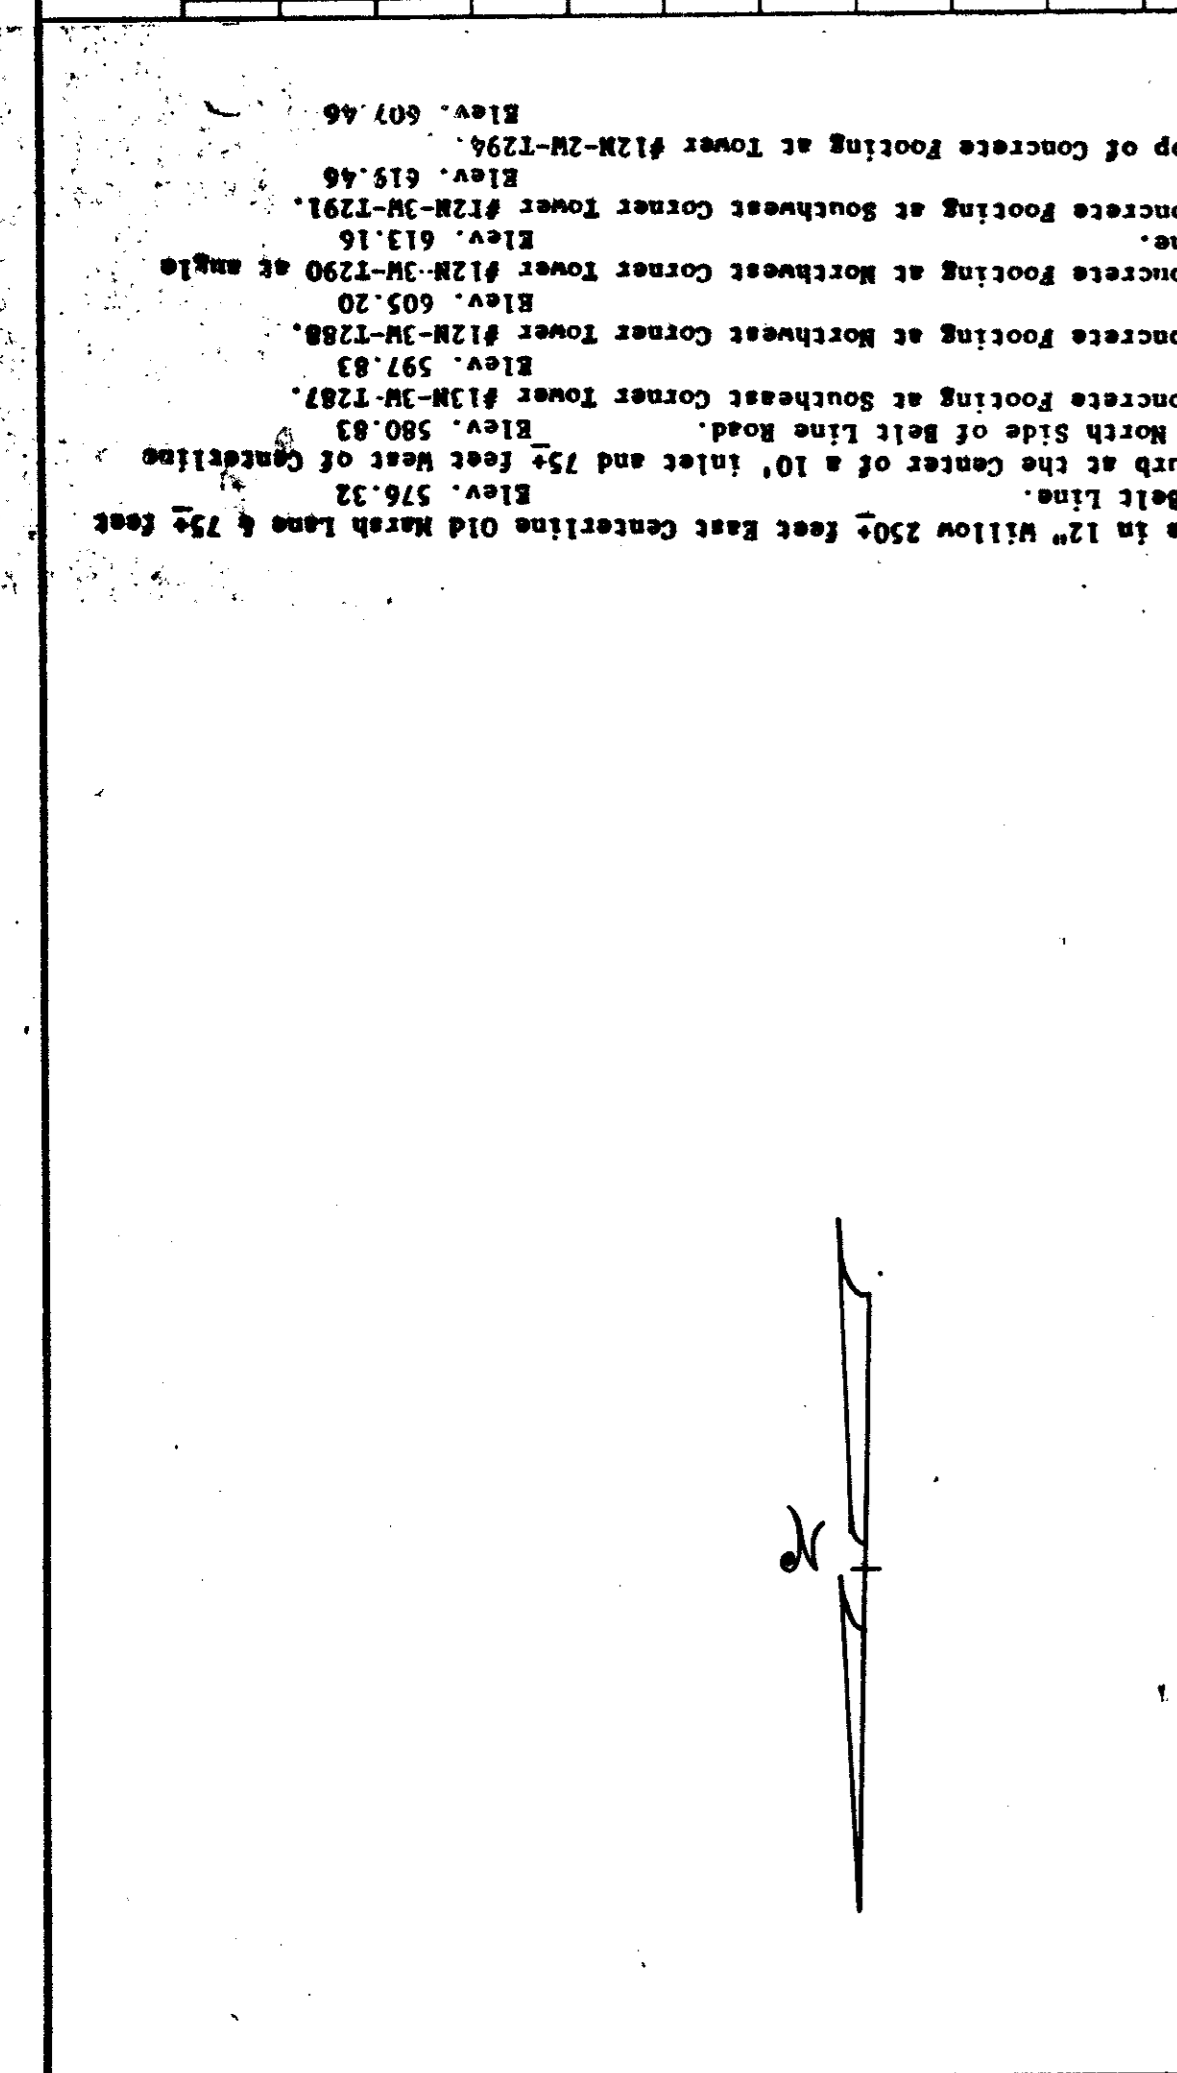

GENERAL NOTES

- All areas to receive fill shall be scarified to a depth of 6 inches and compacted to a density of 95% Standard Proctor Density. All fill shall be placed in horizontal layers not exceeding 8 inches (loose depth) and compacted to a density of 95% Standard Proctor Density.
- The Contractor shall be entirely responsible for damage to existing utilities, streets, curbs, sidewalks and other structures of any kind during the execution of this work and shall be liable for damage to public or private property resulting therefrom.
- All materials and workmanship shall conform to the City of Addison Standards and Specifications and to the contract specifications and documents.
- The location of all utilities are taken from existing public records (additional), other than those on the plans may be present.
- The exact location must be determined by the Contractor. It is the duty of the Contractor to ascertain whether any other facilities.
- "□" Cut at top of concrete Footing at Tower #12N-2N-179A. Elev. 607.46
- "□" Top of concrete Footing at Southwest Corner Tower #12N-3N-1791. Elev. 615.46
- "□" Top of concrete Footing at Northwest Corner Tower #12N-3N-1790 at angle point in Tower line. Elev. 613.16
- "□" Top of concrete Footing at Northwest Corner Tower #12N-3N-1788. Elev. 605.20
- "□" Top of concrete Footing at Northwest Corner Tower #12N-3N-1788. Elev. 597.83
- "□" Top of concrete Footing at Southeast Corner Tower #13N-3N-1787. Elev. 580.83
- "□" Top of curb at the North Side of Belt Line Road. Elev. 576.32
- North Centerline Belt Line. Elev. 576.32
- Ballroad Spine in 12" Willow 250' feet East Centerline Old Marsh Lane & 75' feet North Centerline Belt Line. Elev. 576.32

BENCH MARKS

1. Railroad Spine in 12" Willow 250' feet East Centerline Old Marsh Lane & 75' feet North Centerline Belt Line. Elev. 576.32

2. "□" Top of curb at the North Side of Belt Line Road. Elev. 580.83

3. "□" Top of concrete Footing at Southeast Corner Tower #13N-3N-1787. Elev. 580.83

4. "□" Top of concrete Footing at Northwest Corner Tower #12N-3N-1788. Elev. 605.20

5. "□" Top of concrete Footing at Northwest Corner Tower #12N-3N-1790 at angle point in Tower line. Elev. 613.16

6. "□" Top of concrete Footing at Southwest Corner Tower #12N-3N-1791. Elev. 615.46

7. "□" Cut at top of concrete Footing at Tower #12N-2N-179A. Elev. 607.46

PROJECT	
NOTE BOOK	
NO. OF SHEETS	
DATE	
BY	
CHECKED	
APPROVED	

PLAN	
NOTE BOOK	
NO. OF SHEETS	
DATE	
BY	
CHECKED	
APPROVED	