


CITY OF ADDISON, TEXAS
 RAYMOND L. GOODSON JR., INC. CONSULTING ENGINEERS
WATER & SANITARY SEWER PLAN



DESIGN	DATE	SCALE	NOTES
RAYMOND L. GOODSON	11/23/81	1"=100'	R.L.G.

FILE NO.

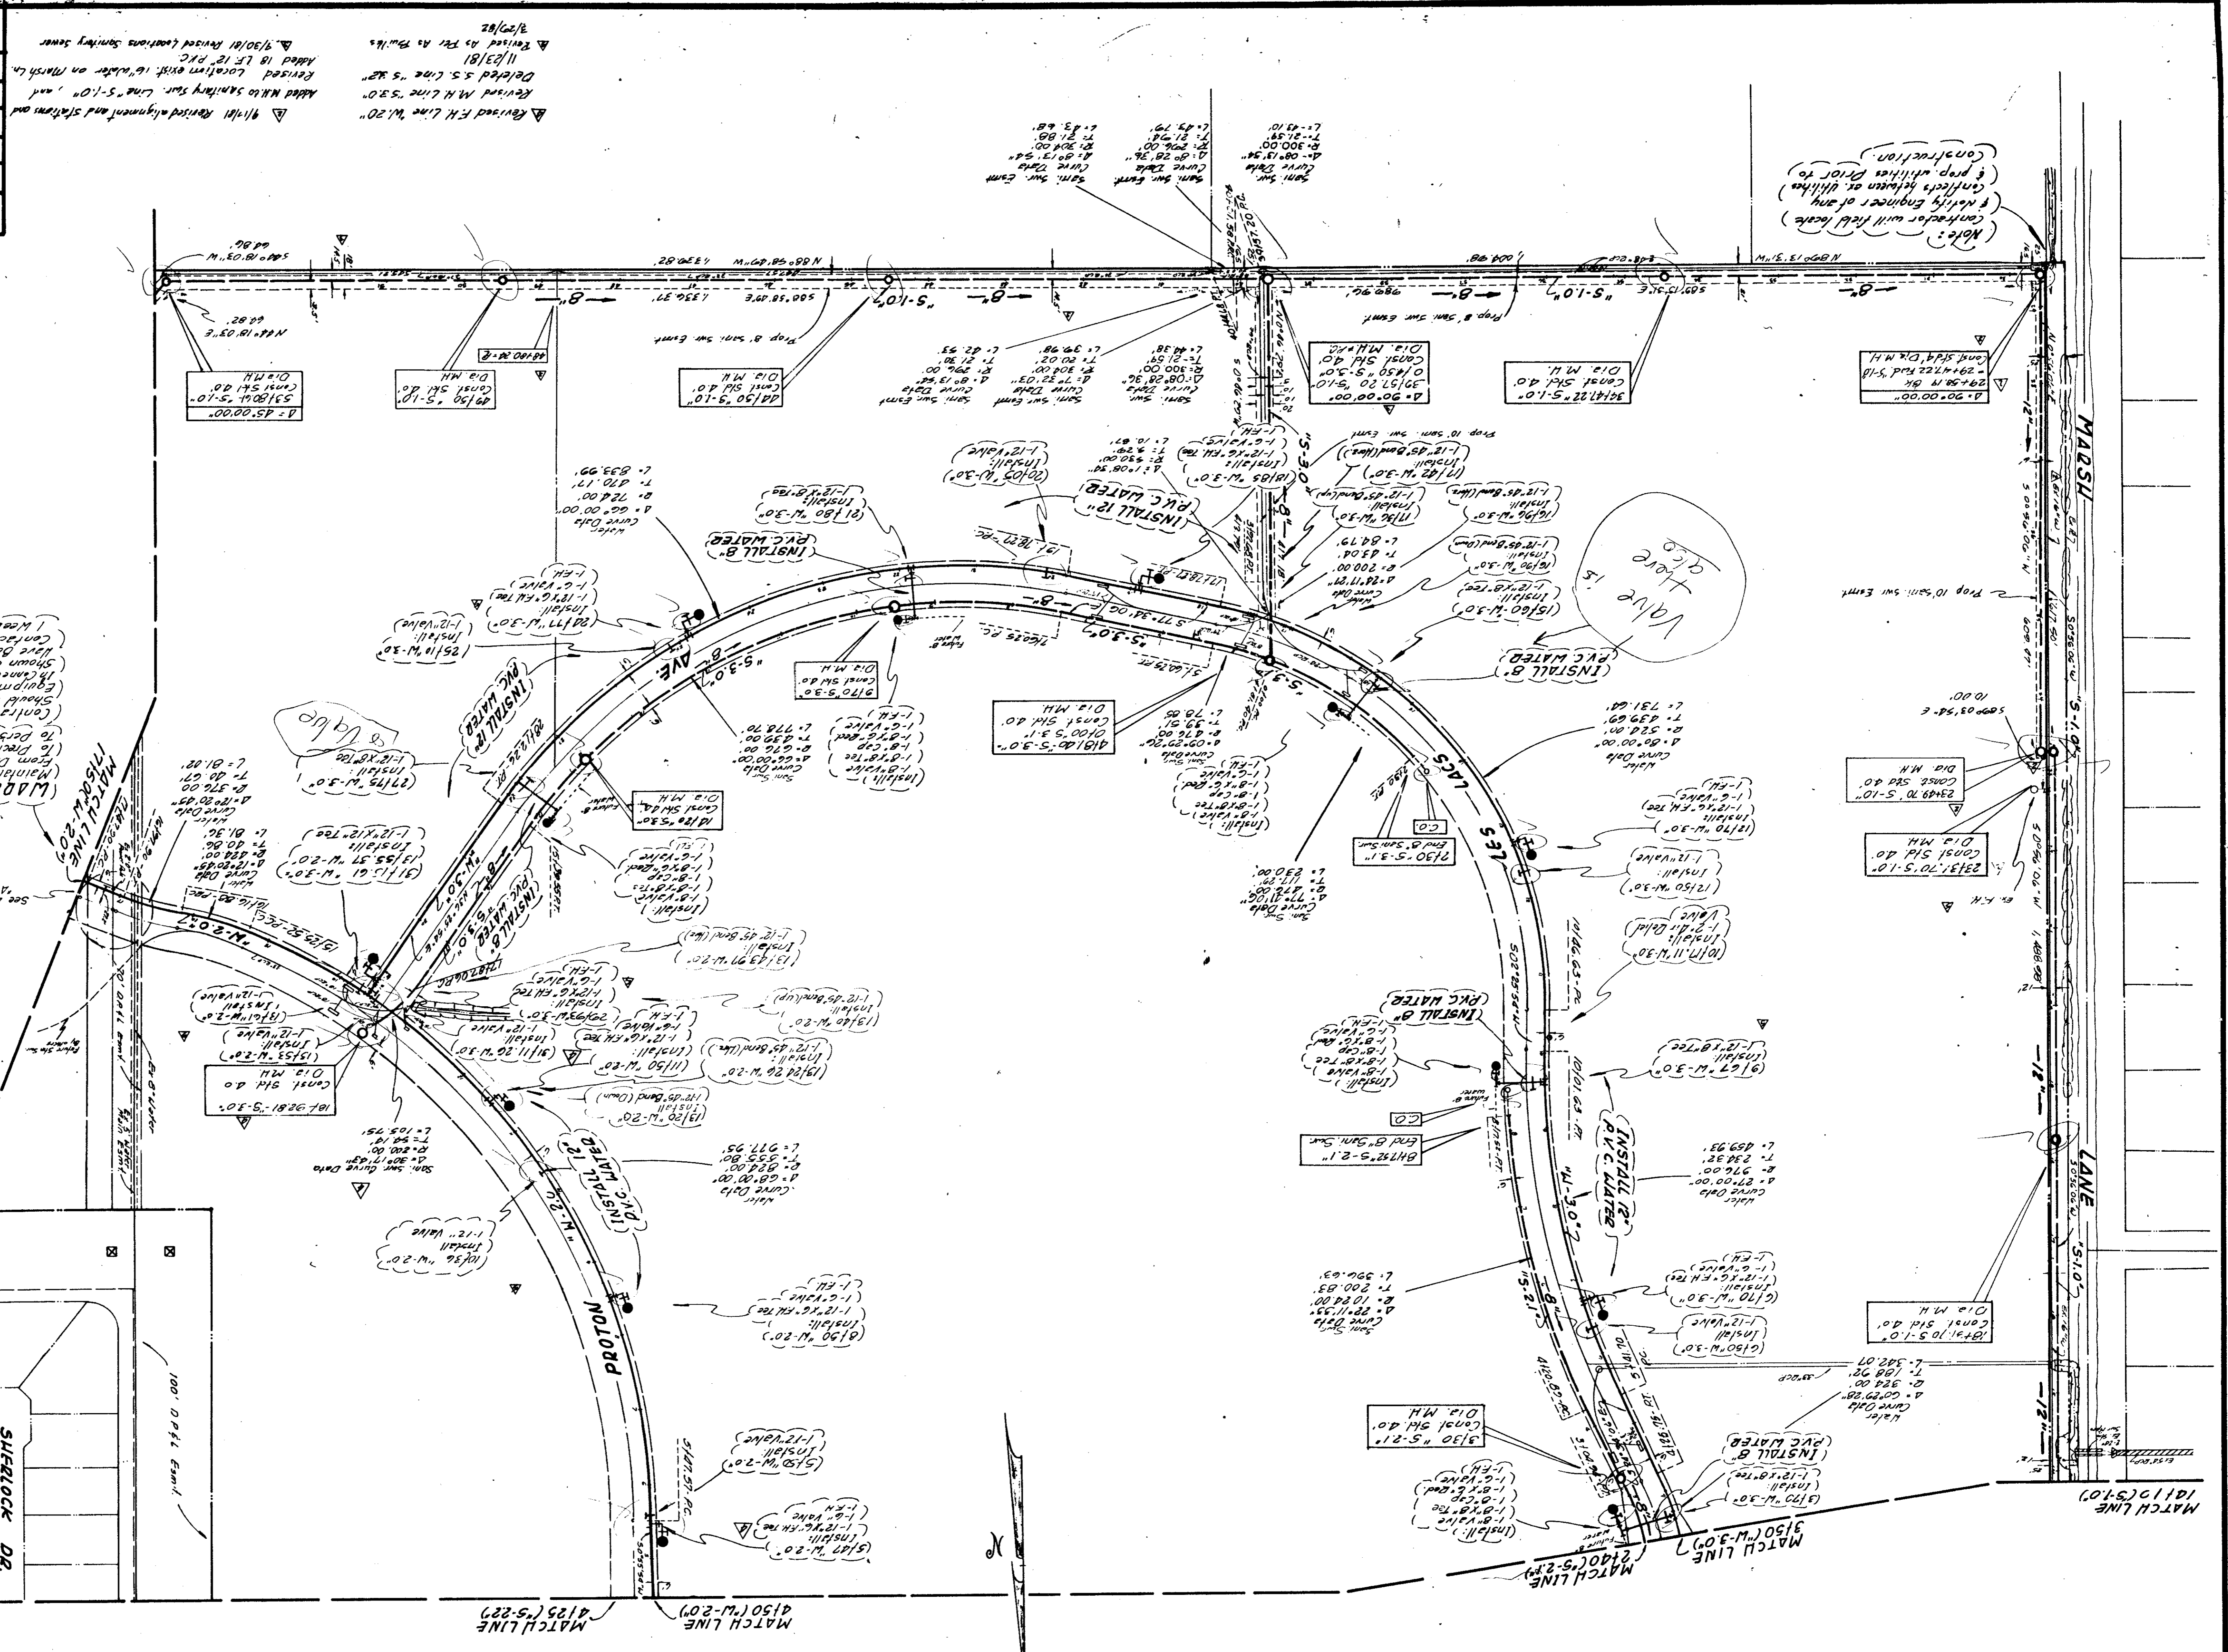

3/29/82

RAYMOND L. GOODSON JR., INC. CONSULTING ENGINEERS
 STATE OF TEXAS
 RAYMOND L. GOODSON JR.
 LICENSE NO. 51932

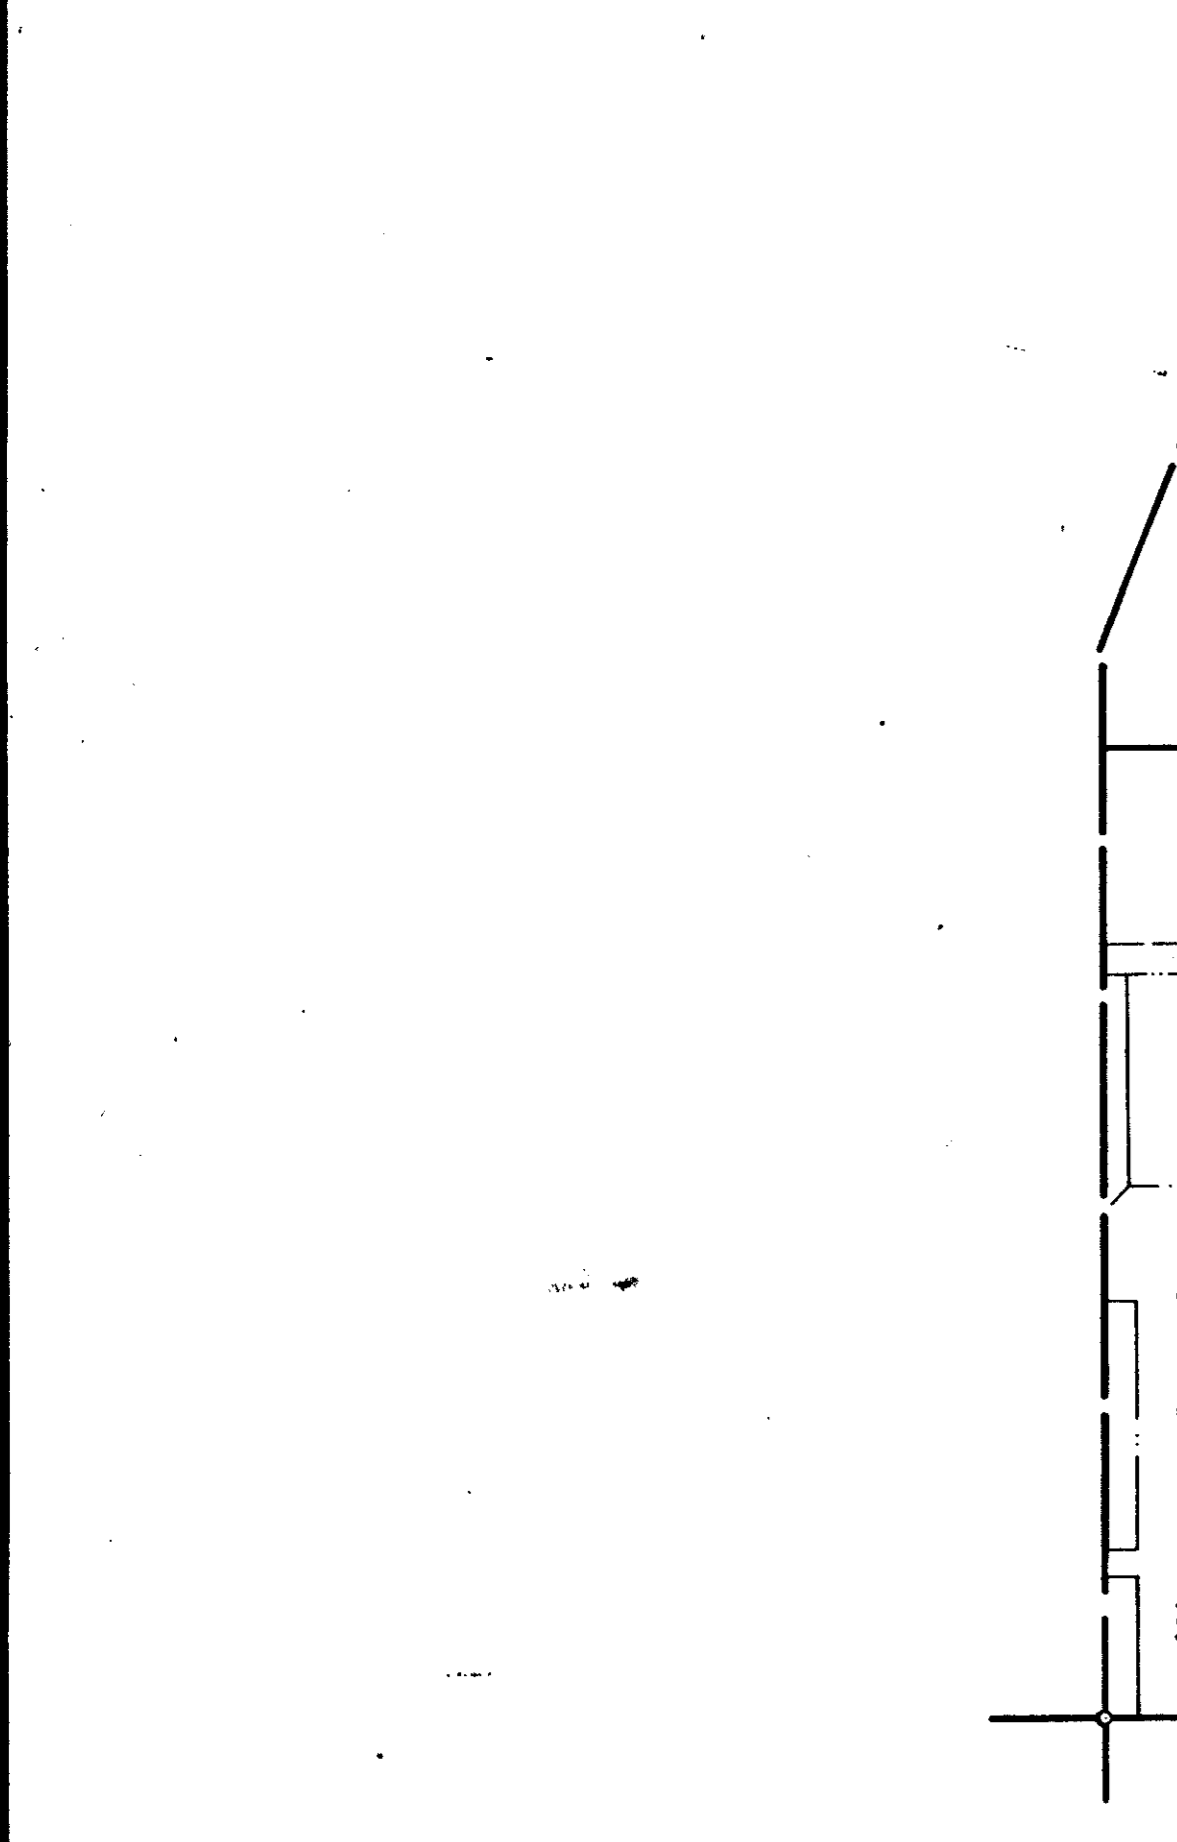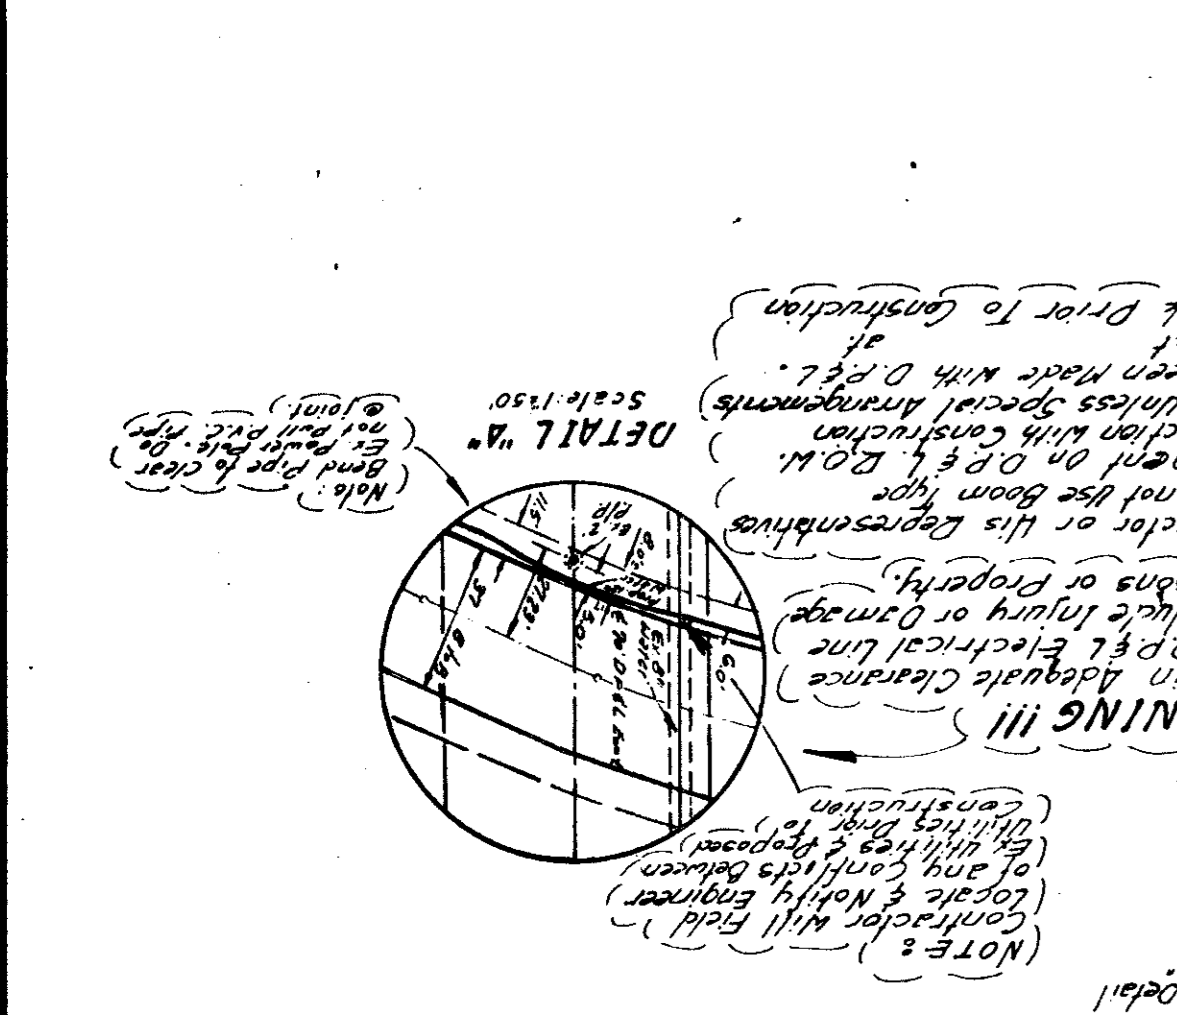

3/29/82

RAYMOND L. GOODSON JR., INC. CONSULTING ENGINEERS
 STATE OF TEXAS
 RAYMOND L. GOODSON JR.
 LICENSE NO. 51932