
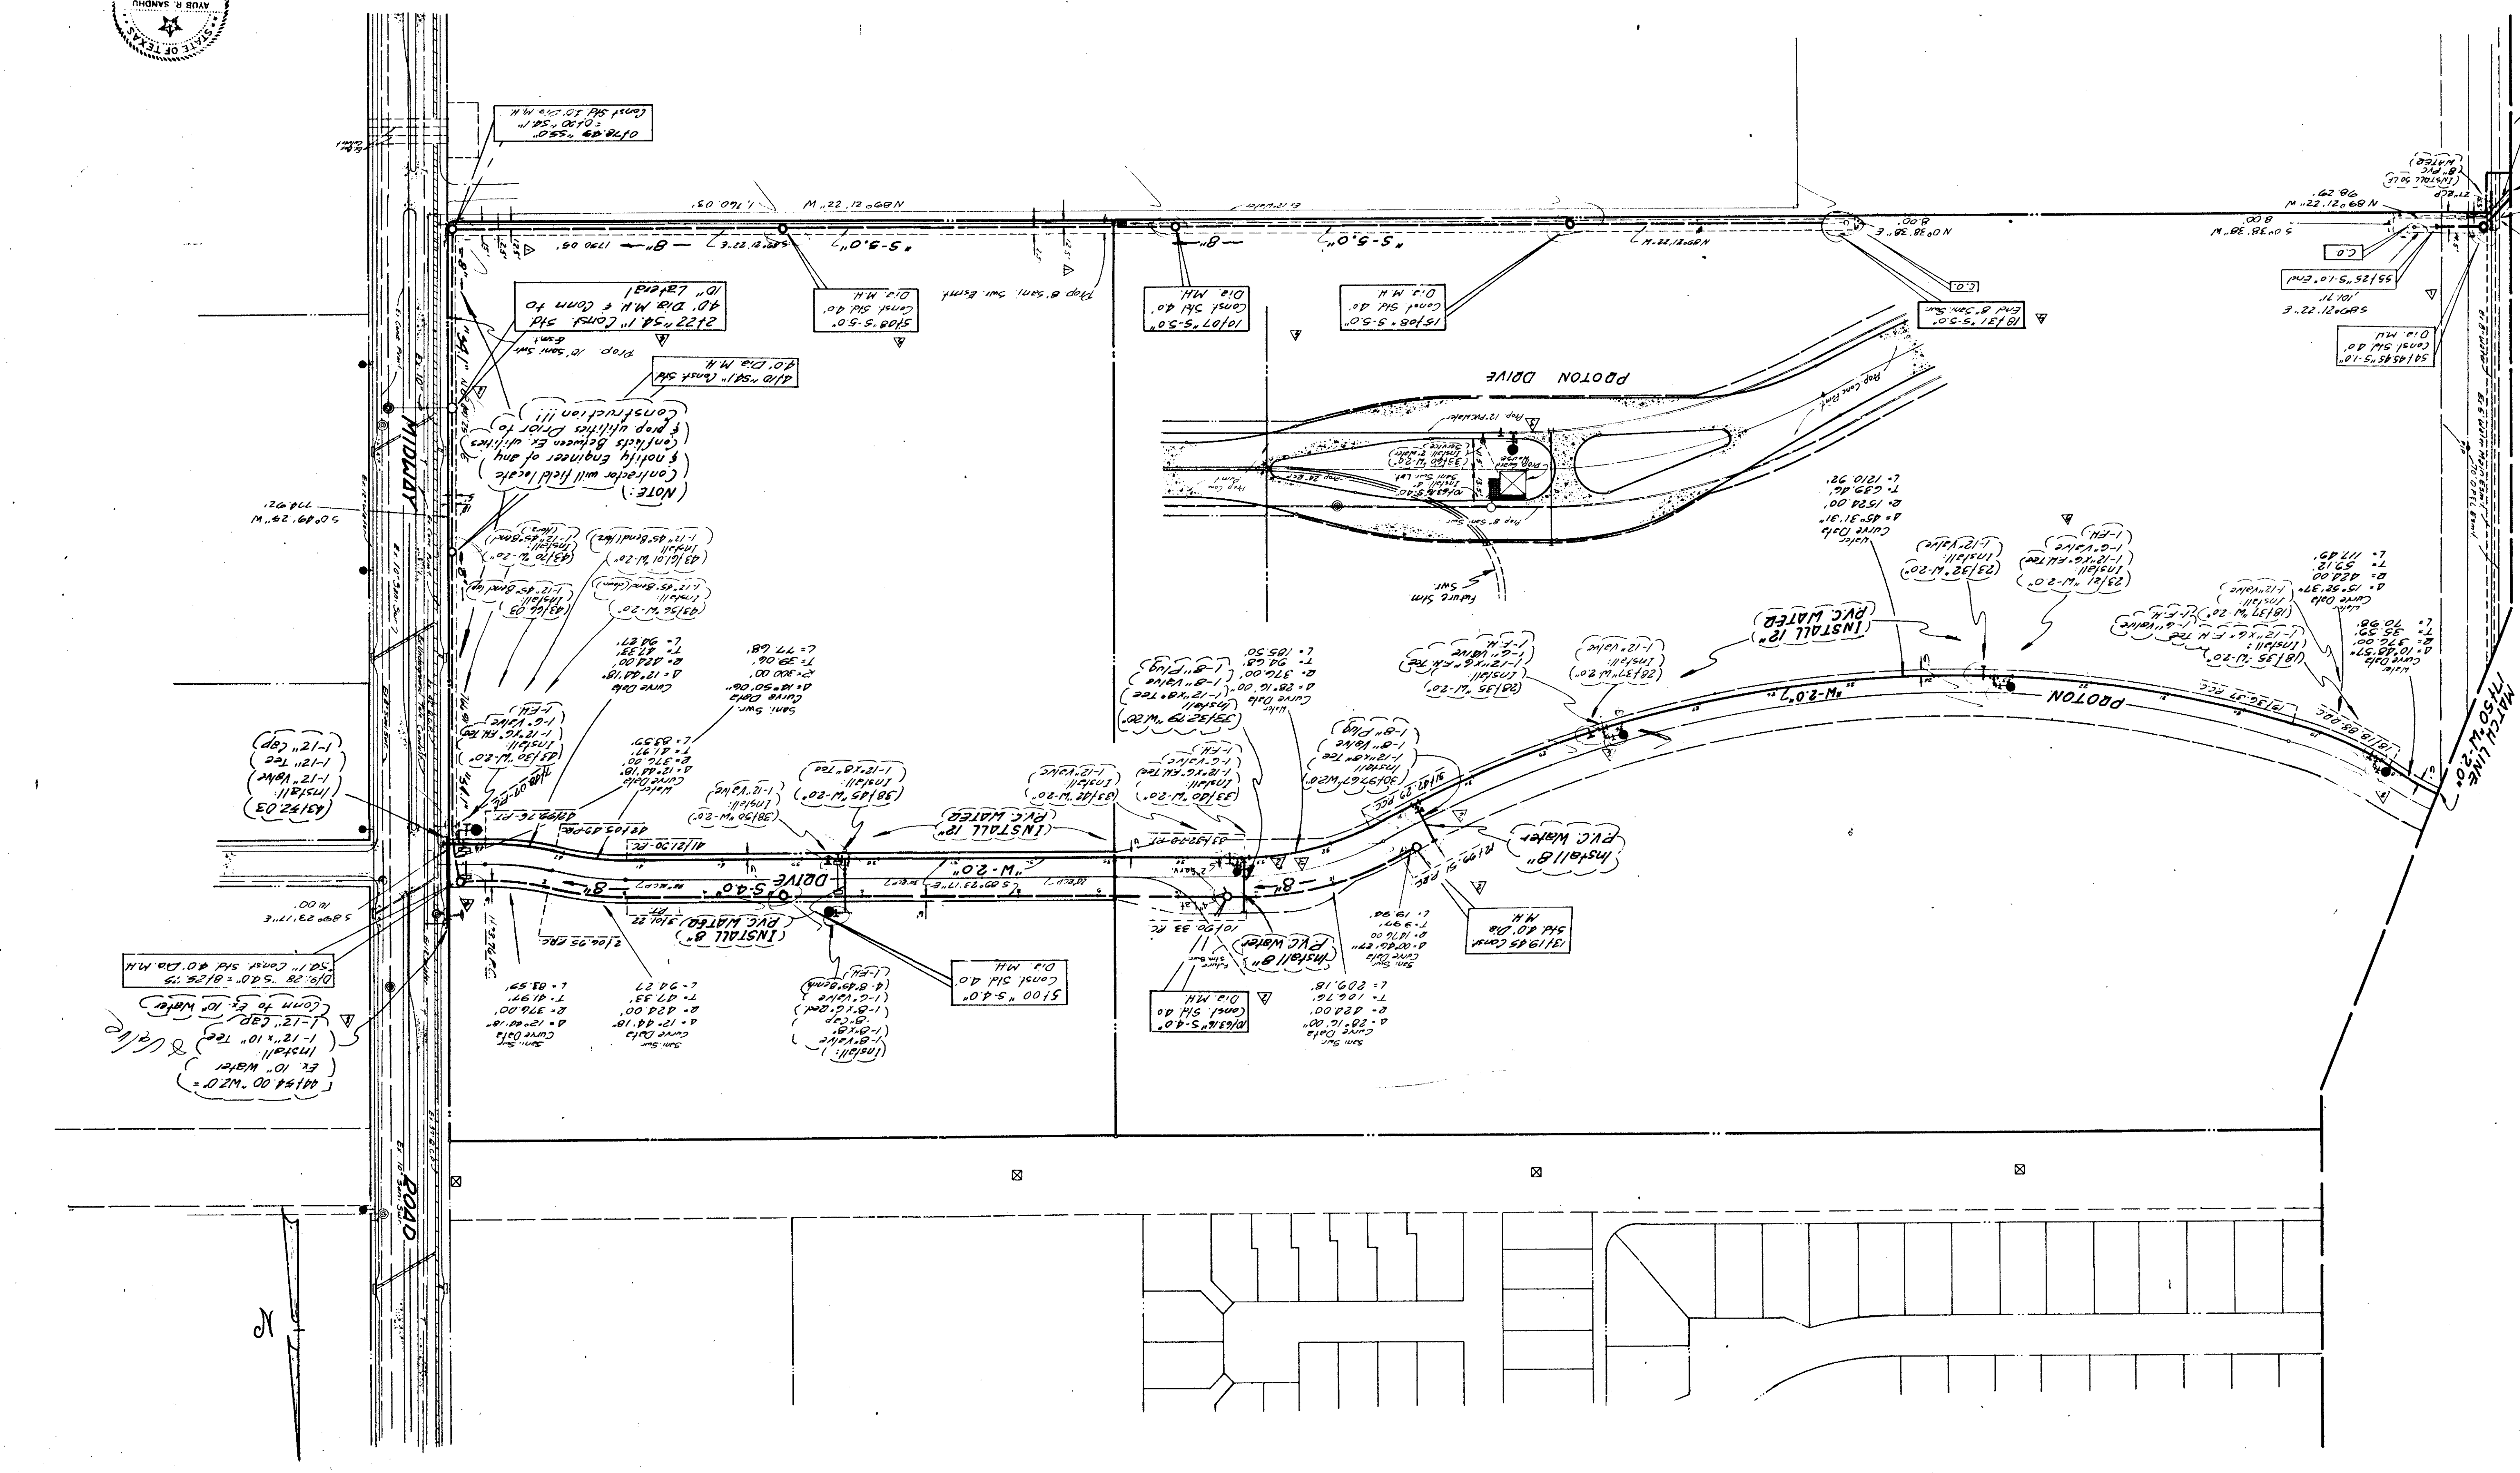


3/29/82 Revised 45' PA in 73'0" to 110'
 10/1/82 Revised 45' PA in 73'0" to 110'
 12/10/81 Revised Guard House 11' x 17'
 Add M.H. 131' x 48"
 Add M.H. 131' x 48"
 11-23-81 Revised 45' PA in 73'0" to 110'
 11-23-81 Revised 45' PA in 73'0" to 110'
 11-23-81 Revised 45' PA in 73'0" to 110'

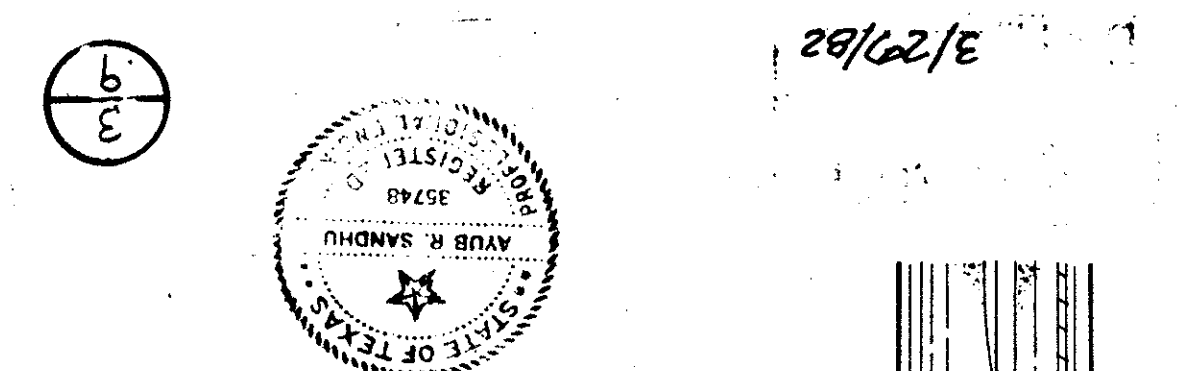

NOTE:
 Conflicts between ex. utilities & prop. utilities prior to construction!!!
 Contractor will field locate & notify engineer of any conflicts between ex. utilities & prop. utilities prior to construction!!!

INSTALL 12" PVC WATER
 INSTALL 8" PVC WATER
 INSTALL 6" PVC WATER
 INSTALL 4" PVC WATER

5'-5.0" DIA. M.H. 40' DIA. M.H. & CONN TO
 10' DIA. M.H. 40' DIA. M.H. & CONN TO
 15' DIA. M.H. 40' DIA. M.H. & CONN TO
 10' DIA. M.H. 40' DIA. M.H. & CONN TO
 15' DIA. M.H. 40' DIA. M.H. & CONN TO
 10' DIA. M.H. 40' DIA. M.H. & CONN TO

MIDWAY ROAD
 PROTON DRIVE
 MATCH LINE
 1750' W. 20'