
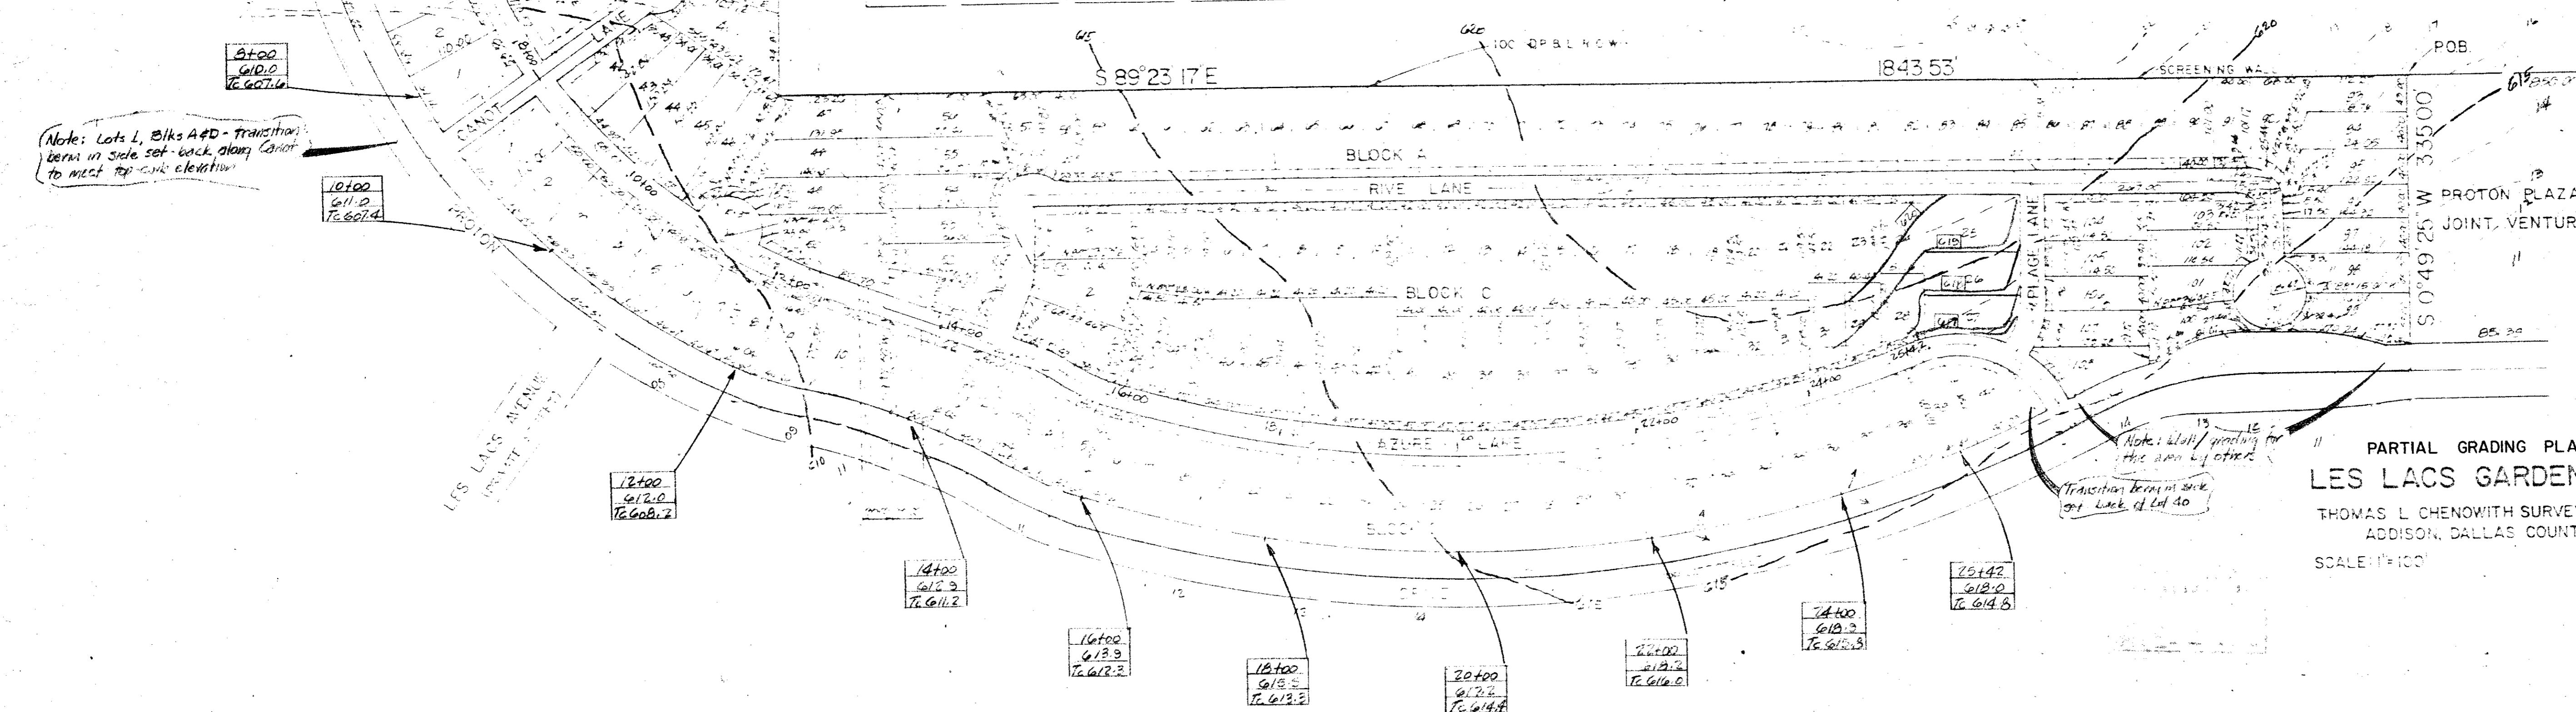
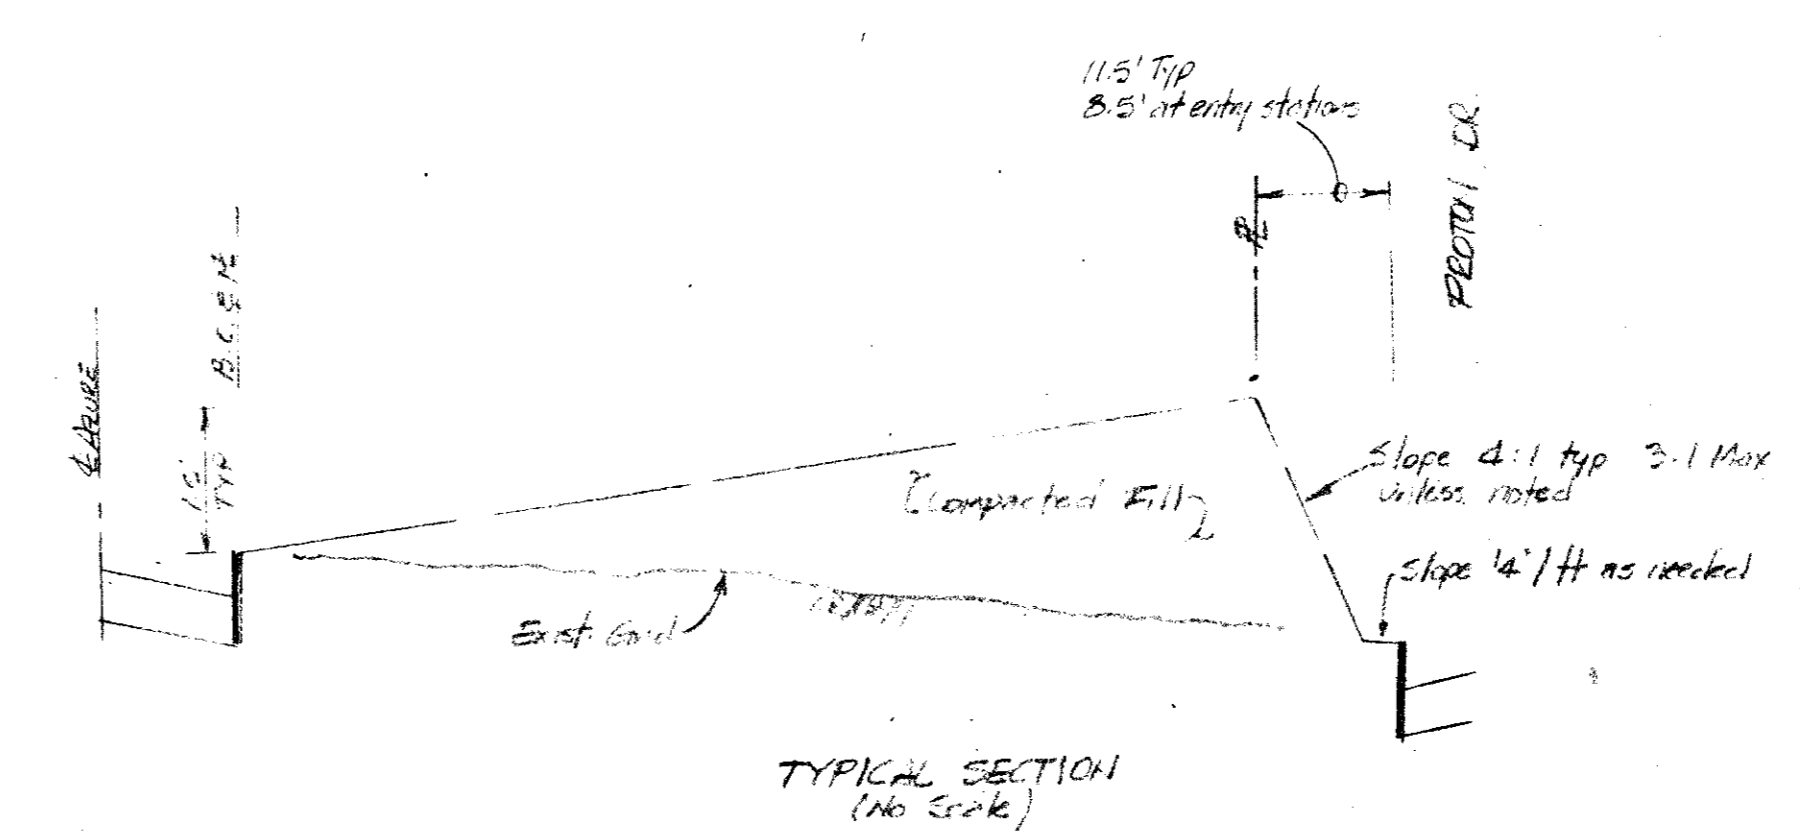
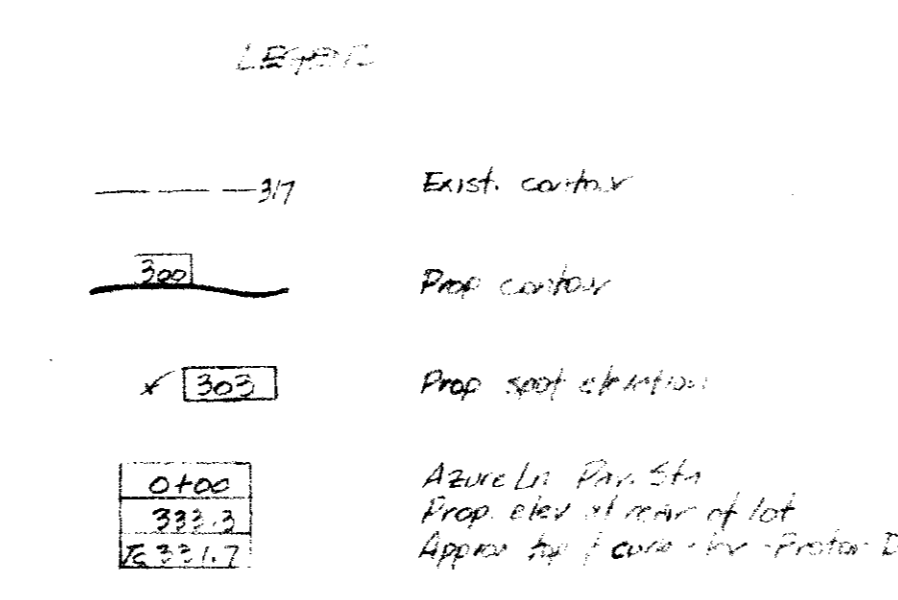


NOTES

- Grading shown hereon is for the following areas:
 Lots 1 - 21, Blk A
 Lots 9 - 14, Blk B
 Lots 25 - 27, Blk C
 All of Blk D
- The placement of material from street or other sources shall be per the Owner's Representative.
- Proposed elevations shown in the above referenced areas of Blocks A and D are located perpendicularly or radially to the indicated center line station of Azure Lane. Reference plans prepared by Hill & Co., Aug. 81 as revised Dec. 81.
- Refer to Les Lacs Village Contract Documents for specifications for the placement, compaction and testing of fill.

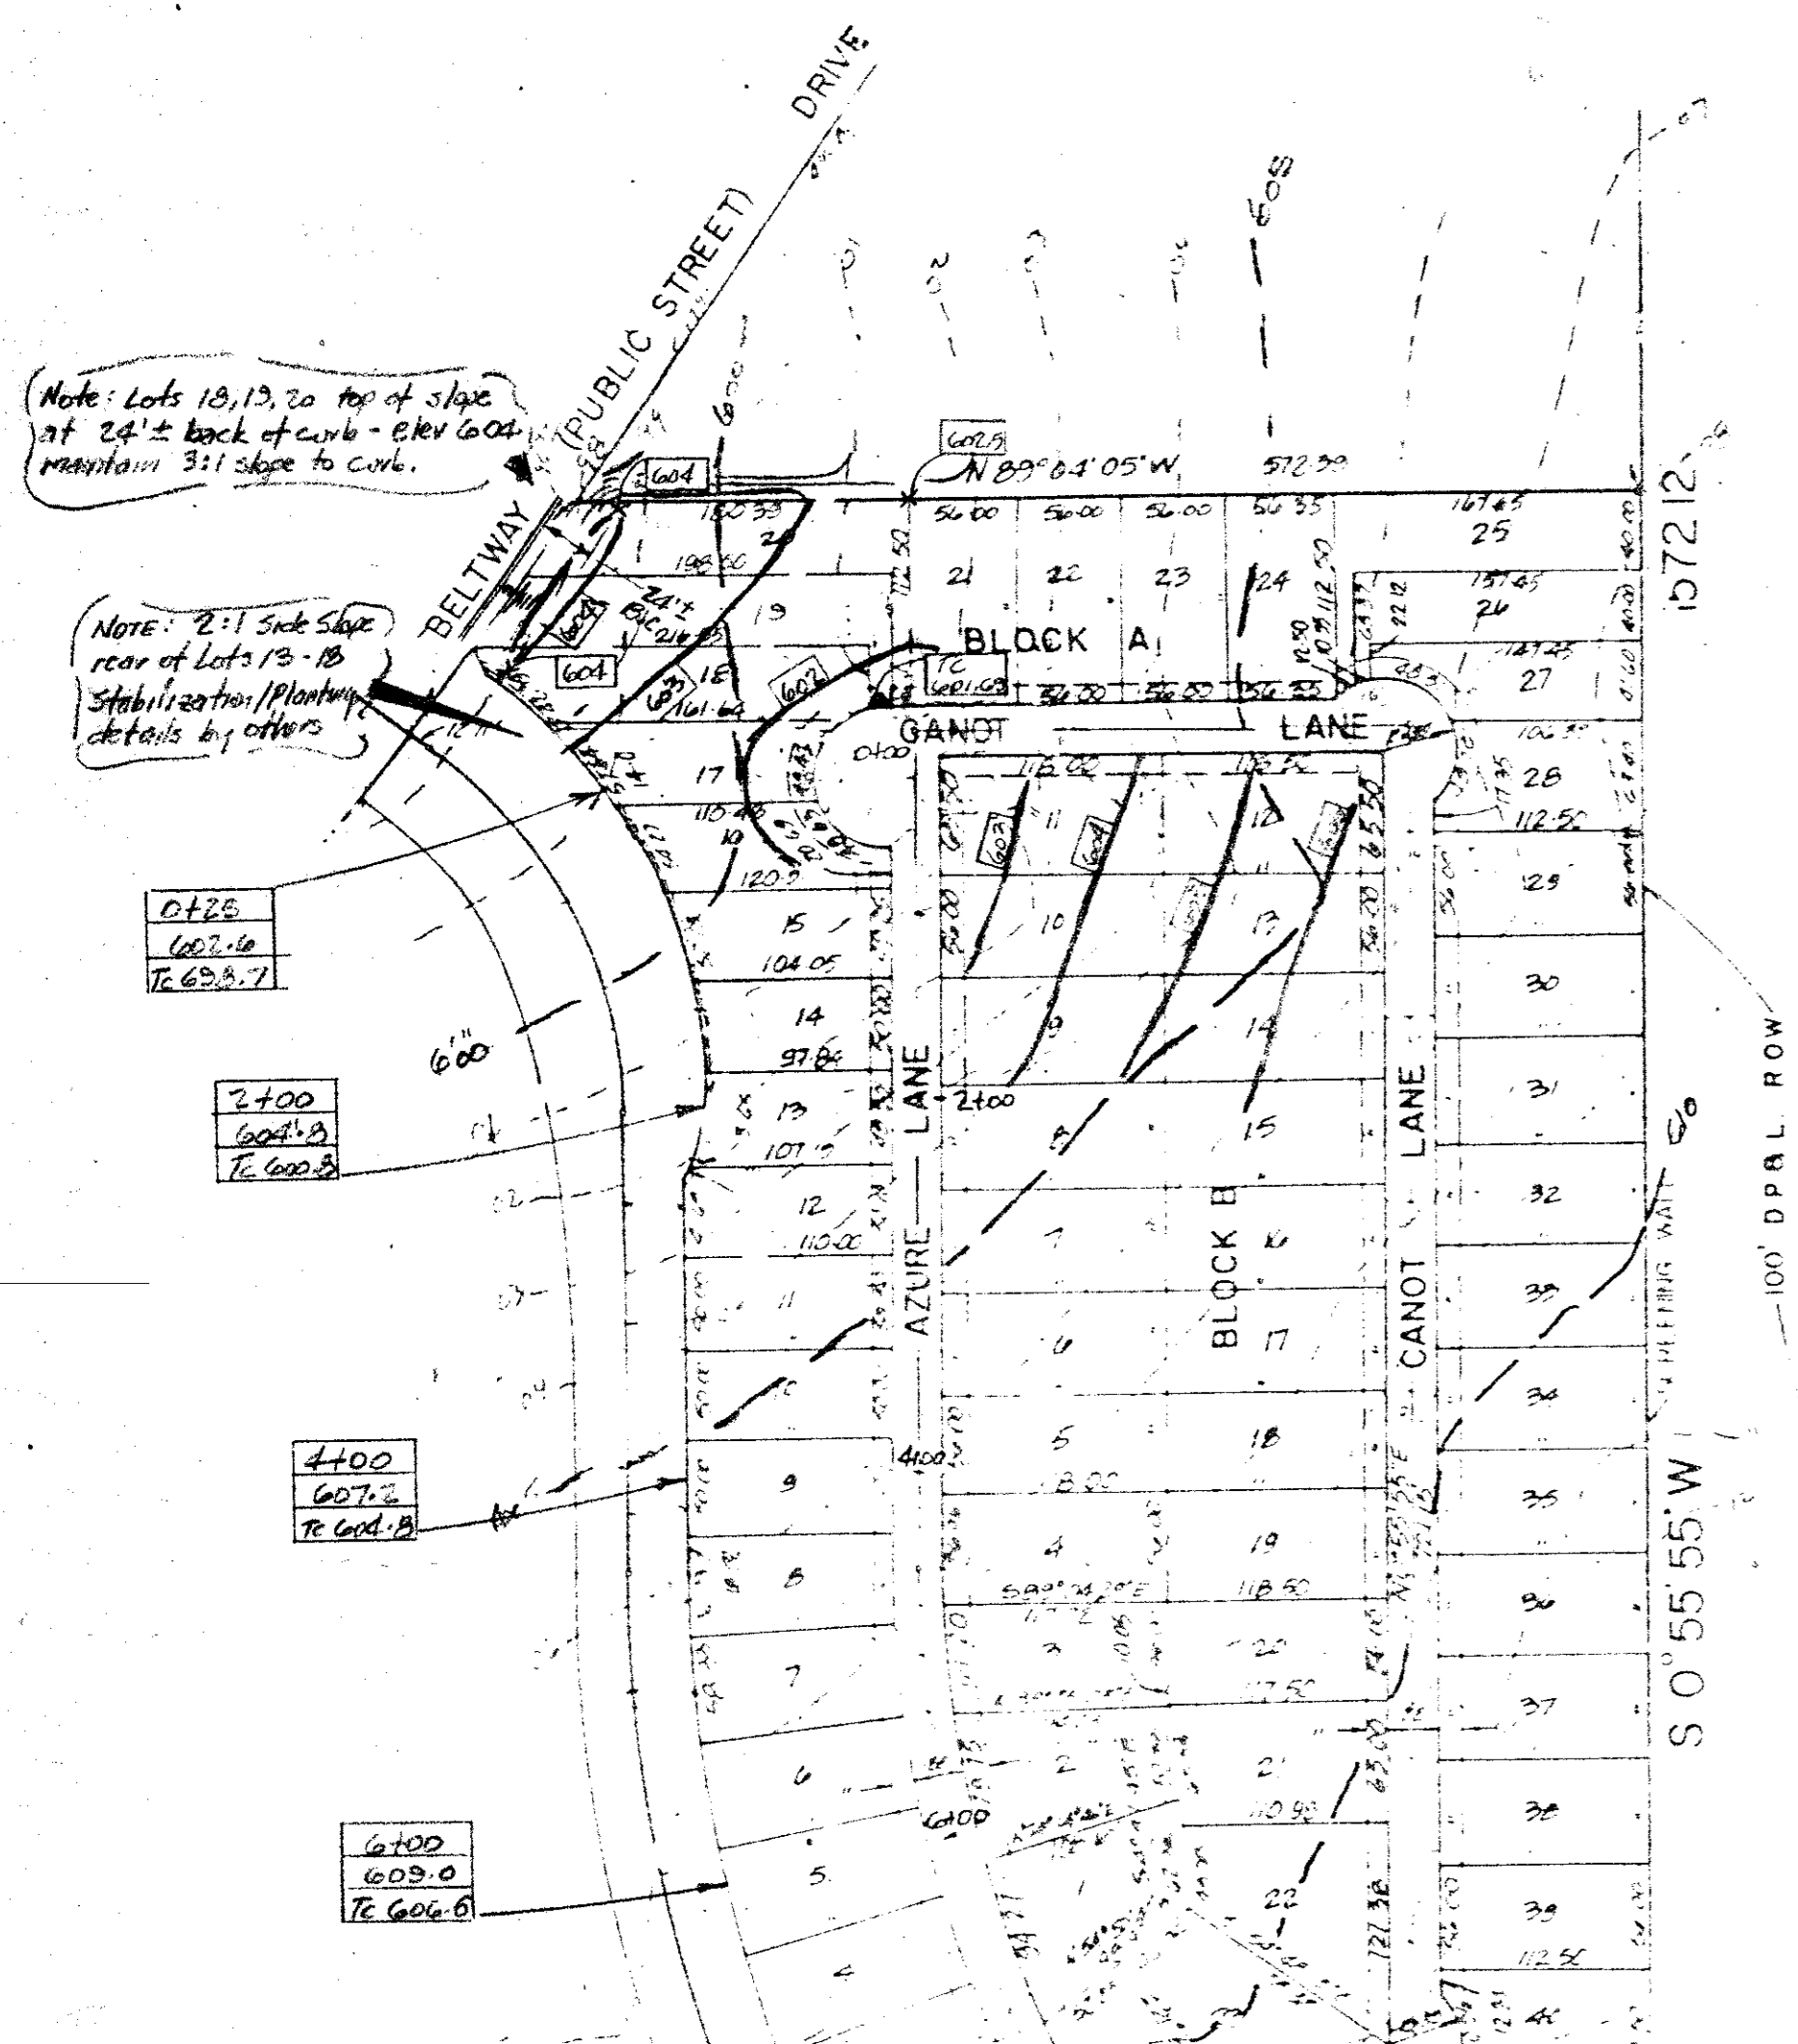

PARTIAL GRADING PLAN
LES LACS GARDEN HOMES
 THOMAS L. CHENOWETH SURVEY, ABS. NO. 273
 ADDISON, DALLAS COUNTY, TEXAS
 SCALE: 1"=100' 12/8/81

AS BUILT
 DATE 5-6-82