


DATE	
BY	
CHECKED	
DESIGNED	
PLANNED	
NOTED	
NO.	

DATE	
BY	
CHECKED	
DESIGNED	
PLANNED	
NOTED	
NO.	


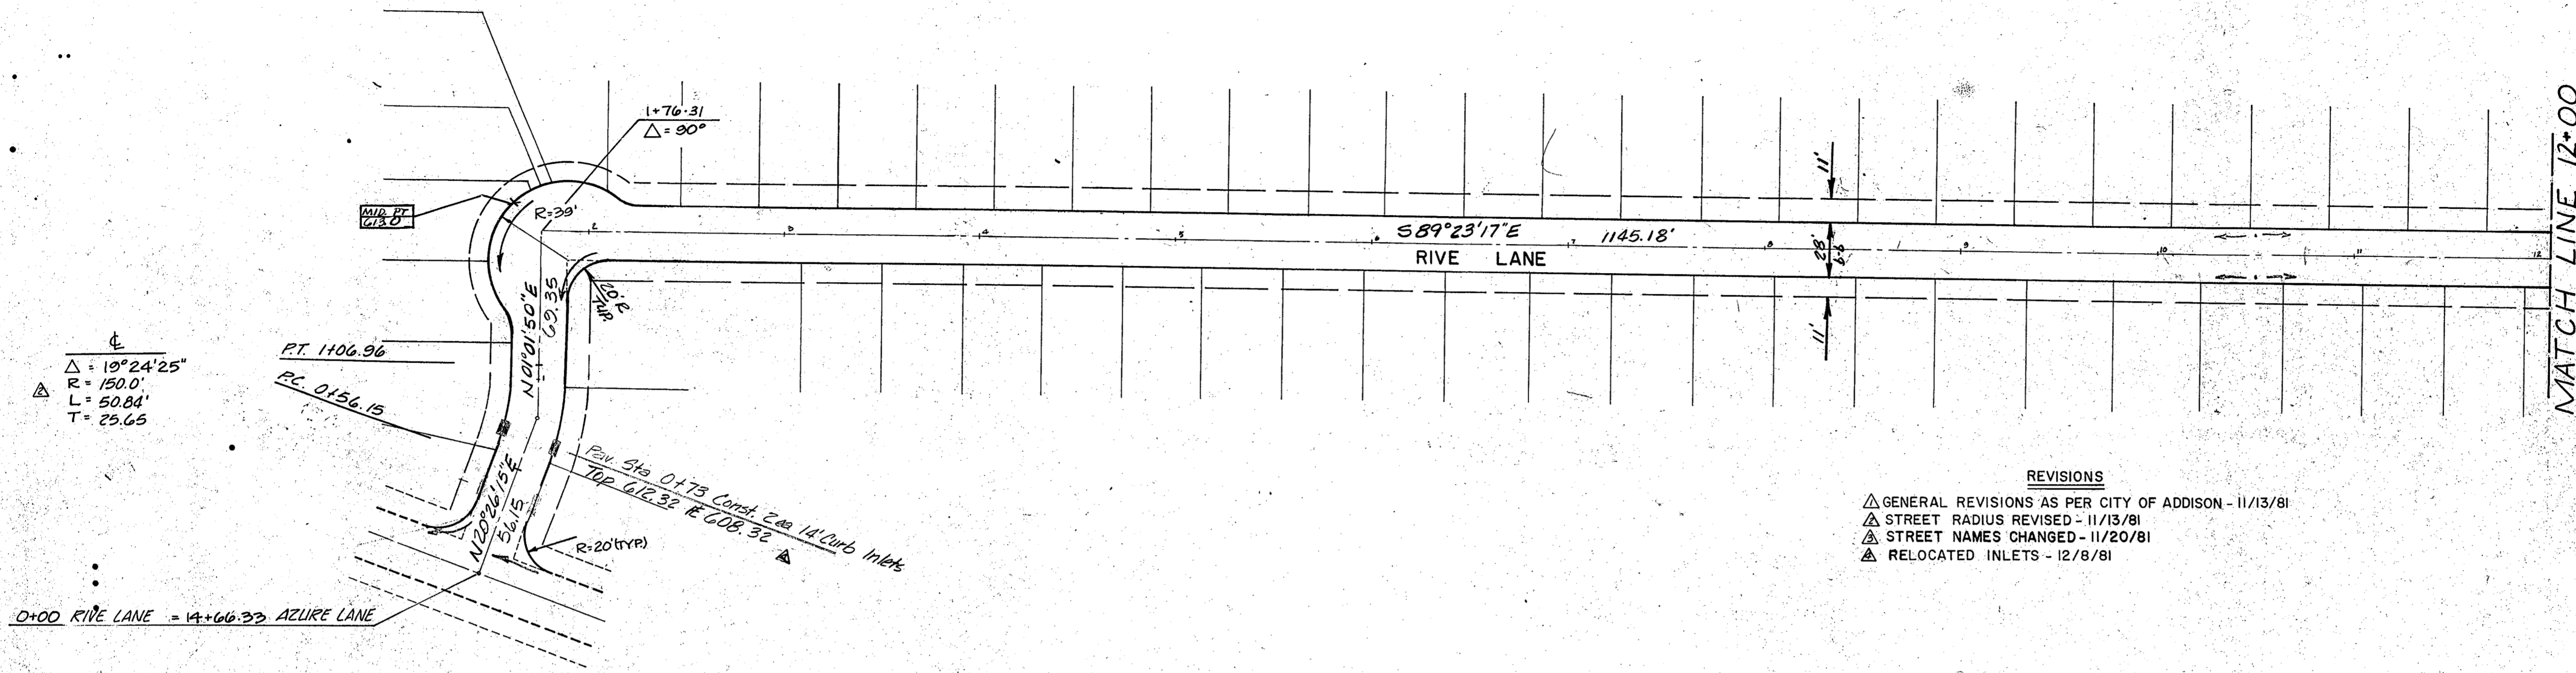


$\Delta = 19^\circ 24' 25''$
 $R = 150.0'$
 $L = 50.84'$
 $T = 25.65$

- REVISIONS**
- △ GENERAL REVISIONS AS PER CITY OF ADDISON - 11/13/81
 - △ STREET RADIUS REVISED - 11/13/81
 - △ STREET NAMES CHANGED - 11/20/81
 - △ RELOCATED INLETS - 12/8/81

NOTE: ALL DIMENSIONS ARE TO BACK-OF CURB UNLESS OTHERWISE NOTED.

- BENCH-MARKS**
1. "□" Cut top of conc. footing at Northwest cor. Tower #12N-3W-T288
ELEV. 605.20
 2. "□" Cut top of conc. footing at Northwest cor. Tower #12N-3W-T290
located at the angle point of the line
ELEV. 613.16
 3. "□" Cut top of conc. footing at Southwest cor. Tower #12N-3W-T291
ELEV. 619.46

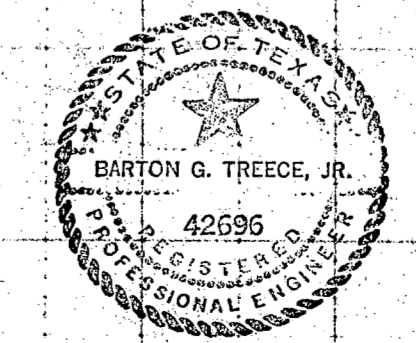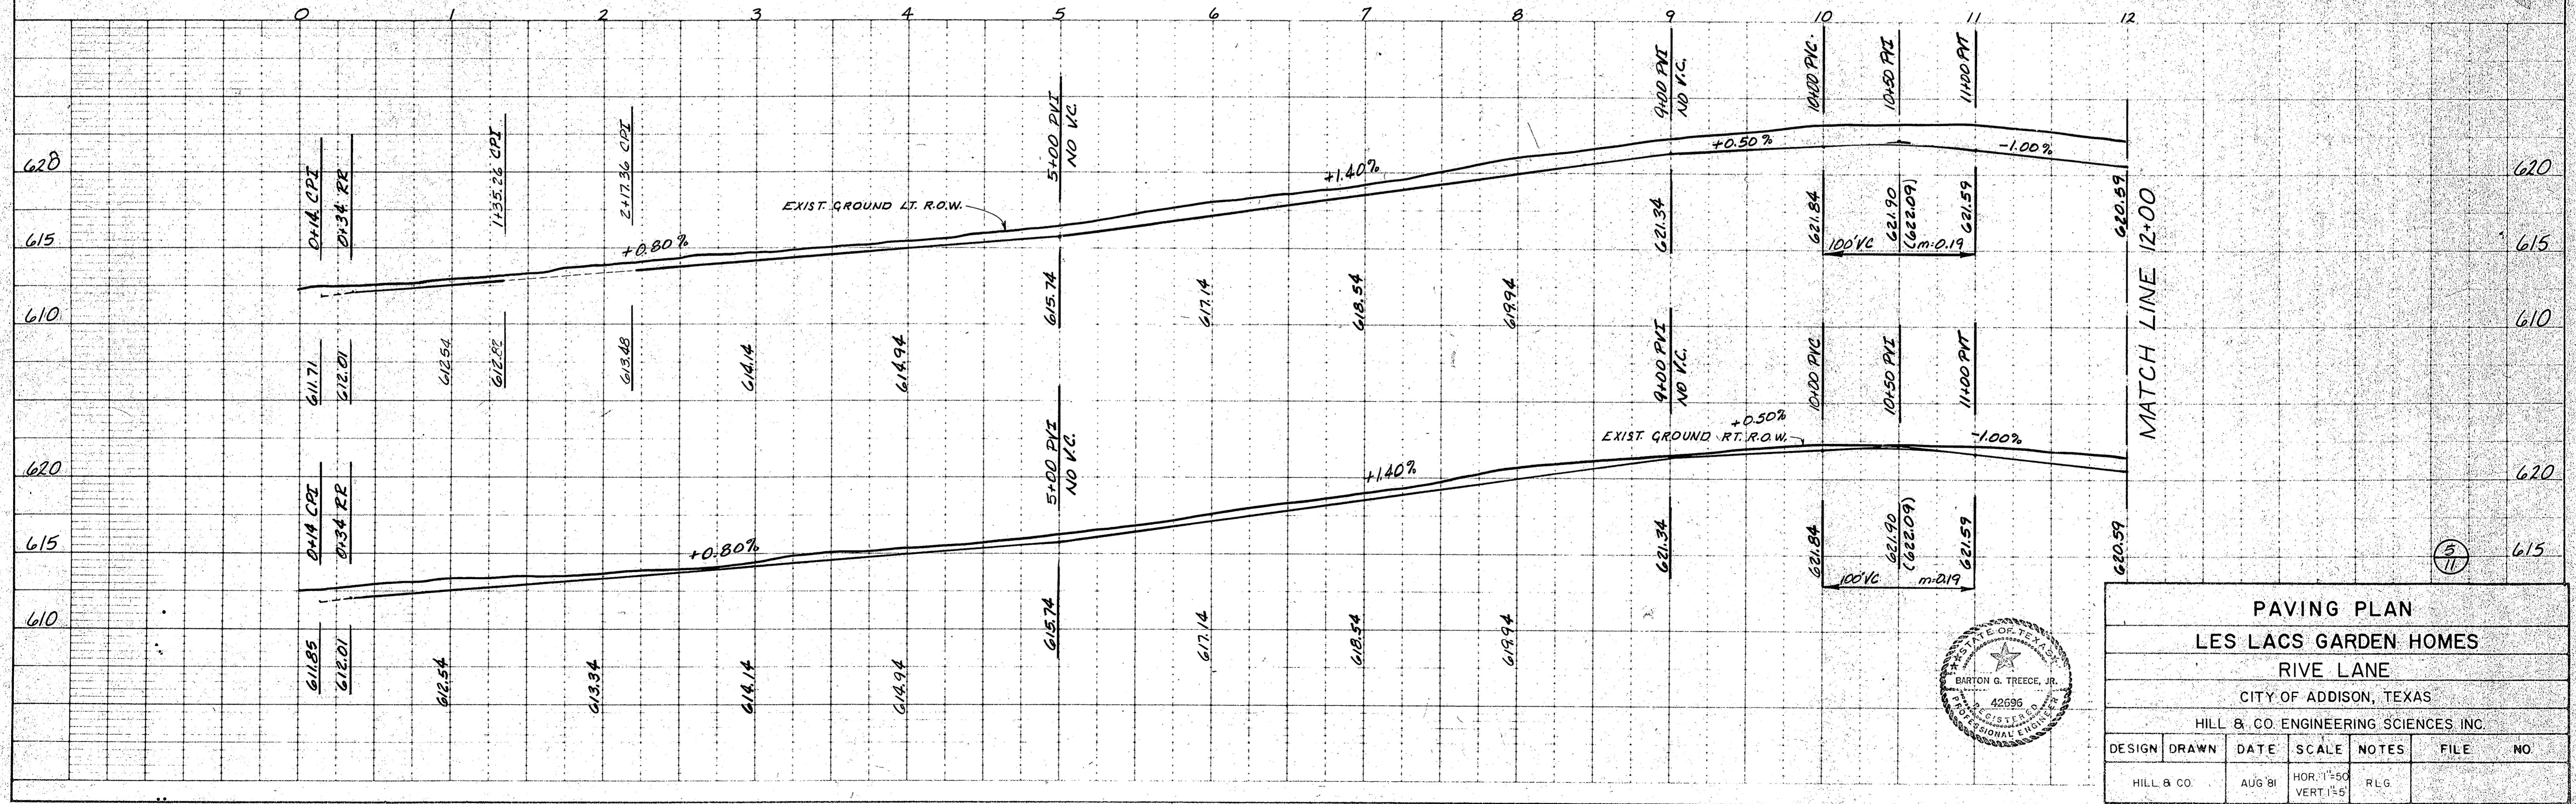

PAVING PLAN					
LES LACS GARDEN HOMES					
RIVE LANE					
CITY OF ADDISON, TEXAS					
HILL & CO ENGINEERING SCIENCES INC.					
DESIGN	DRAWN	DATE	SCALE	NOTES	FILE NO
HILL & CO.		AUG '81	HOR. 1"=50' VERT. 1"=5'	RLG	

STREET P. 0+00 TO 12+00