

REVISIONS




- ▲ GENERAL REVISIONS AS PER CITY OF ADDISON - 11/13/81
- ▲ STREET NAME CHANGES - 11/20/81
- ▲ 10" STORM SEWER & SANITARY SEWER EASEMENT CHANGED TO A 5" STORM SEWER EASEMENT. 11/30/81
- ▲ ADDITION OF 10" INLET (12/07/81)
- ▲ RELOCATE INLETS (12/07/81)
- ▲ REVISE DRAINAGE PLAN (12/07/81)

Contractor should not use boom type equipment in T.P.L. Easement in Connection With Construction Unless Special Arrangements Have Been Made With T.P.L. One Week Prior To Construction.

CAUTION! Maintain Adequate Clearance From T.P.L. Electrical Lines To Avoid Injury Or Damage To Persons Or Property.


Note: 33" RCP per R.L. Goodson plans. Headwall to be omitted.

CAUTION! Existing 8" Water (Depth Unknown)

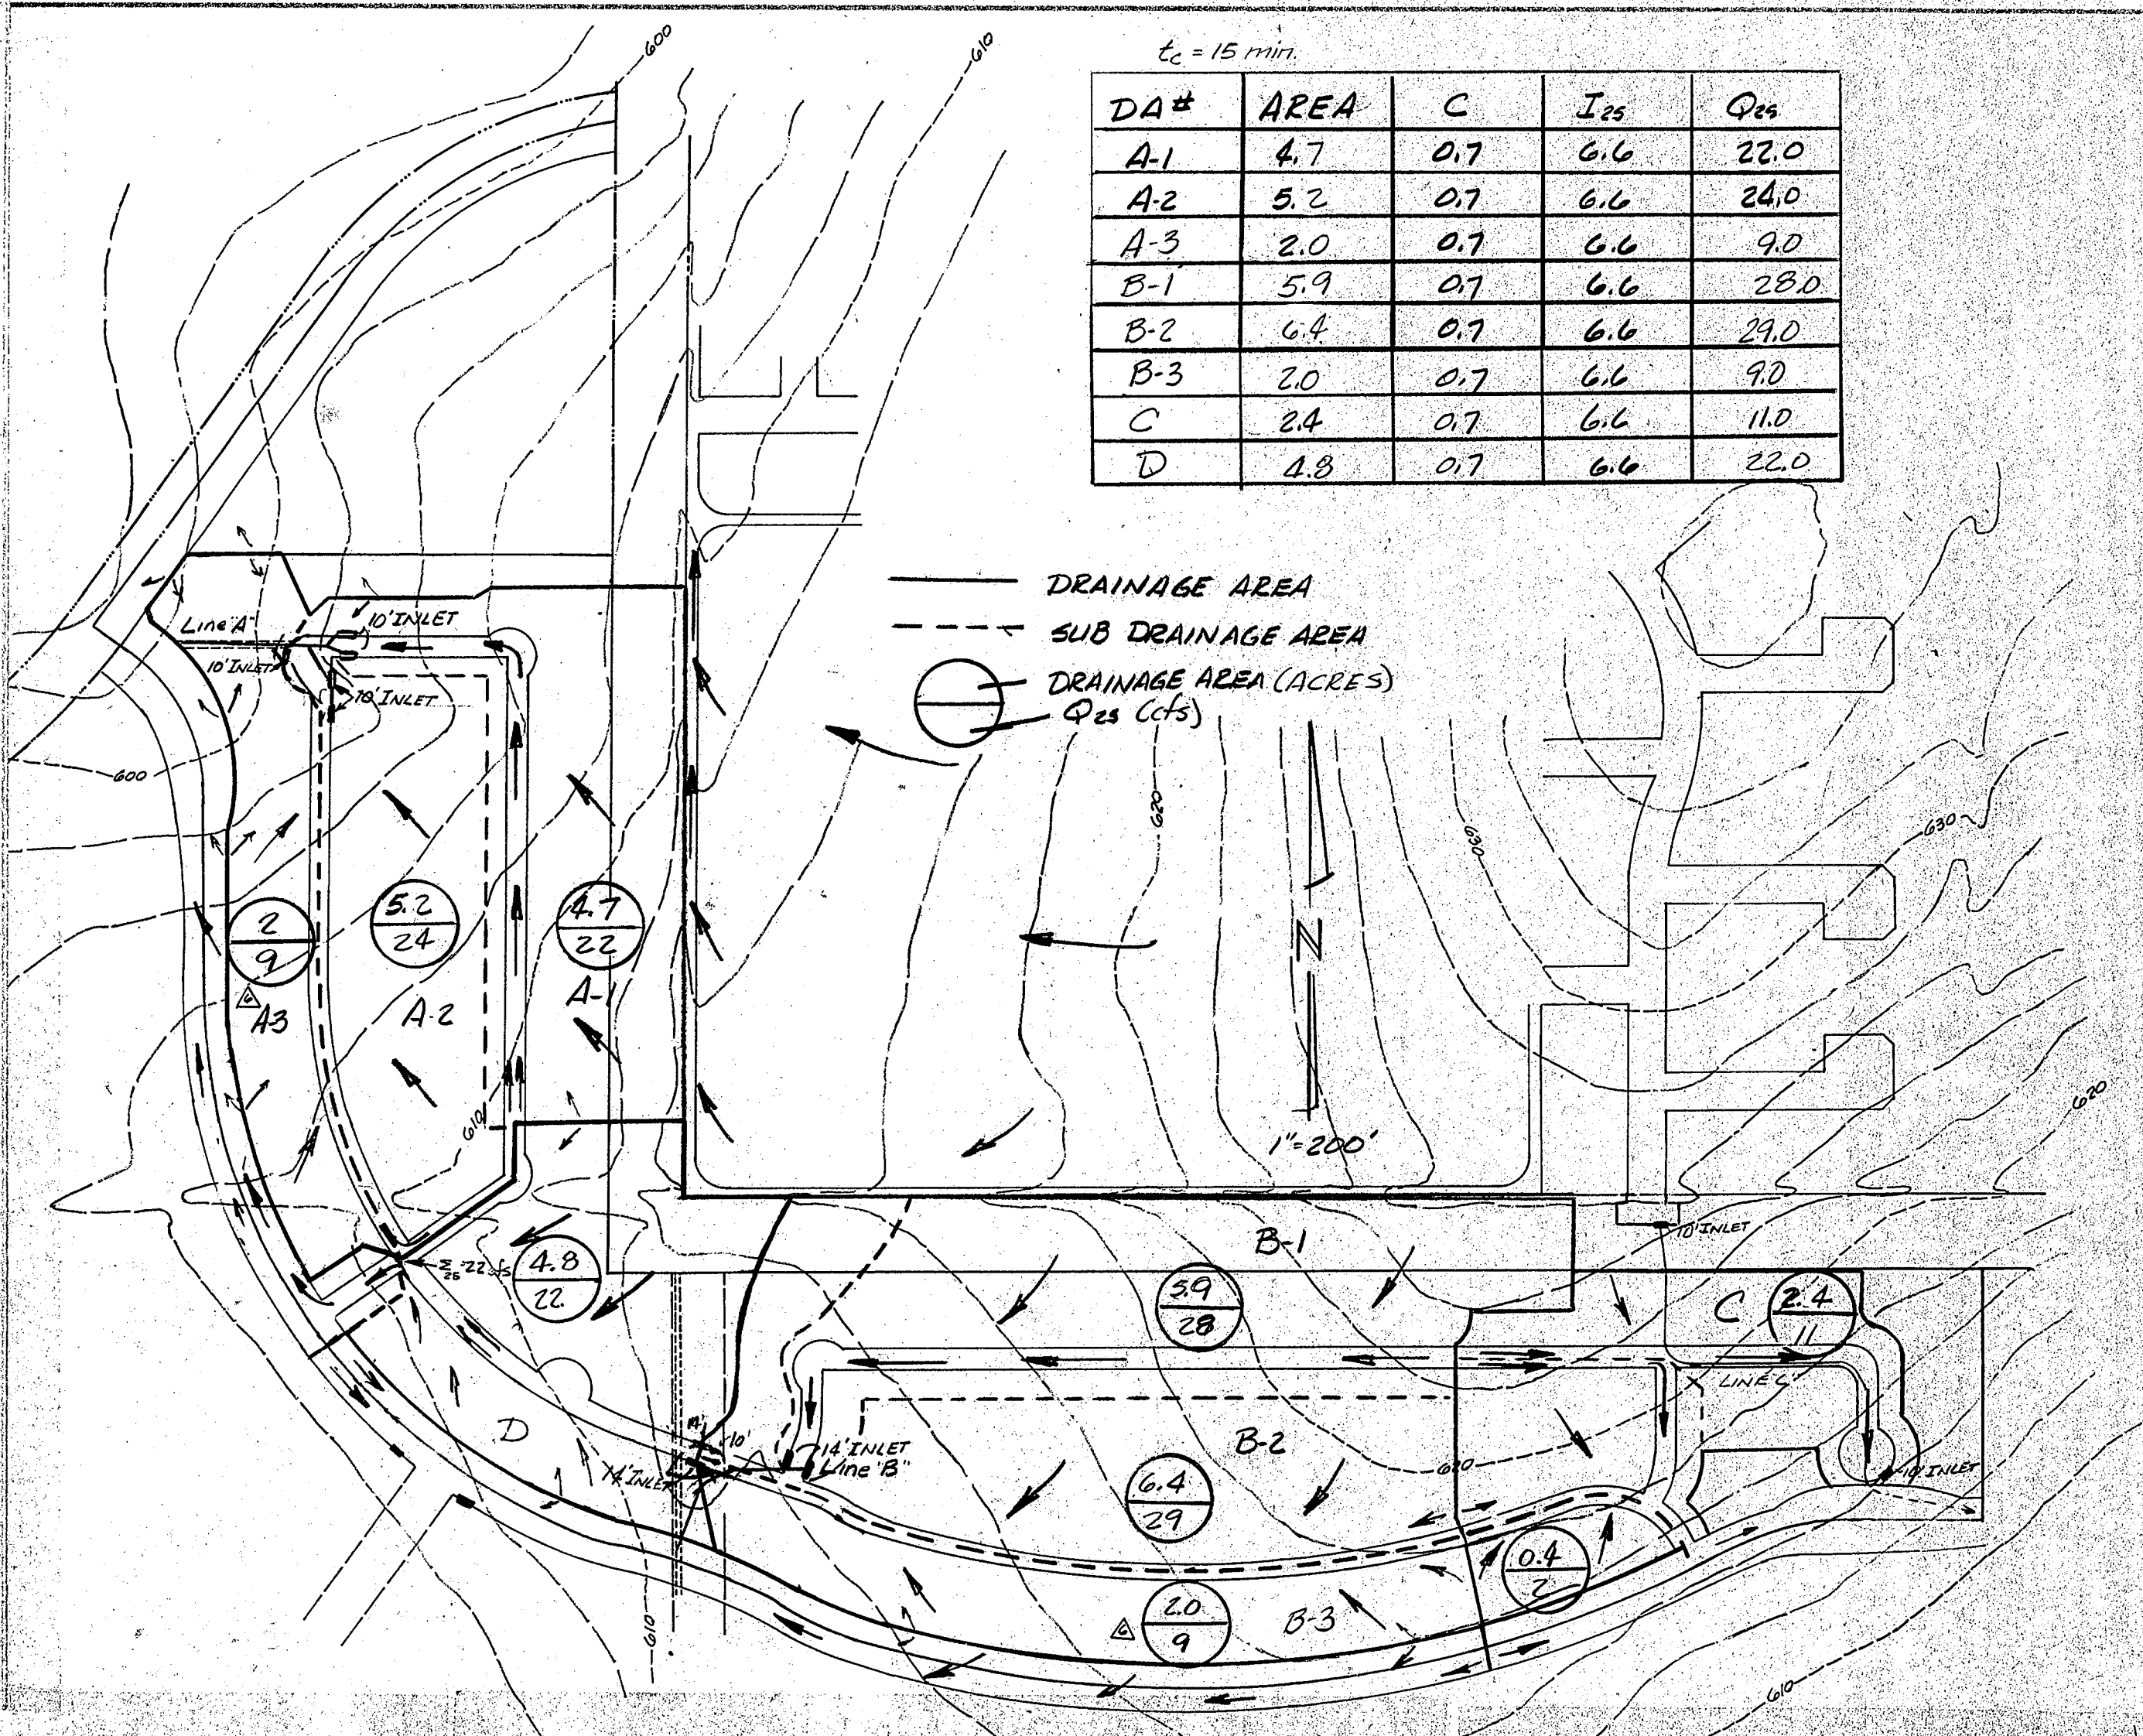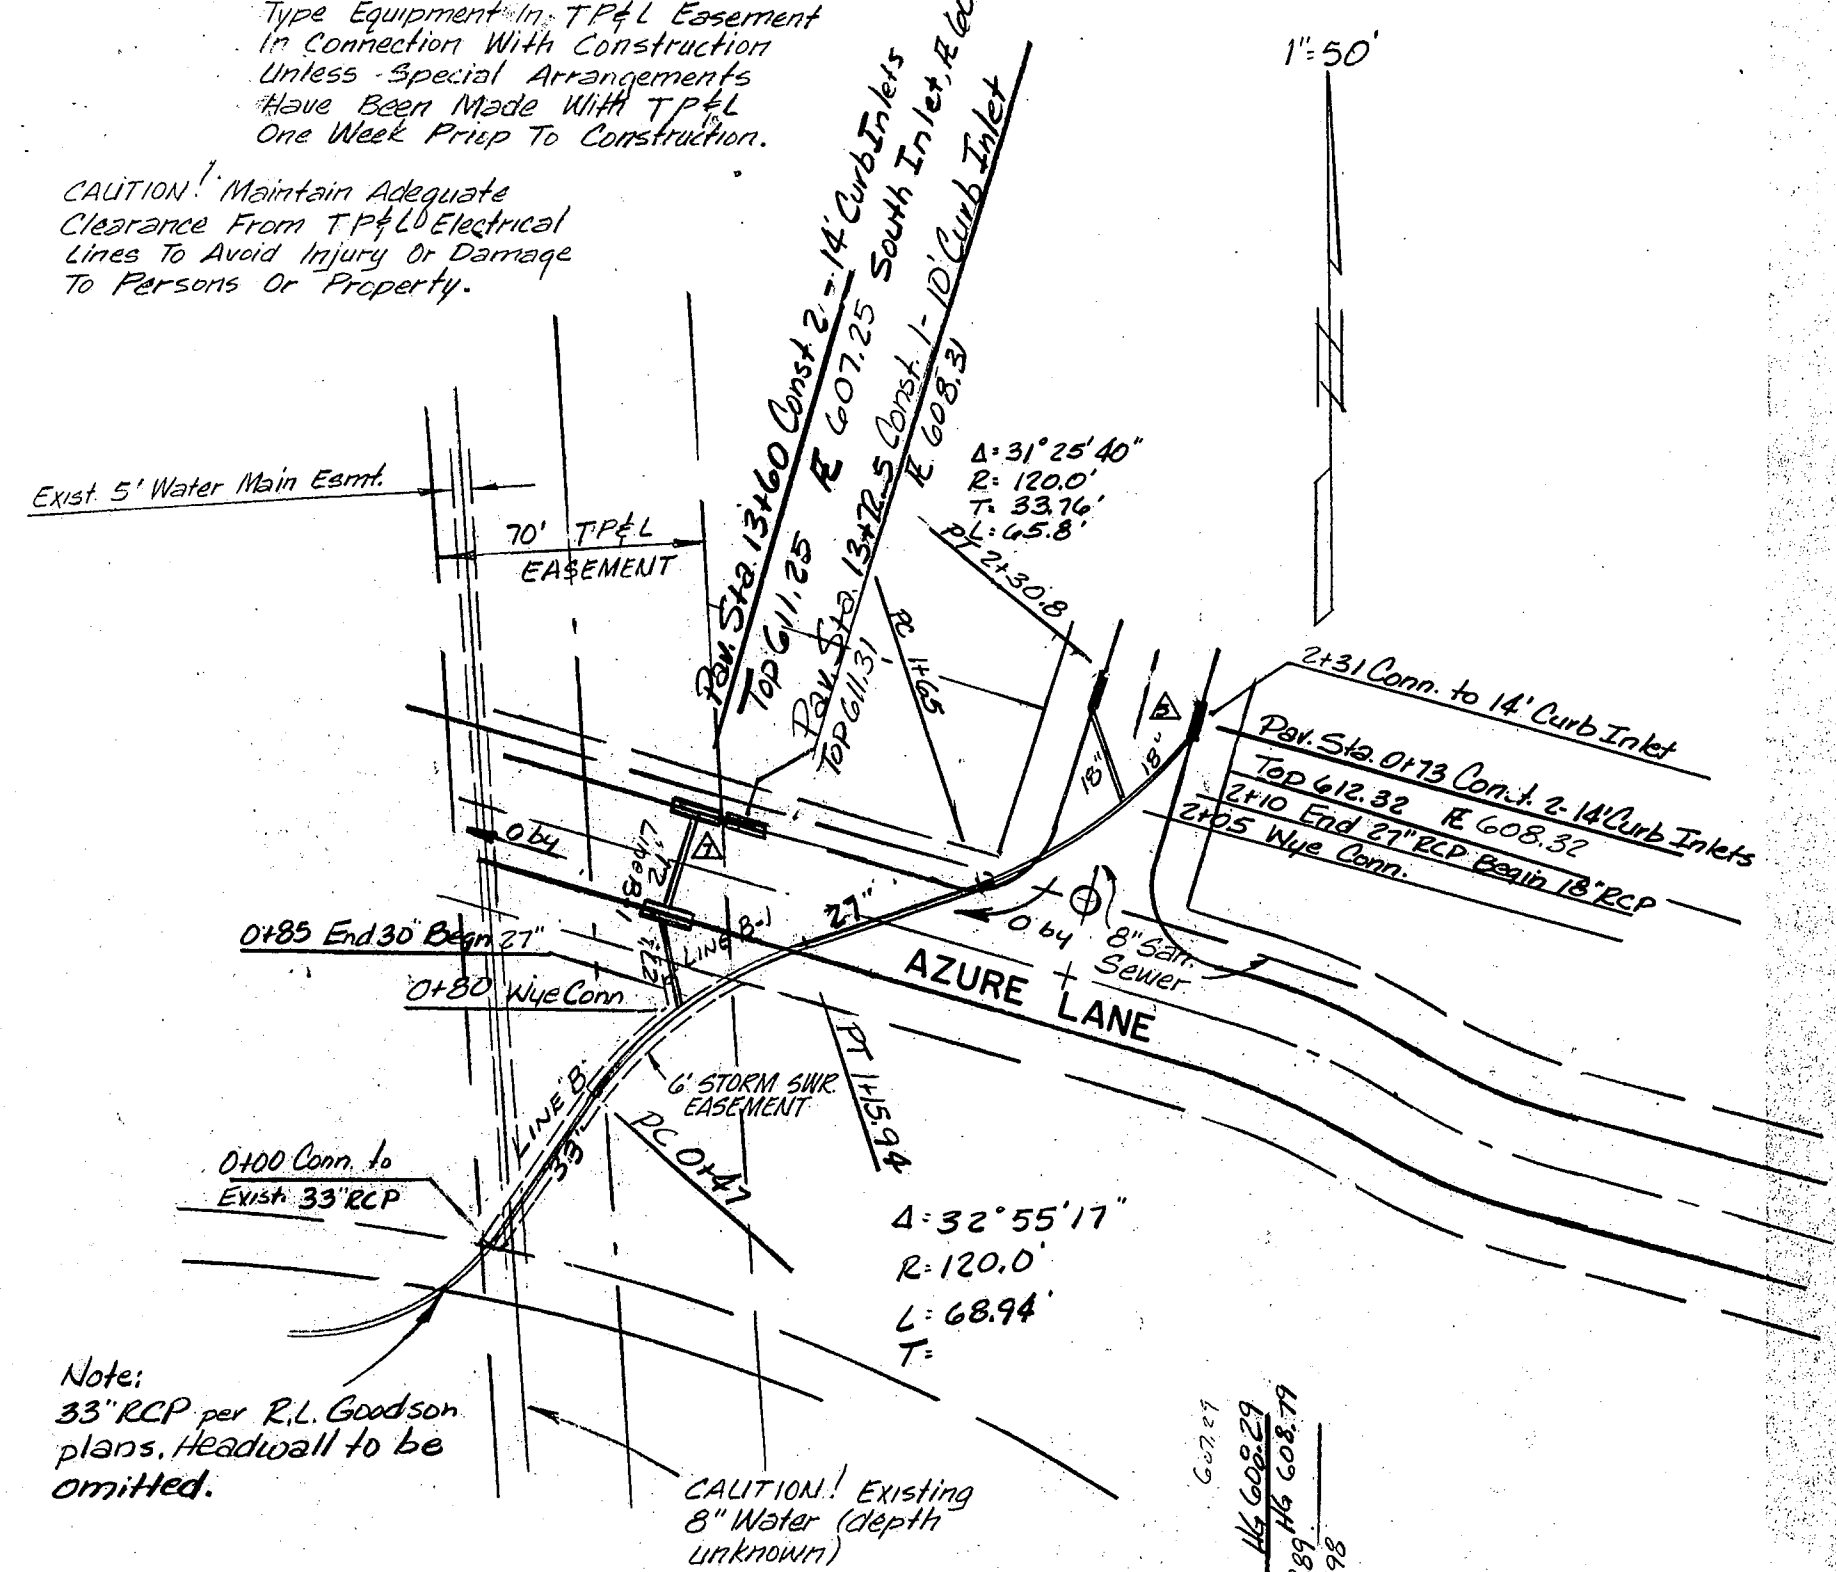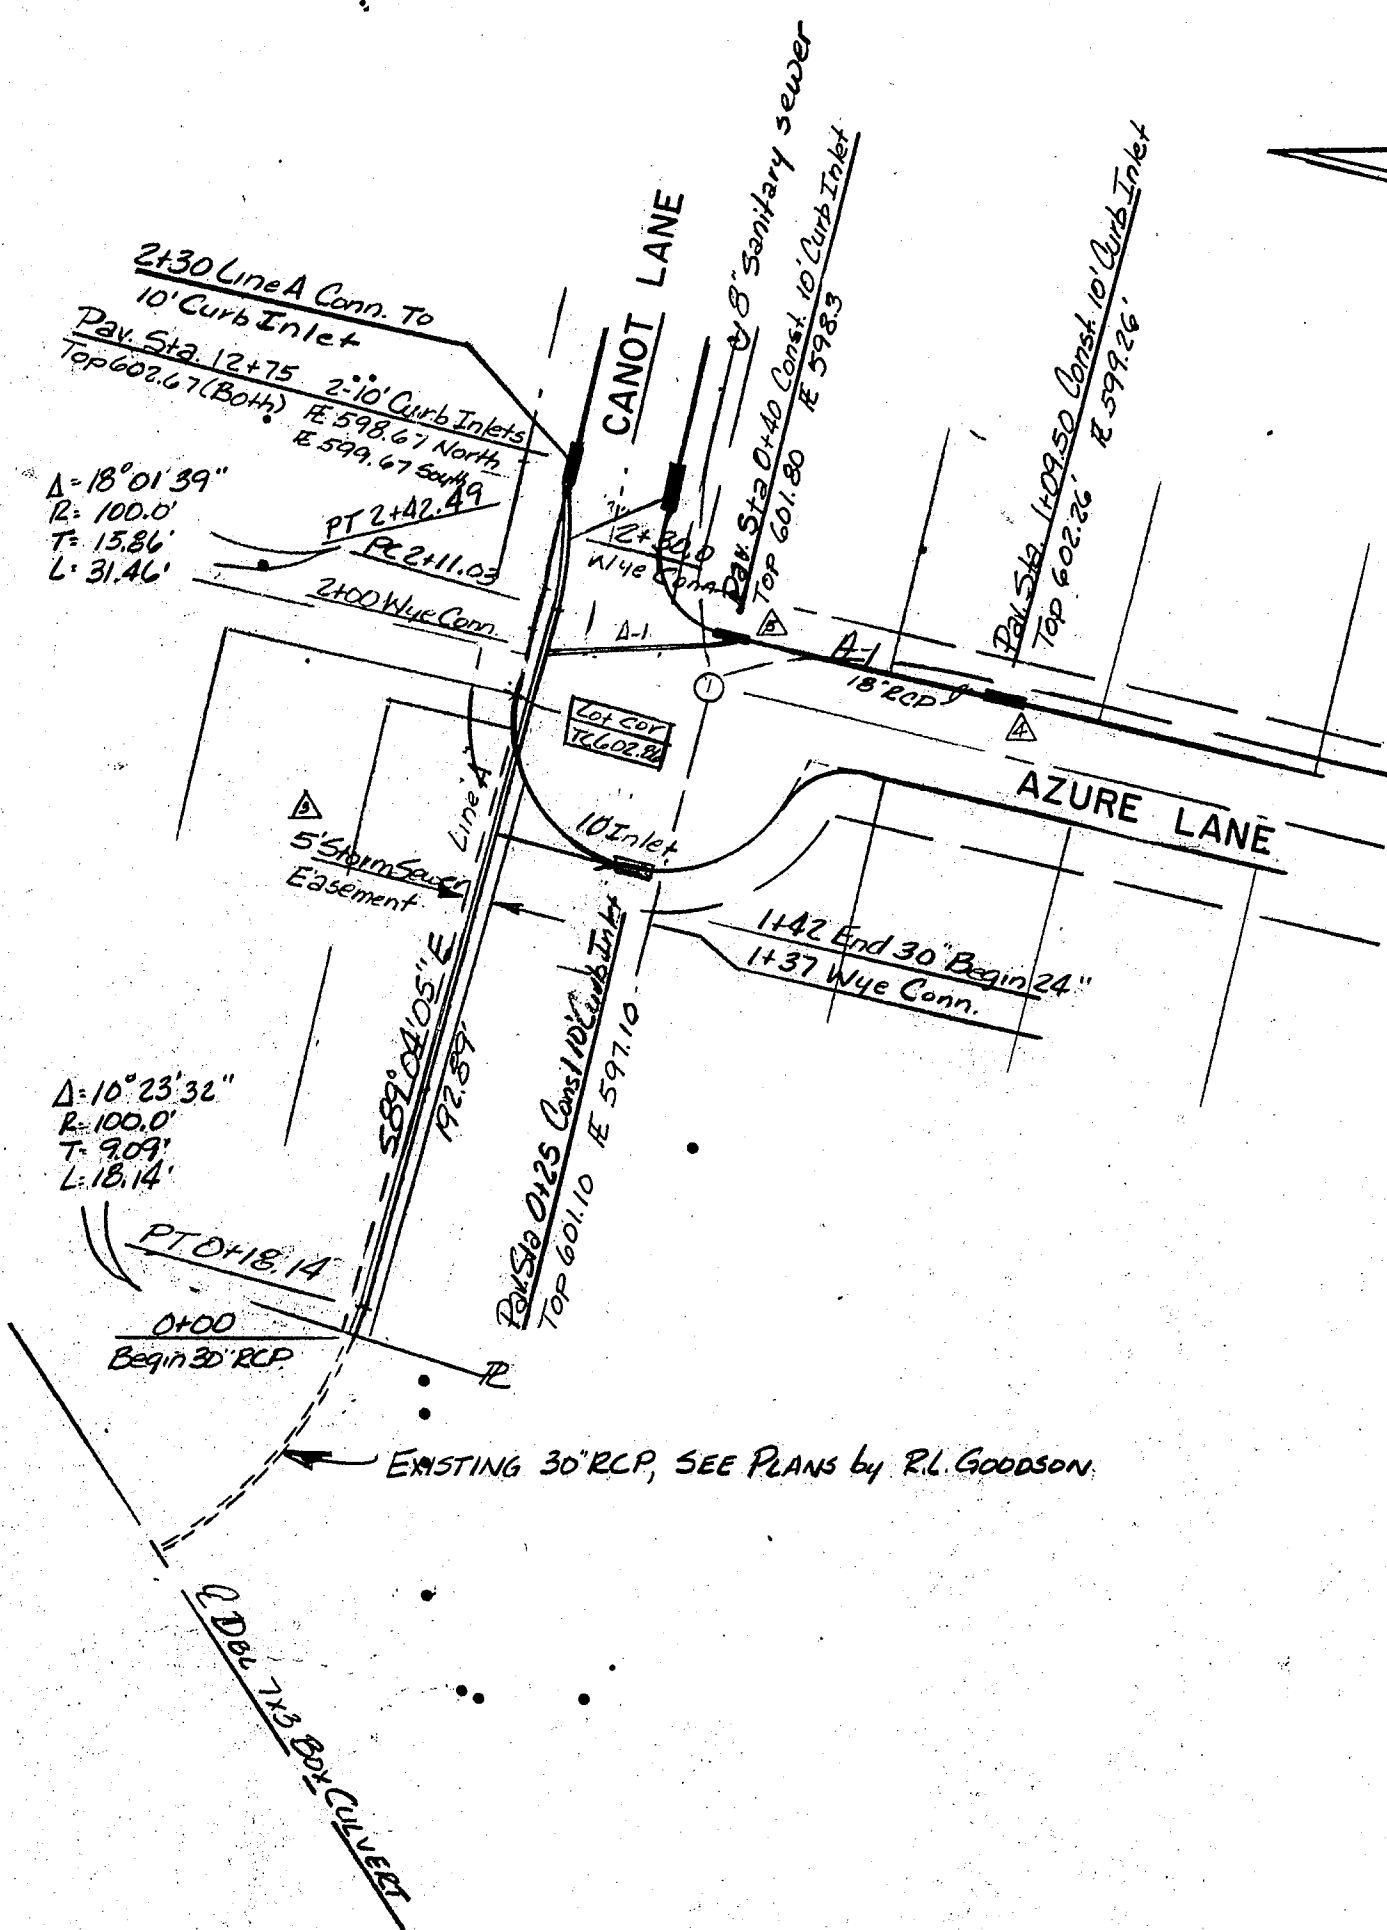

$t_c = 15 \text{ min.}$

DA#	AREA	C	I_{25}	Q_{25}
A-1	4.7	0.7	6.6	22.0
A-2	5.2	0.7	6.6	24.0
A-3	2.0	0.7	6.6	9.0
B-1	5.9	0.7	6.6	23.0
B-2	6.4	0.7	6.6	24.0
B-3	2.0	0.7	6.6	9.0
C	2.4	0.7	6.6	11.0
D	4.8	0.7	6.6	22.0

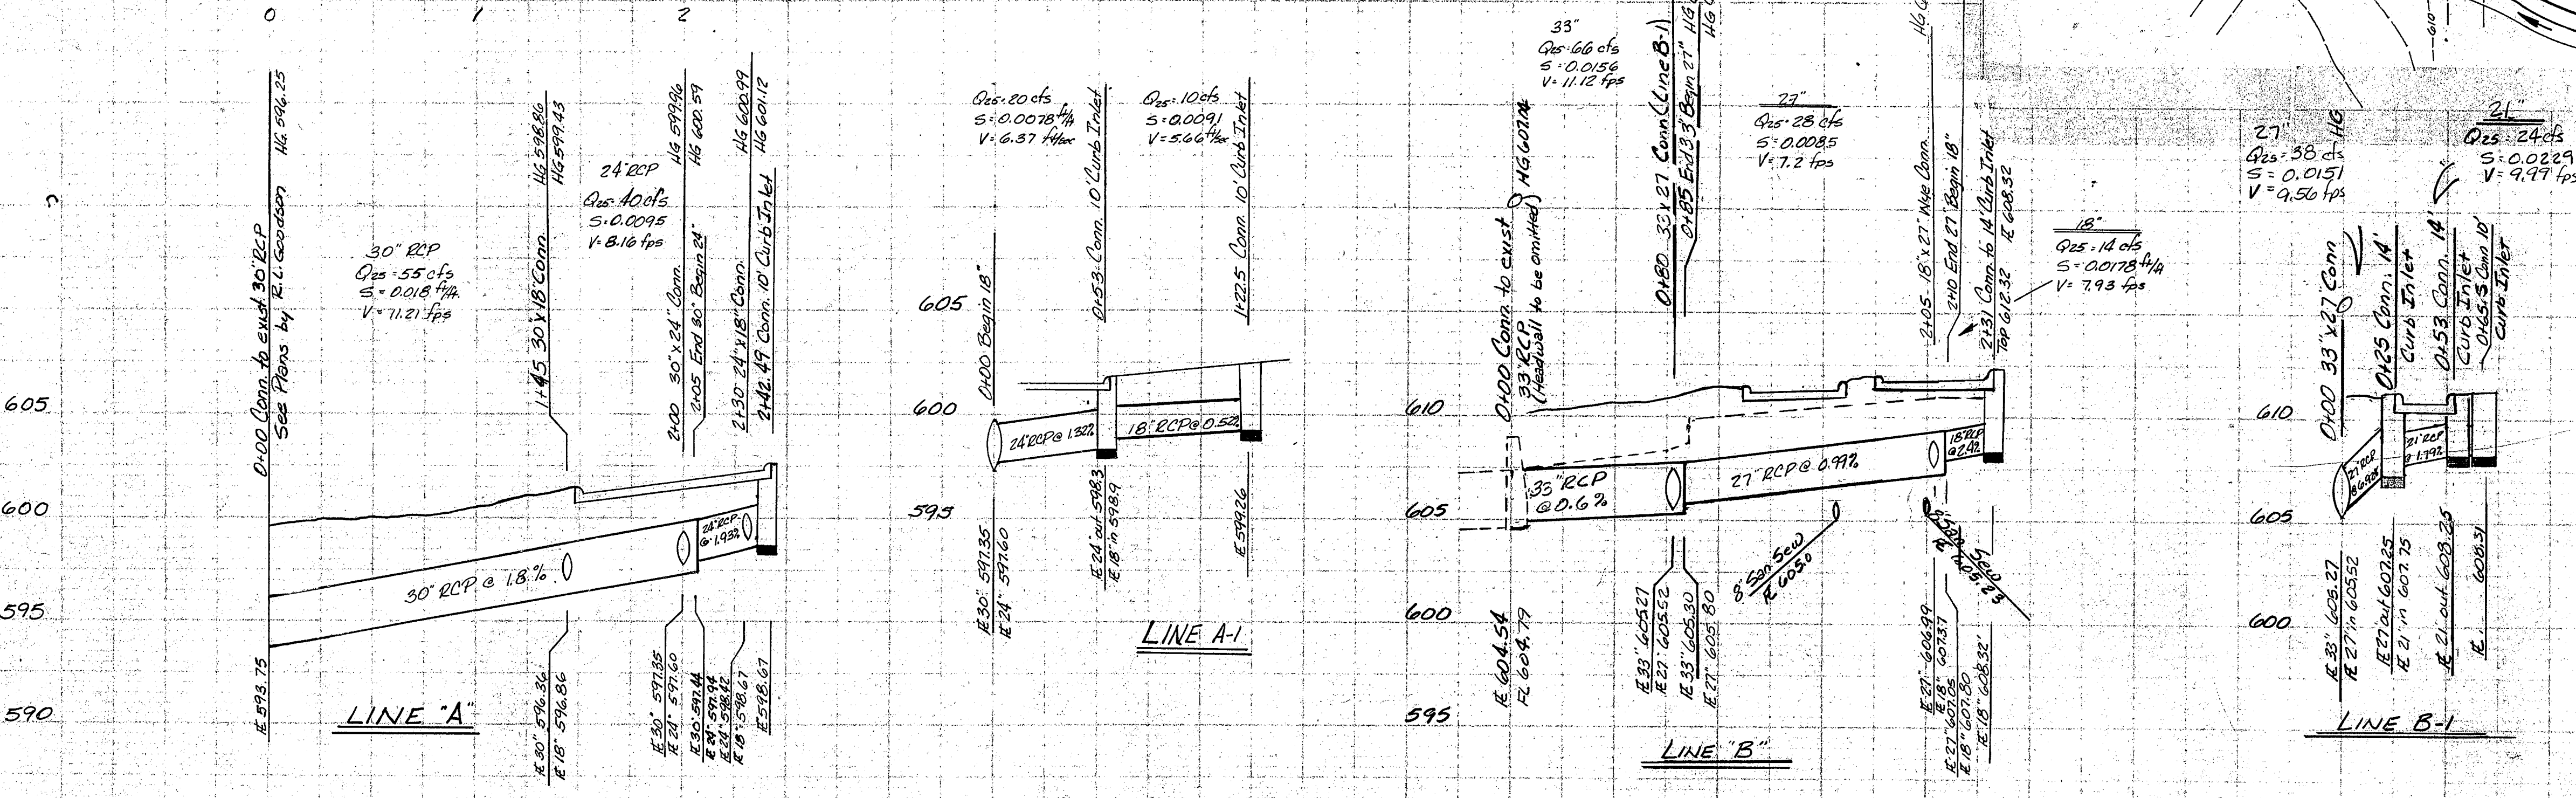


STORM SEWER & DRAINAGE AREA MAP

LES LACS GARDEN HOMES
LINES "A", "A-1", "B" & "B-1"

CITY OF ADDISON, TEXAS

HILL & CO ENGINEERING SCIENCES INC.

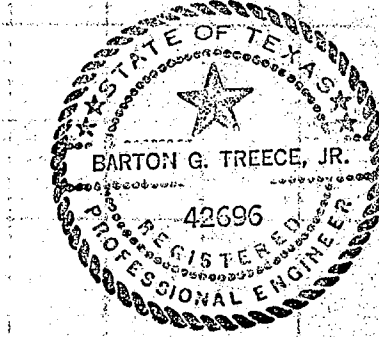

DESIGN	DRAWN	DATE	SCALE	NOTES	FILE	NO.
HILL & CO	AUR/81	NOV 11 1981	VERT 1"=8'	DL 2		