
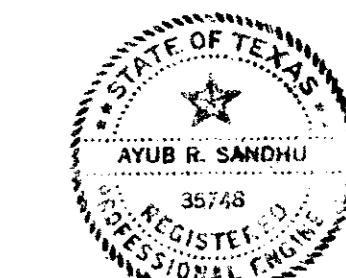


WARNING!!!
 (Maintain Adequate Clearance From D.P.E.L. Electrical Line To Preclude Injury or Damage To Persons or Property.)
 (Contractor or His Representative Should not Use Boom Type Equipment on D.P.E.L. R.O.W. In Connection With Construction Shown Unless Special Arrangements Have Been Made With D.P.E.L. Contract 1 Week Prior To Construction)

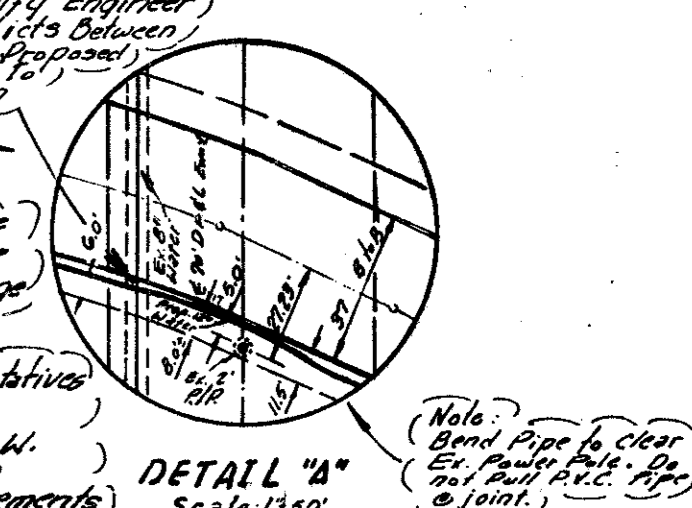

3/20/82

WATER & SANITARY SEWER PLAN					
RAYMOND L. GOODSON JR., INC., CONSULTING ENGINEERS					
CITY OF ADDISON, TEXAS					
DESIGN	DRAWN	DATE	SCALE	NOTES	FILE NO.
Raymond L. Goodson			1"=100'	R.L.G.	

Revised F.H. Line "W-20"
 Revised M.H. Line "S-30"
 Deleted S.S. Line "S-30"
 11/23/81
 Revised As Per As Built's
 3/20/82

9/1/81 Revised alignment and stations
 Added N.H. to Sanitary Sewer Line "S-10", and
 Revised Location exist. 16" Water on Marsh Ln.
 Added 18 1/2" P.V.C.
 9/30/81 Revised Locations Sanitary Sewer

Note:
 Contractor will field locate & notify Engineer of any conflicts between ex. utilities & prop. utilities prior to construction.