


(NOTE)  
Contractor will field locate & notify Engineer of any conflicts between Ex. utilities & prop. utilities Prior to Construction!!!

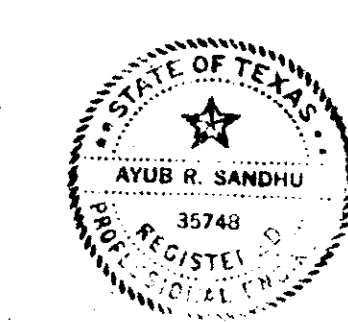

3/29/82

- Δ 1-30-81 Revised Location "S-5.0" & "S-10"
- Δ 1-23-81 Revised FH, 34.00' 33' & 201.35' Added 8" Service 301.57' to 331.32' 79' Deleted C.O. Sta. 13110 "S-4.0" Add M.H. 13/19.45 Add Line "S-4.0"
- Δ 12/10/81 Revised Guard House Utilities
- Δ 2/10/82 Revised Changed Water Line "W-2.0" & Added M.H. Line "S-4.0"
- Δ 3/29/82 Revised As Per As Built

WATER & SANITARY SEWER PLAN					
RAYMOND L. GOODSON JR., INC., CONSULTING ENGINEERS					
<b>CITY OF ADDISON, TEXAS</b>					
DESIGN	DRAWN	DATE	SCALE	NOTES	FILE NO.
Raymond L. Goodson			1"=100'	R.L.G.	