


1036
850
186

1150
1036
114

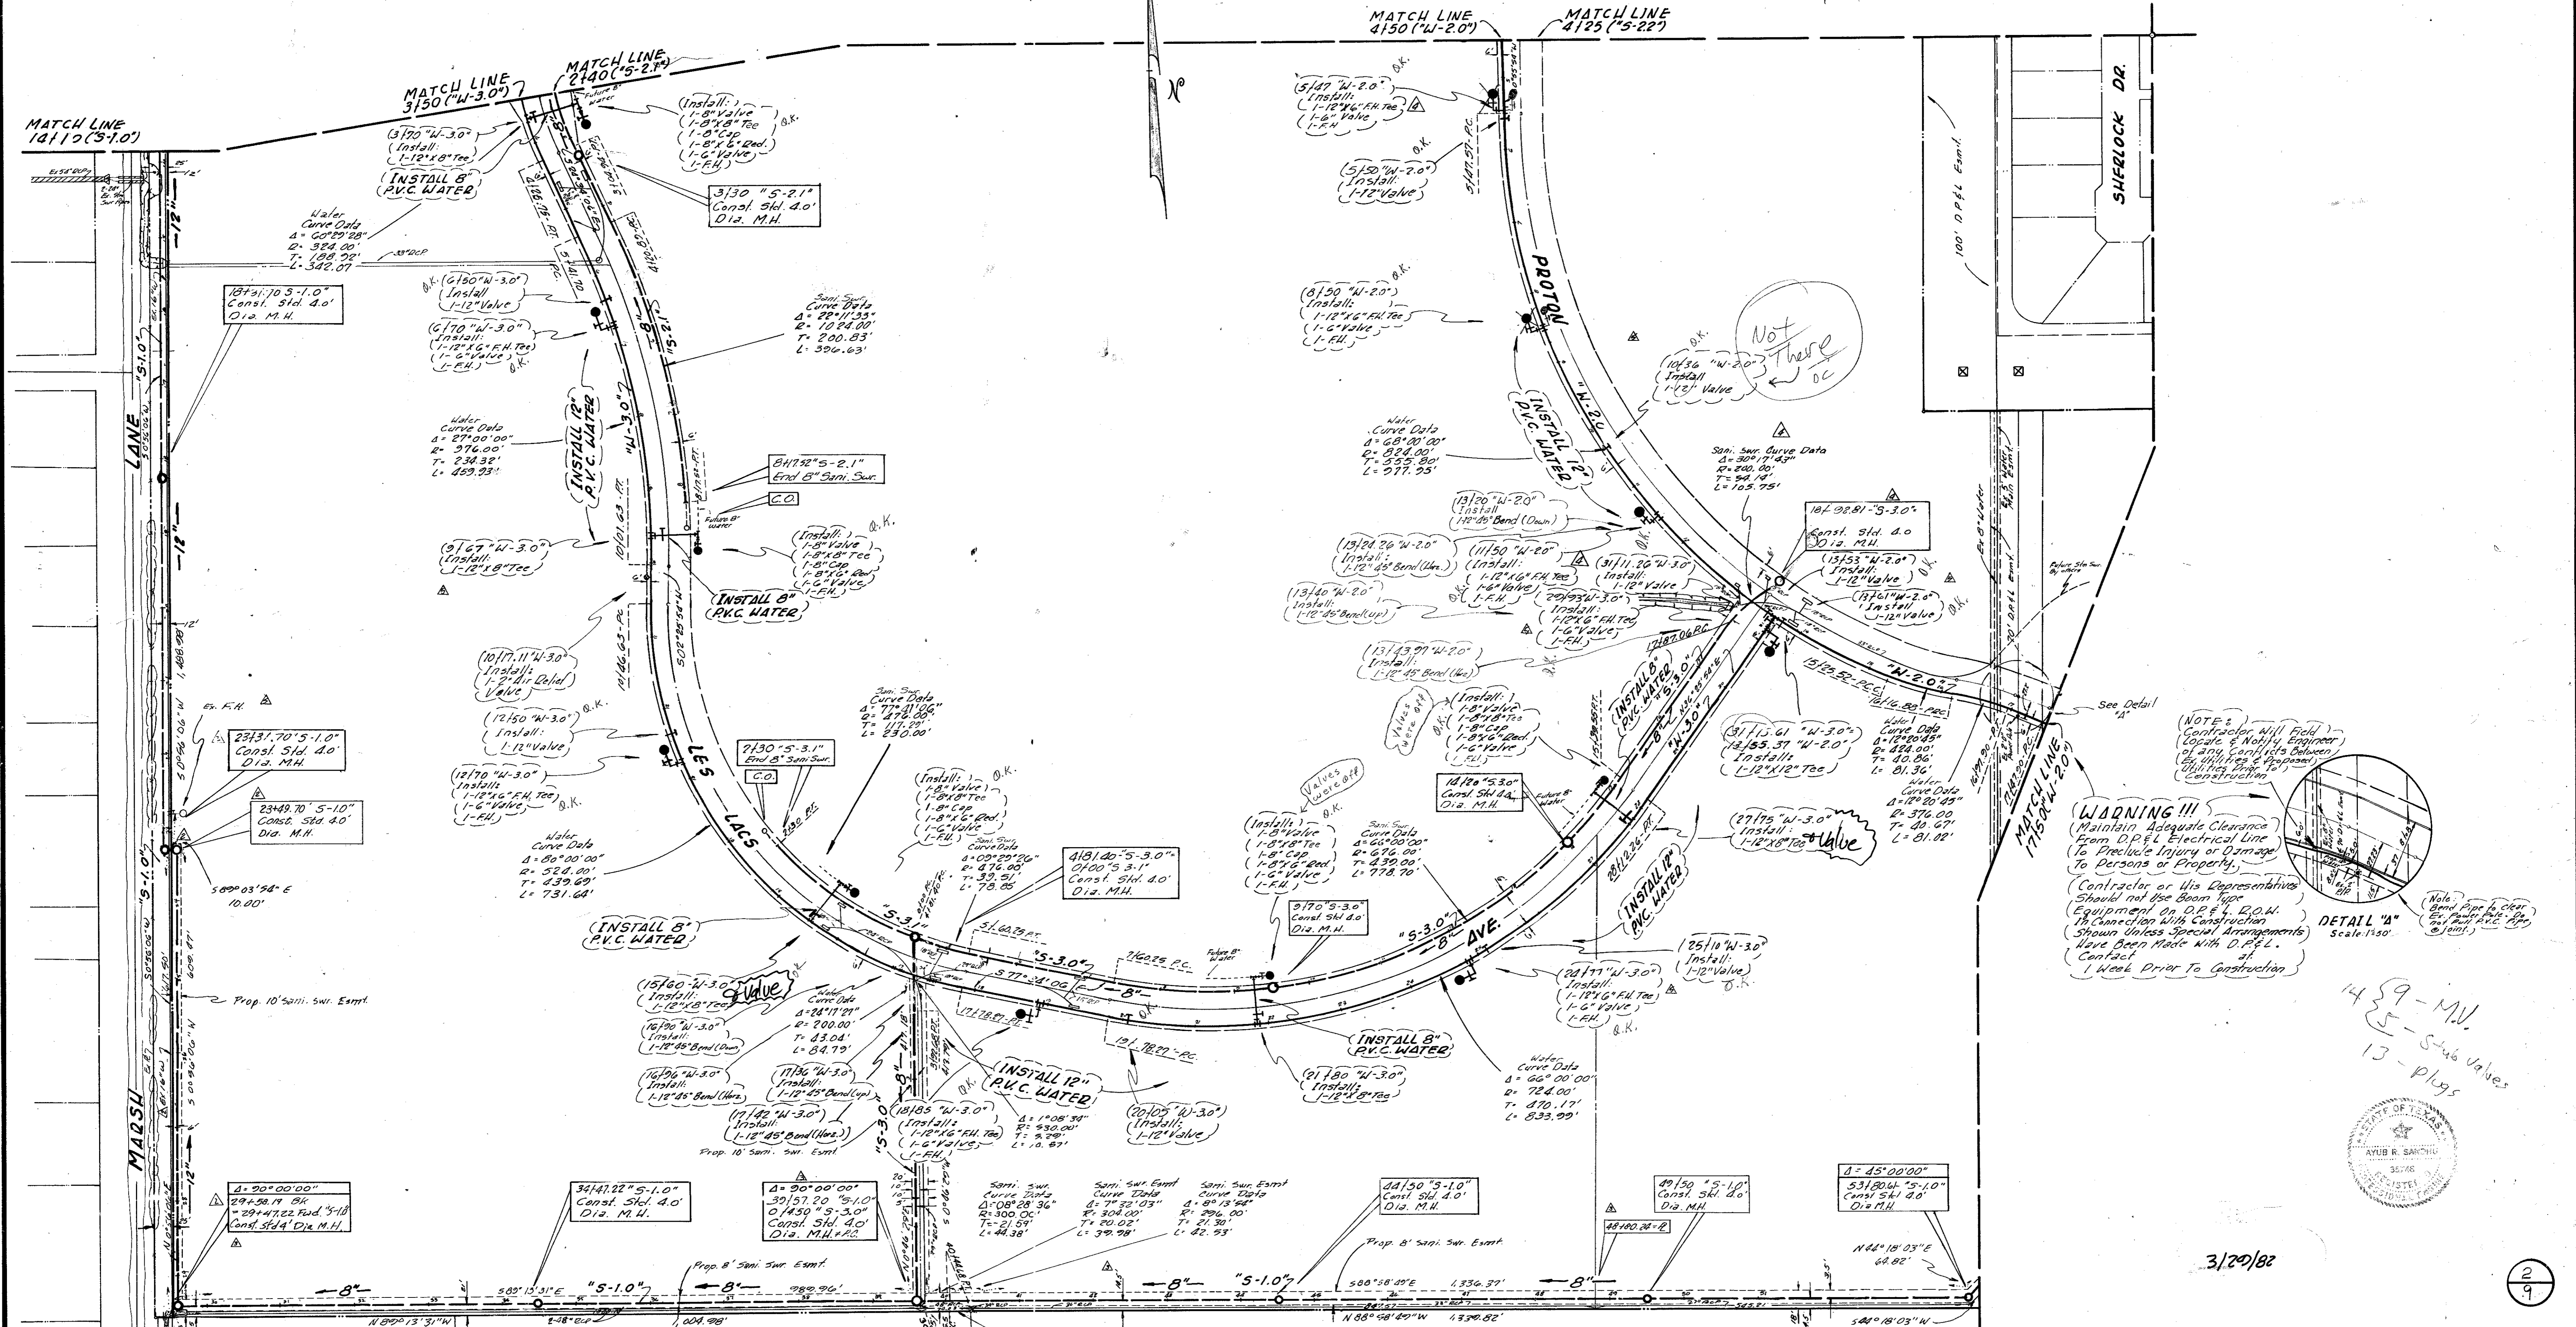

3/20/82

2/9

WATER & SANITARY SEWER PLAN					
RAYMOND L. GOODSON JR., INC., CONSULTING ENGINEERS					
CITY OF ADDISON, TEXAS					
DESIGN	DRAWN	DATE	SCALE	NOTES	FILE NO.
Raymond L. Goodson			1"=100'	R.L.G.	

Note:
Contractor will field locate & notify Engineer of any conflicts between ex. utilities & prop. utilities prior to construction.

Revised F.H. Line "W-20"
Revised M.H. Line "S-3.0"
Deleted S.S. Line "S-32"
11/23/81
Revised As Per As Built's
3/20/82

9/1/81 Revised alignment and stationing
Added M.H. to Sanitary Sew. Line "S-1.0" and
Revised Location exist. 16" water on Marsh Ln.
Added 18 1/2" P.V.C.
9/30/81 Revised Locations Sanitary Sewer

WARNING!!!
Maintain Adequate Clearance From D.P.E.L. Electrical Line To Preclude Injury or Damage To Persons or Property.
Contractor or His Representative Should not use Beam Type Equipment on D.P.E.L. R.O.W. In Connection With Construction Unless Special Arrangements Have Been Made With D.P.E.L. Contact at 1 Week Prior to Construction

NOTE:
Contractor will field locate & notify Engineer of any conflicts between ex. utilities & prop. utilities prior to construction.

DETAIL "A"
Scale 1/8"=1'-0"

1459-M.V.
13-Sub Valves
13-plugs

