


△ Revised 10-21-81 Changed Grades & Flow Lines.

- BENCH MARKS**
1. Railroad Spike in 12" Willow 250' East Centerline Old Marsh Lane & 75' West North Centerline Belt Line. Elev. 576.32
 2. "D" Top of Curb at the Center of a 10' inlet and 75' West of Centerline Commercial at the North Side of Belt Line Road. Elev. 580.83
 3. "D" Top of Concrete Footing at Southeast Corner Tower #12N-3W-2287. Elev. 597.83
 4. "D" Top of Concrete Footing at Northwest Corner Tower #12N-3W-1288. Elev. 603.20
 5. "D" Top of Concrete Footing at Northwest Corner Tower #12N-3W-T290 at angle point in Tower line. Elev. 613.16
 6. "D" Top of Concrete Footing at Southwest Corner Tower #12N-3W-1291. Elev. 619.46
 7. "D" Cut at top of Concrete Footing at Tower #12N-2W-T294. Elev. 607.46

AS BUILT
DATE 3/20/82

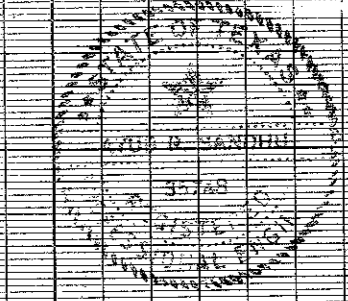

WATER PROFILE
LINE "W-2.0"

RAYMOND L. GOODSON JR. INC., ENGINEERS
CITY OF ADDISON, TEXAS

DESIGN	DRAWN	DATE	SCALE	NOTES	FILE	NO.
R.L.G.	R.L.G.	JULY 1981	1"=100'H 1"=6'V	R.L.G.		