


"5-1.0"
 2558 LF 8" PVC
 S.W.R. PIPE
 As per City of Addison Specs.
 (except as noted)

"5-1.0"
 2963 LF 12" PVC
 S.W.R. PIPE
 As per City of Addison Specs.
 (except as noted)

AS BUILT
 DATE 3/20/82

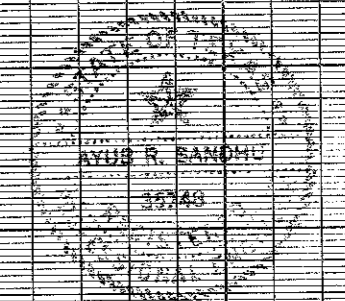

69

SANITARY SEWER PROFILES						
LINE "S-1.0"						
LES LACS VILLAGE INC.						
RAYMOND L. GOODSON JR. INC. ENGINEERS						
CITY OF ADDISON, TEXAS						
DESIGN	DRAWN	DATE	SCALE	NOTES	FILE	NO.
RLG	RLG	Aug, 1981	1"=100'H 1"=6'V	RLG		

9/17/81 Revised stations Line "S-1.0"
 Added M.H. E
 18 L.F. 12" PVC.
 9/30/81 Revised stations Line "S-1.0"