


150 L.F. 8" PVC S.W. PIPE as per City of Addison Specs (except on notes)

1888 L.F. 8" PVC S.W. PIPE as per City of Addison Specs (except on notes)
LINE "S3.0"

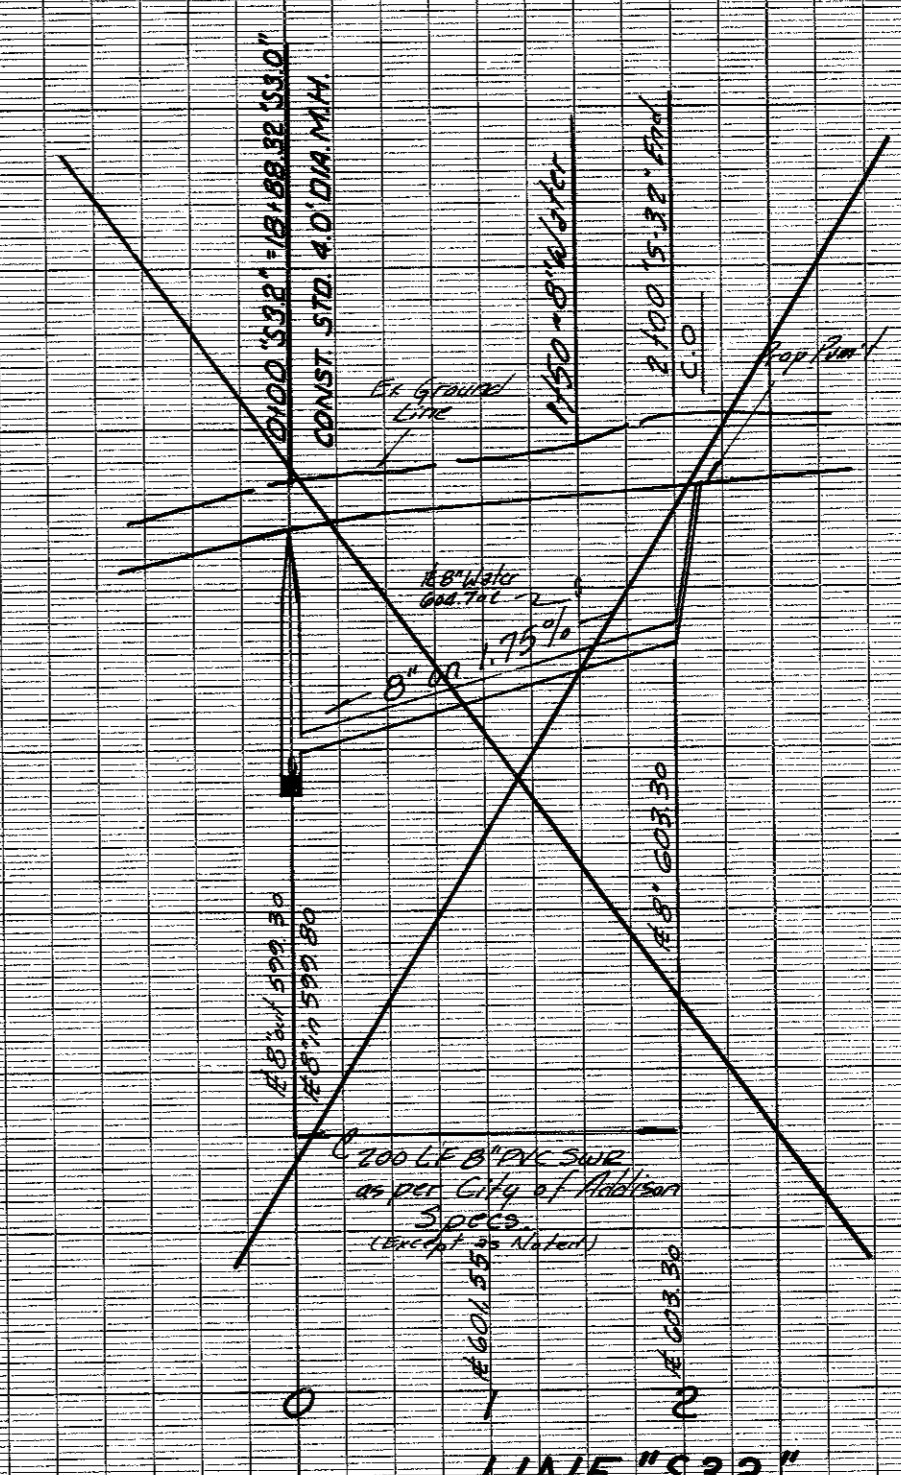

11/18/81 Eliminate Line "S3.2"
Relocated End of Line "S3.0"
Added 30 L.F. Conc. Encasement

AS BUILT
DATE 3/29/82

- BENCH MARKS
1. Railroad Spike in 12" Willow 250+ feet East Centerline Old Marsh Lane & 75+ feet North Centerline Belt Line. Elev. 576.32
 2. "C" Top of Curb at the Center of a 10' inlet and 75+ feet West of Centerline Commercial at the North Side of Belt Line Road. Elev. 580.83
 3. "C" Top of Concrete Footing at Southeast Corner Tower #12N-3W-T287. Elev. 597.83
 4. "C" Top of Concrete Footing at Northwest Corner Tower #12N-3W-T288. Elev. 605.20
 5. "C" Top of Concrete Footing at Northwest Corner Tower #12N-3W-T290 at angle point in Tower line. Elev. 613.16
 6. "C" Top of Concrete Footing at Southwest Corner Tower #12N-3W-T291. Elev. 619.46
 7. "C" Cut at top of Concrete Footing at Tower #12N-2W-T294. Elev. 607.46

SANITARY SEWER PROFILES
LINES S3.0, S3.1, S3.2, & S3.3

RAYMOND L. GOODSON JR. INC. ENGINEERS
CITY OF ADDISON, TEXAS

DESIGN	DRAWN	DATE	SCALE	NOTES	FILE	NO.
R.L.G.	R.L.G.	JULY 1981	1" = 100'	R.L.G.	80	95

