

11/23/81 Revised Line "S4.0"  
 Added Line "S4.1"  
 2/6/82 Revised Line "S4.1" & "S5.0"


1. Railroad Spike in 12" Willow 250+ feet East Centerline Old Marsh Lane & 75+ feet North Centerline Belt Line. Elev. 576.32
2. "□" Top of Curb at the Center of a 10' inlet and 75+ feet West of Centerline Commercial at the North Side of Belt Line Road. Elev. 580.83
3. "□" Top of Concrete Footing at Southeast Corner Tower #13N-3W-1287. Elev. 597.83
4. "□" Top of Concrete Footing at Northwest Corner Tower #12N-3W-1288. Elev. 605.20
5. "□" Top of Concrete Footing at Northwest Corner Tower #12N-3W-1290 at angle point in Tower line. Elev. 613.16
6. "□" Top of Concrete Footing at Southwest Corner Tower #12N-3W-1291. Elev. 619.46
7. "□" Cut at top of Concrete Footing at Tower #12N-2W-1294. Elev. 607.46

**SANITARY SEWER PROFILES**  
LINES S4.0 & S5.0

RAYMOND L. GOODSON JR., INC., ENGINEERS  
CITY OF ADDISON, TEXAS

DESIGN	DRAWN	DATE	SCALE	NOTES	FILE	NO.
RLG.	RLG.	JULY 1981	1"=100' 1"=6'V	R.L.G.	80	95

REVISIONS  
 1  
 2  
 3  
9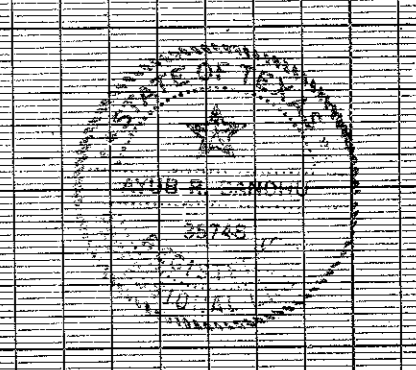