



- PAVING GENERAL NOTES:
1. Unless otherwise noted all material and construction shall conform to applicable specifications of the Town of Addison with amendments - The North Central Texas Council of Governments "Standard Specifications for Public Works Construction", Parts I and II, latest edition.
 2. All curb dimensions are to back of curb.
 3. Pavement reinforcing will be grade 60.
 4. All concrete pavement shall be 6" thick and have minimum strength of 3000 psi at 28 days.
 5. Construct barrier free ramps at all street intersections. See sheet 12 for details.
 6. Prior to construction the contractor shall be responsible for verifying the location of existing utilities.
 7. Hydrated lime shall be applied as a slurry.
 8. No flyash is allowed.
 9. Spoils to be removed from the Town of Addison.

BENCHMARKS:

"□" on NW corner of transmission tower
No. 12N-3W-T290 where transmission line
turns 90° to East.
ELEVATION = 613.16

"□" found on the south top of curb of
Proton Drive approximately 30' East of
the Northwest property corner of Les Lacs I.
ELEVATION = 611.33

NOTE:
E.-J. INDICATES EXPANSION JOINT

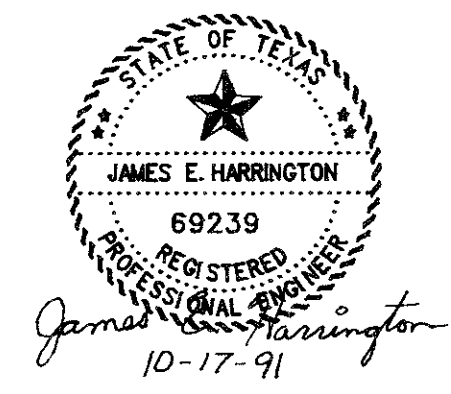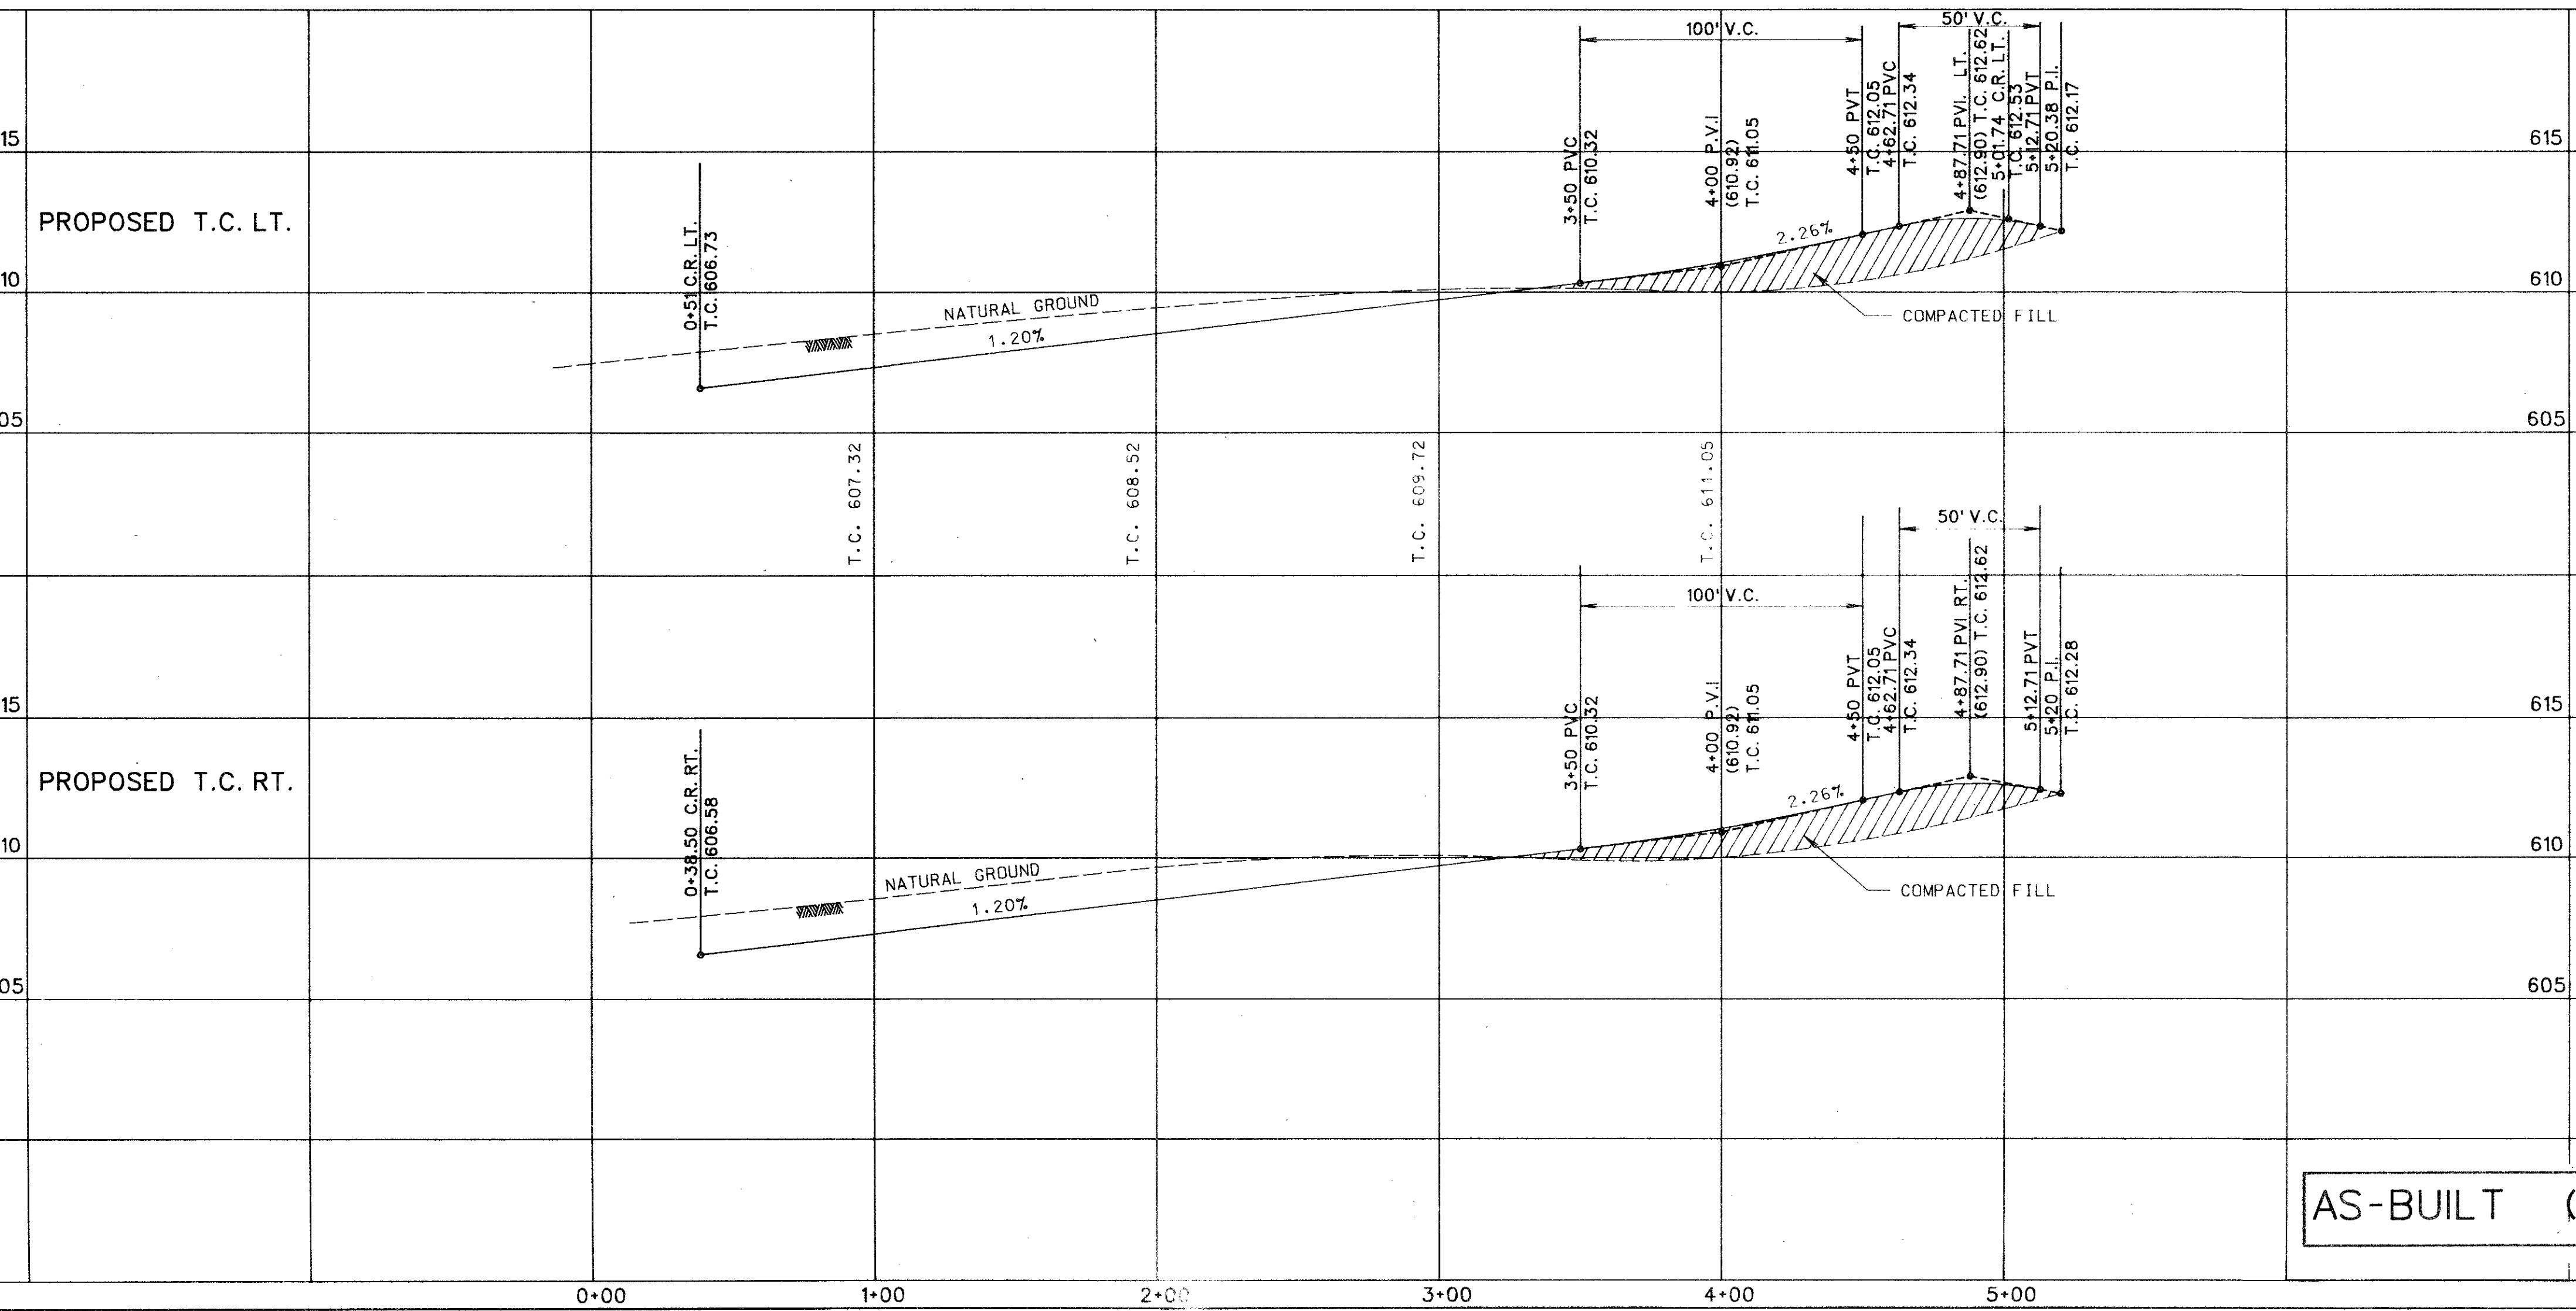

The seal appearing on
this document was
authorized by
James E. Harrington,
P.E. 69239, on
October 17, 1991

CORWIN ENGINEERING, INC.
3023 Routh Street Dallas, Texas 75201 (214) 220-9136

DEVELOPMENT PLANS FOR
LES LACS I
ADDISON, TEXAS

LEXUS AVENUE

AS-BUILT (FEB. 1992)

DRAWN BY JEH	DESIGNED BY CEI	CHECKED BY WLC	SHEET NO.
JOB NUMBER 9120	DATE OCTOBER 1991	SCALE: 1"=4' V 1"=40' H	4 OF 19

VI-PP1
FILE: 9120P51.DGN
REF. FILE: 9120AL.DGN
VIEW: PLANT
DATE: 10-17-91