

**Alternate "B"**  
 Note: Base Bid Fill Line Shall Match Existing Ground. (Alt. "B" is Applicable Only Where Top of Pipe is Exposed)

**Bench Marks**


"D" Top of Curb of the Center of a 10' Inlet and 10'± West of Centerline at the North Side of Beltline Road  
 Elevation: 580.83  
 "E" Top of Concrete Footing at N.W. Corner Tower #12A-3W-72B  
 Elevation: 605.20

**Storm Sewer Data**

- ① 327° 27' 23" E 43.56'
- ② Δ = 73° 26' 56" R = 200.00' T = 149.81' L = 256.99'
- ③ 345° 59' 34" W 170.73'
- ④ 307° 45' 01" W 27.54'
- ⑤ 307° 45' 01" W 235.22'
- ⑥ 307° 45' 01" W 53.78'

All lateral connections 90° to Storm Sewer unless noted

11/23/83  
 Accepted For Construction By: \_\_\_\_\_ Date: \_\_\_\_\_  
 Owner: \_\_\_\_\_ Date: \_\_\_\_\_  
 Contractor: \_\_\_\_\_ Date: \_\_\_\_\_

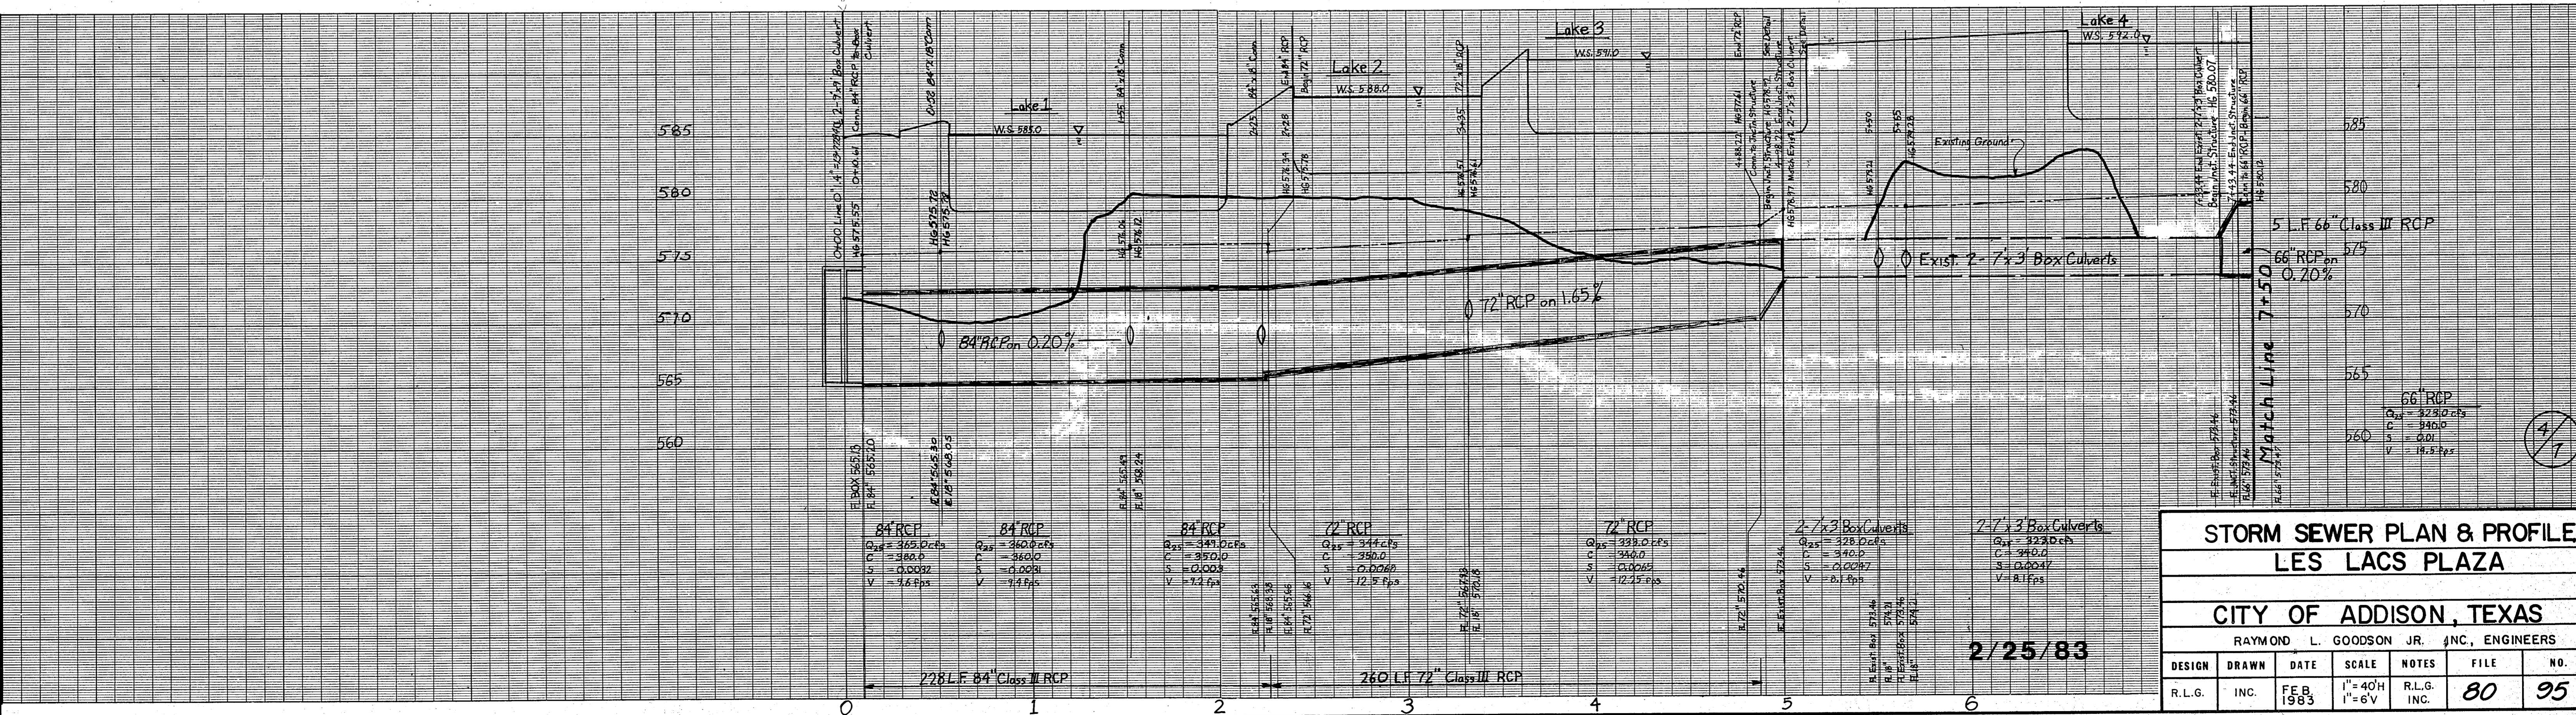

| STORM SEWER PLAN & PROFILE             |       |            |                         |             |      |     |
|--|-------|------------|-------------------------|-------------|------|-----|
| LES LACS PLAZA                         |       |            |                         |             |      |     |
| CITY OF ADDISON, TEXAS                 |       |            |                         |             |      |     |
| RAYMOND L. GOODSON JR. INC., ENGINEERS |       |            |                         |             |      |     |
| DESIGN                                 | DRAWN | DATE       | SCALE                   | NOTES       | FILE | NO. |
| R.L.G.                                 | INC.  | FE 8, 1983 | 1" = 40' H<br>1" = 6' V | R.L.G. INC. | 80   | 95  |

2/25/83

CONSTRUCTION SET