

STORM SEWER


LES LACS PLAZA

ADDISON, TEXAS

for

LES LACS PLAZA JOINT VENTURE

INDEX	
Sheet No.	Description
1	Title Sheet
2	Line "D 1.3"
3	Line "D 3.2"
4	Line "D 2.3" & Line "D 2.6"

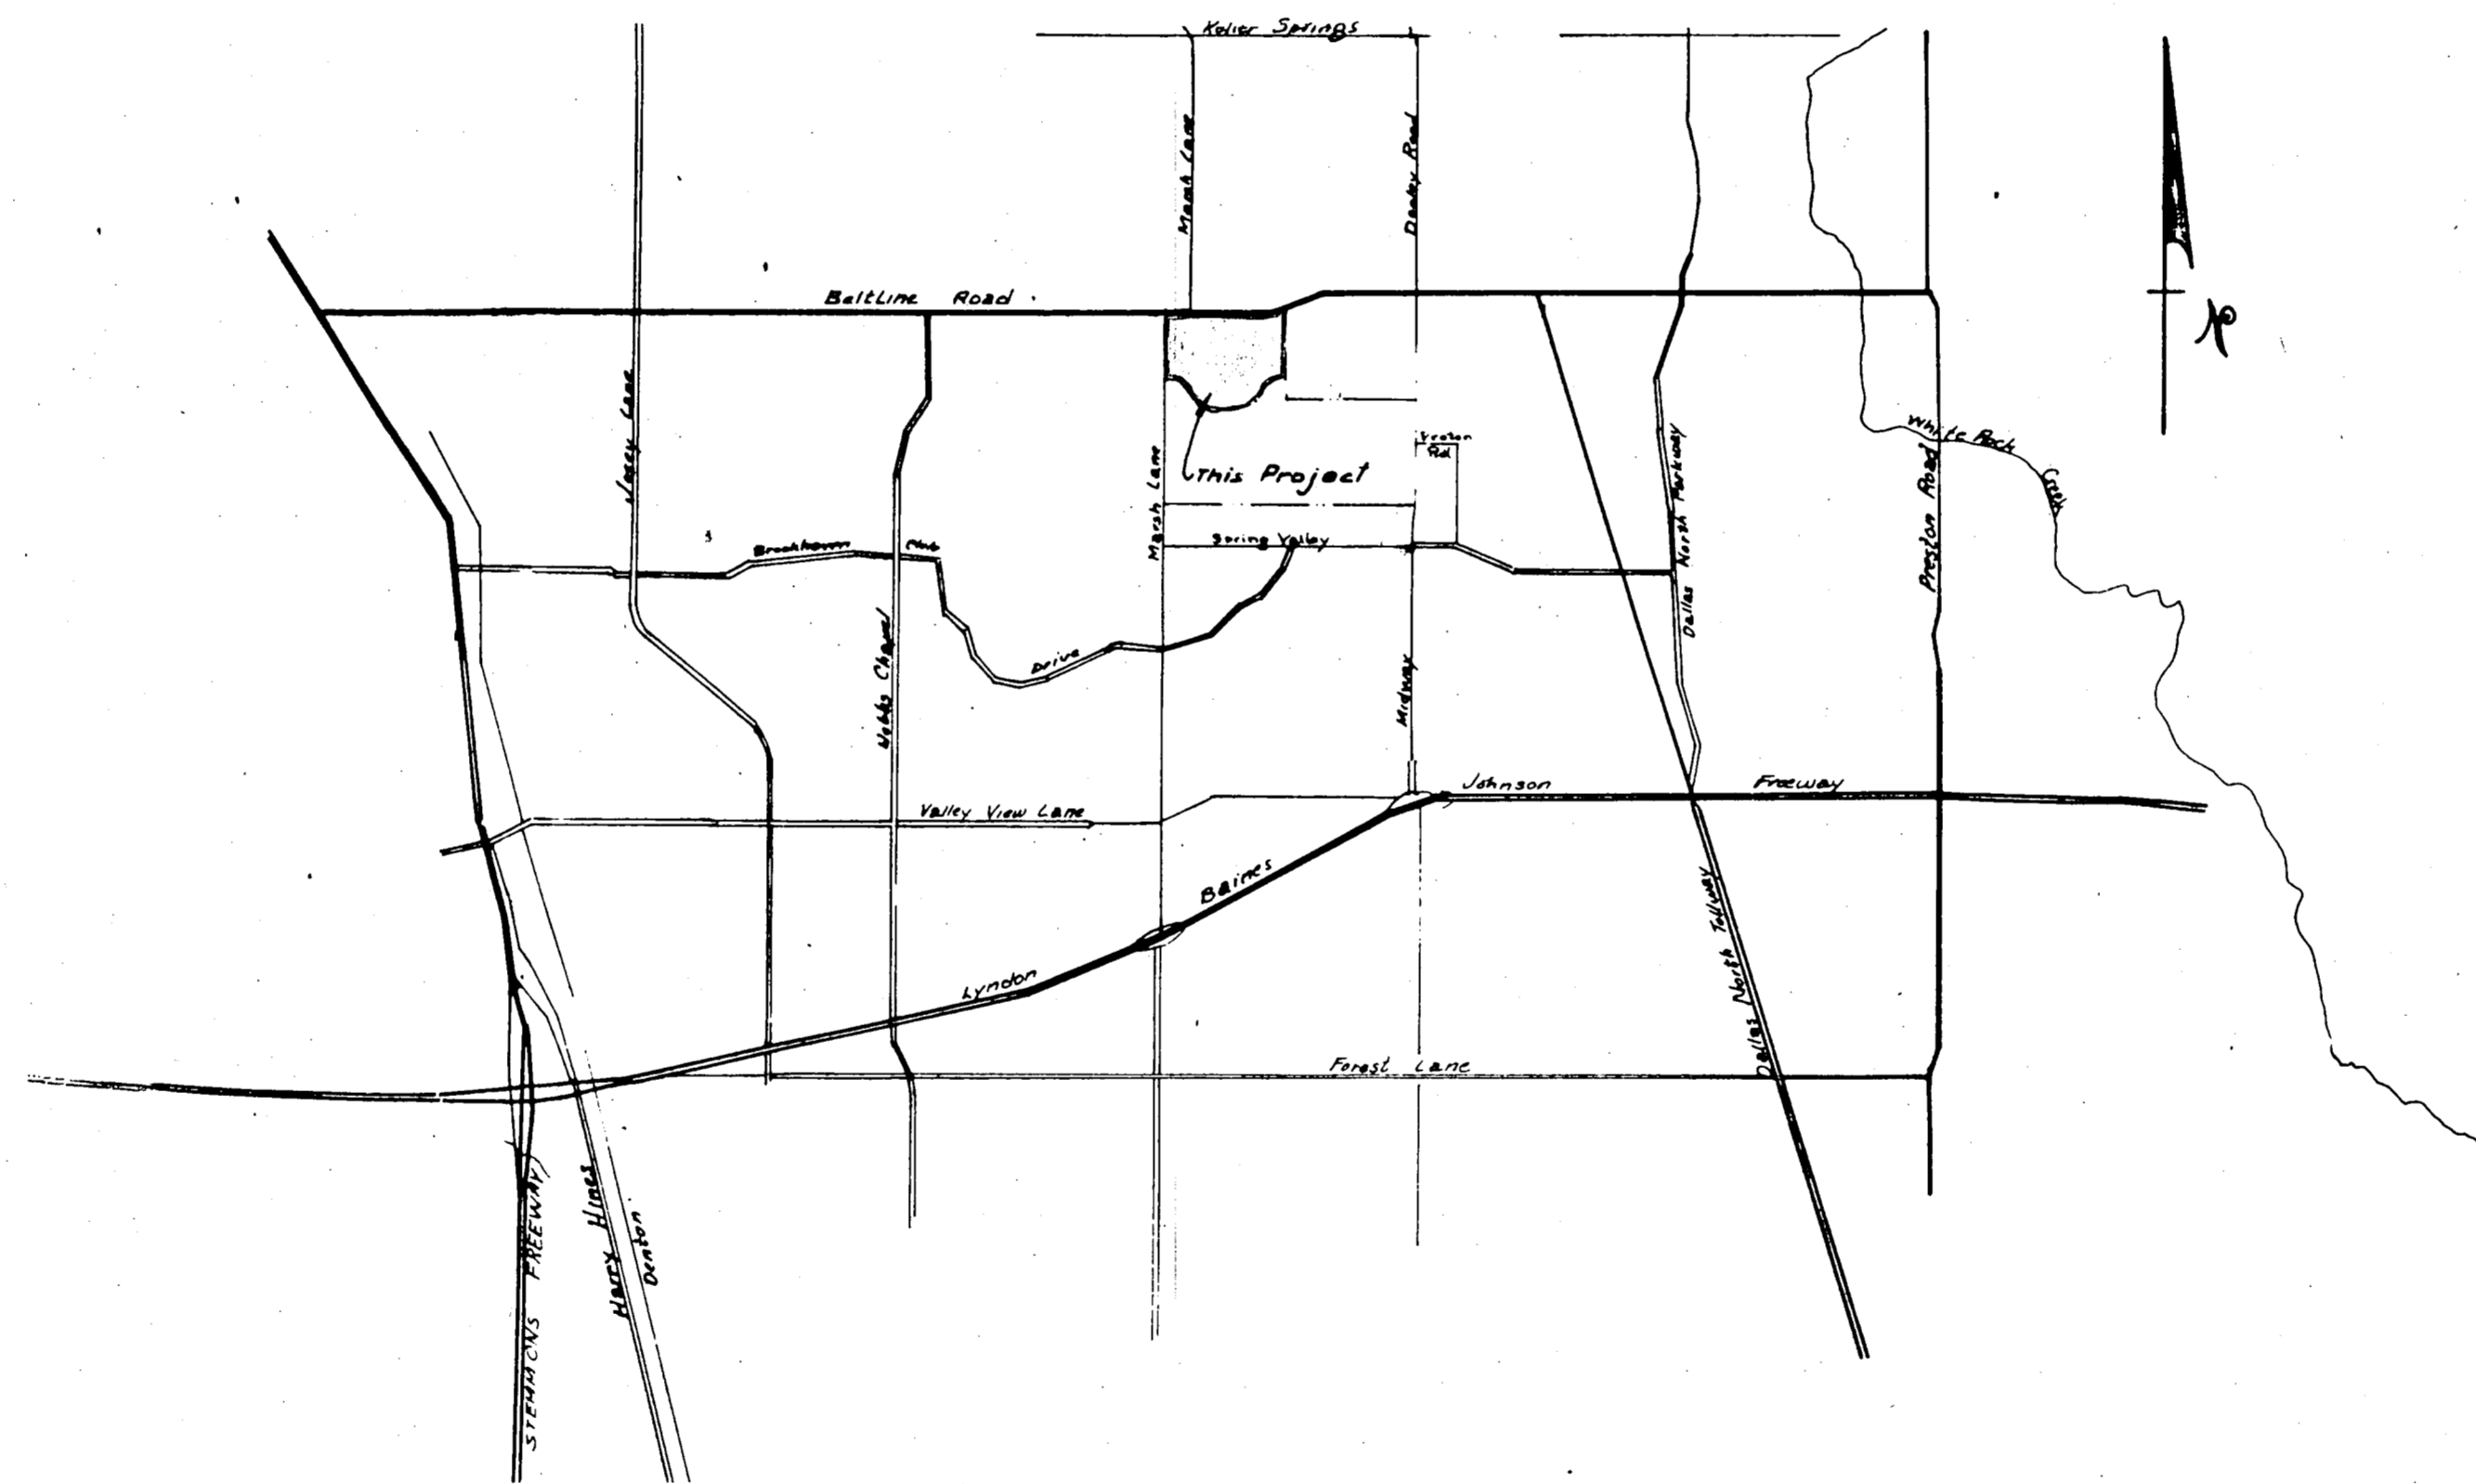

VICINITY MAP

AS BUILT
DATE 11/23/83

DESIGNED BY

RAYMOND L. GOODSON JR., INCORPORATED, CONSULTING ENGINEERS
3409 OAK GROVE
528-2200
DALLAS, TEXAS
75204