


LES LACS PLAZA

for

LES LACS PLAZA JOINT VENTURE

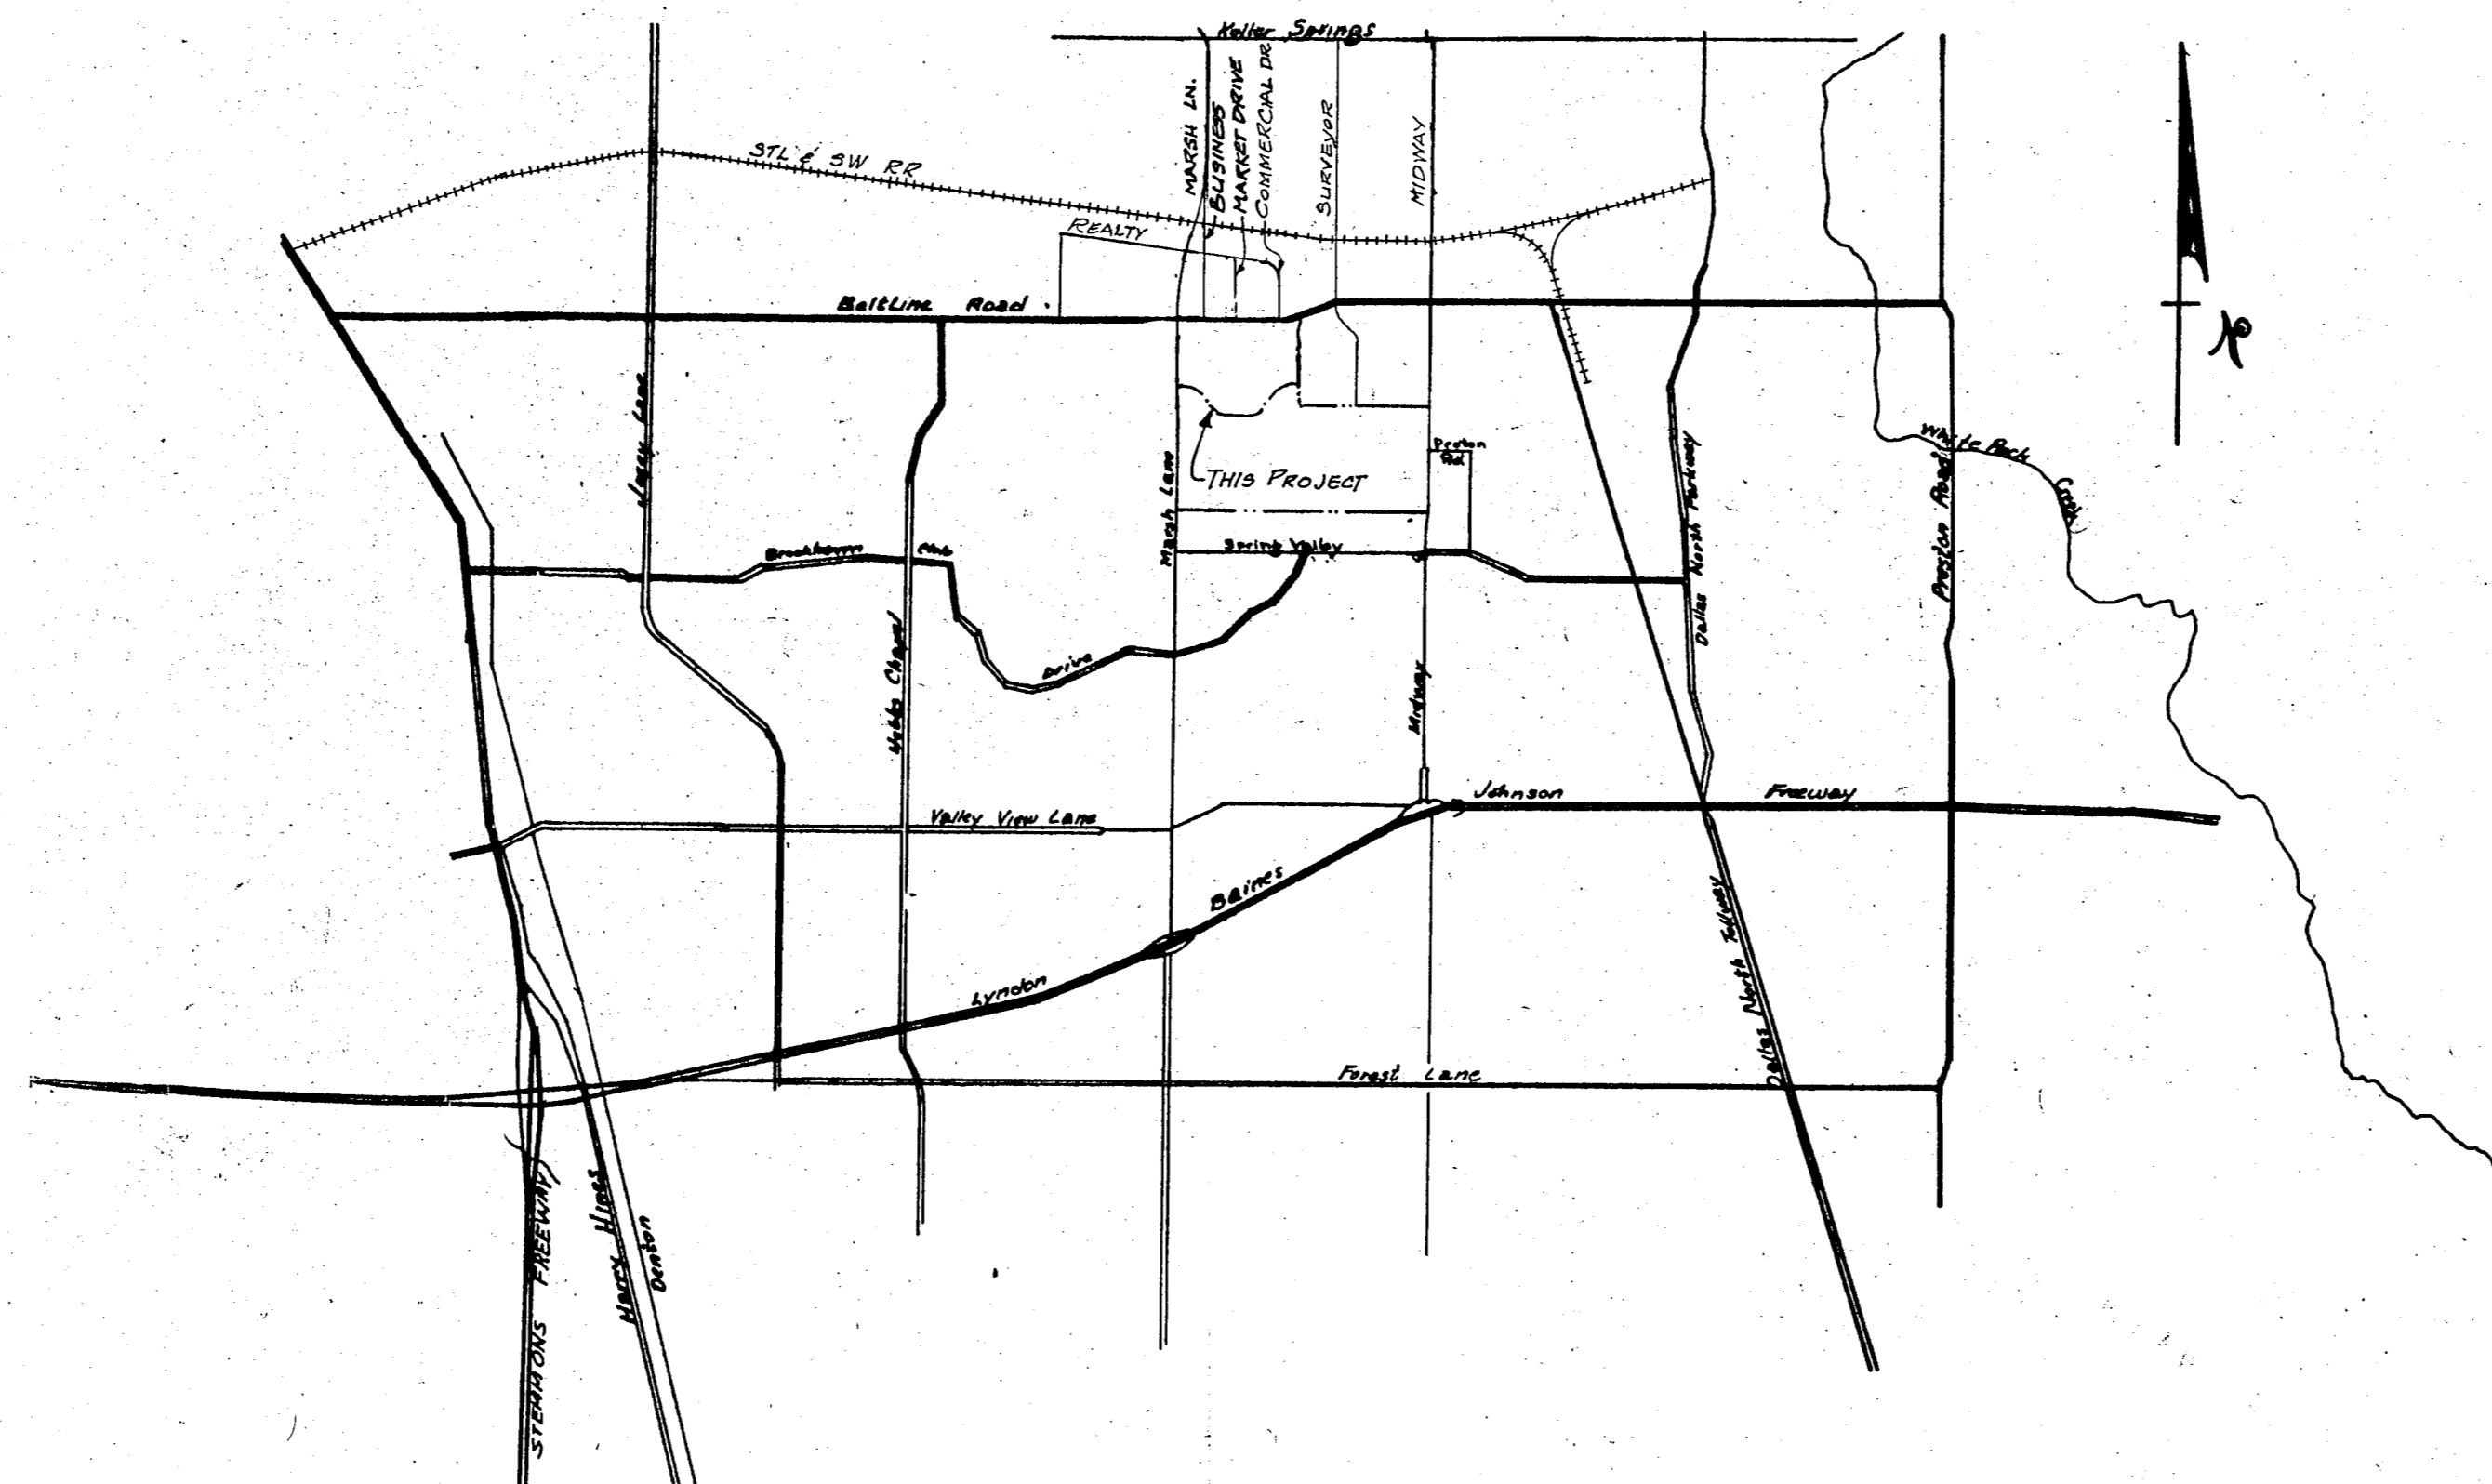

VICINITY MAP

AS BUILT SANITARY SEWER ONLY
DATE 11/23/83

DESIGNED BY

RAYMOND L. GOODSON, JR., INCORPORATED, CONSULTING ENGINEERS
3409 OAK GROVE
528-2200
DALLAS, TEXAS
75204

INDEX

- 1 - COVER SHEET
- 2 - SANITARY SEWER & WATER PLAN
- 3 - SANITARY SEWER PROFILE
- 4 - WATER PROFILE

ACCEPTED:

CONTRACTOR
TEX-CON

OWNER

LES LACS PLAZA JOINT VENTURE

REVISED 9-15-83
REVISED 8-24-83
CONSTRUCTION SET
8/10/83

1/4