


AS BUILT PLANS  
FOR

# TOWN HOMES OF ADDISON

ADDISON, TEXAS

PREPARED FOR:  
ABSTRACT CONSTRUCTION, COMPANY  
11157 ABLE LANE  
DALLAS, TEXAS 72559

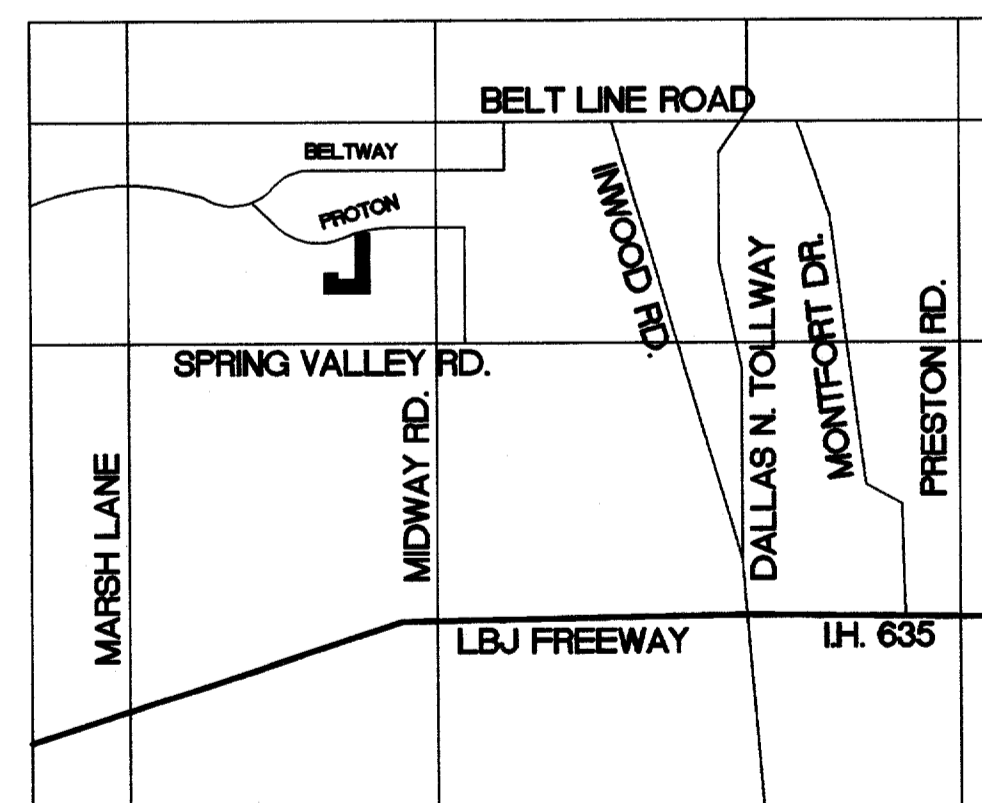

VICINITY MAP  
NOT TO SCALE

**PRECISE LAND SURVEYING INC.,**  
4915 GUS THOMASSON ROAD  
MESQUITE, TEXAS 75150  
(972) 681-7072 FAX (972) 279-1508

INDEX  
SHEET NO. DESCRIPTION

- | SHEET NO. | DESCRIPTION                    |
|-----------|--------------------------------|
| 1         | COVER SHEET                    |
| AB        | AS-BUILT STREETS AND UTILITIES |
| 3         | GRADING PLAN                   |
| 4         | DRAINAGE AREA MAP              |
| 5         | OFF-SITE STORM SEWER           |
| 6         | WATER AND WASTEWATER           |
| 7         | STORM SEWER PROFILES           |
| 8         | STORM SEWER PROFILES           |
| 9         | SANITARY SEWER PROFILES        |
| 10        | SANITARY SEWER PROFILES        |
| 11        | PROTON DR. MODIFICATIONS       |
| 12        | EROSION CONTROL                |
| 13        | DETAILS                        |

NOTE:  
CONSTRUCTION SHOWN ON PLAN SHEETS 3 THRU 13  
IS AS-BUILT PER CONTRACTOR.

FEBRUARY, 1996