


4-5
P328
B28

DEVELOPMENT PLANS FOR TOWN HOMES OF ADDISON

A TOWNHOUSE DEVELOPMENT
IN
ADDISON, TEXAS

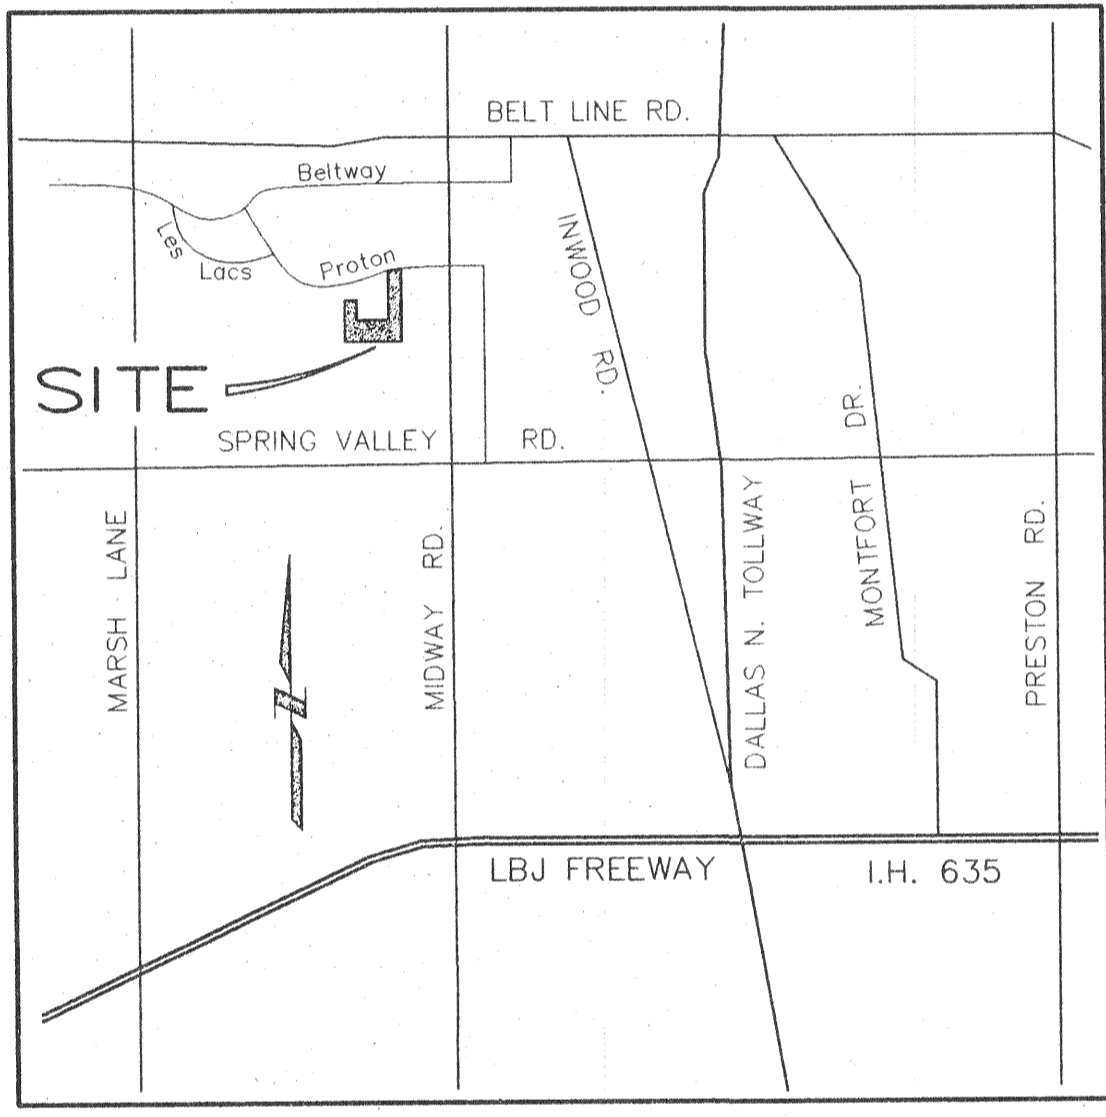

VICINITY MAP
NO SCALE


SHEET NO.	INDEX DESCRIPTION
1	COVER SHEET
2	FINAL PLAT
3	GRADING PLAN
4	DRAINAGE AREA MAP
5	OFF-SITE STORM SEWER
6	WATER & WASTEWATER
7	STORM SEWER PROFILES
8	STORM SEWER PROFILES
9	SANITARY SEWER PROFILES
10	SANITARY SEWER PROFILES
11	PROTON DR. MODIFICATIONS
12	EROSION CONTROL
13 & 14	DETAILS

PREPARED FOR:
RS&B HOMES, LTD.
14901 QUORUM DRIVE, SUITE 500
DALLAS, TEXAS 75240

Cook Consultants, Inc.
CIVIL AND STRUCTURAL ENGINEERING
LAND SURVEYING AND LAND PLANNING
12250 Inwood road • suite 10 dallas, texas 75244
[214] 387-1890 fax [214] 387-8210

MAY 1996

NOTE:
THESE DOCUMENTS, &/OR SPECIFICATIONS MAY
BE USED FOR PURPOSES AS INDICATED BELOW
 COORDINATION & OR PRELIMINARY
 BIDDING ONLY
 PERMITTING
 CONSTRUCTION
UNDER THE AUTHORITY OF JACK C. COOK III
PROFESSIONAL ENGINEER

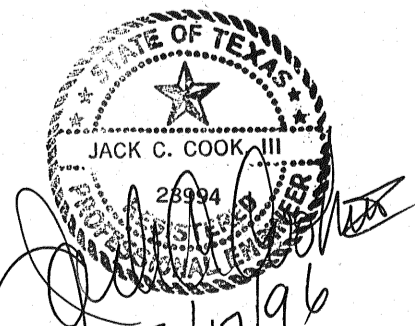

incl. Proton
Modifications

on Proton
Town Homes

GRB

GRB
7-1-96