



LINE D

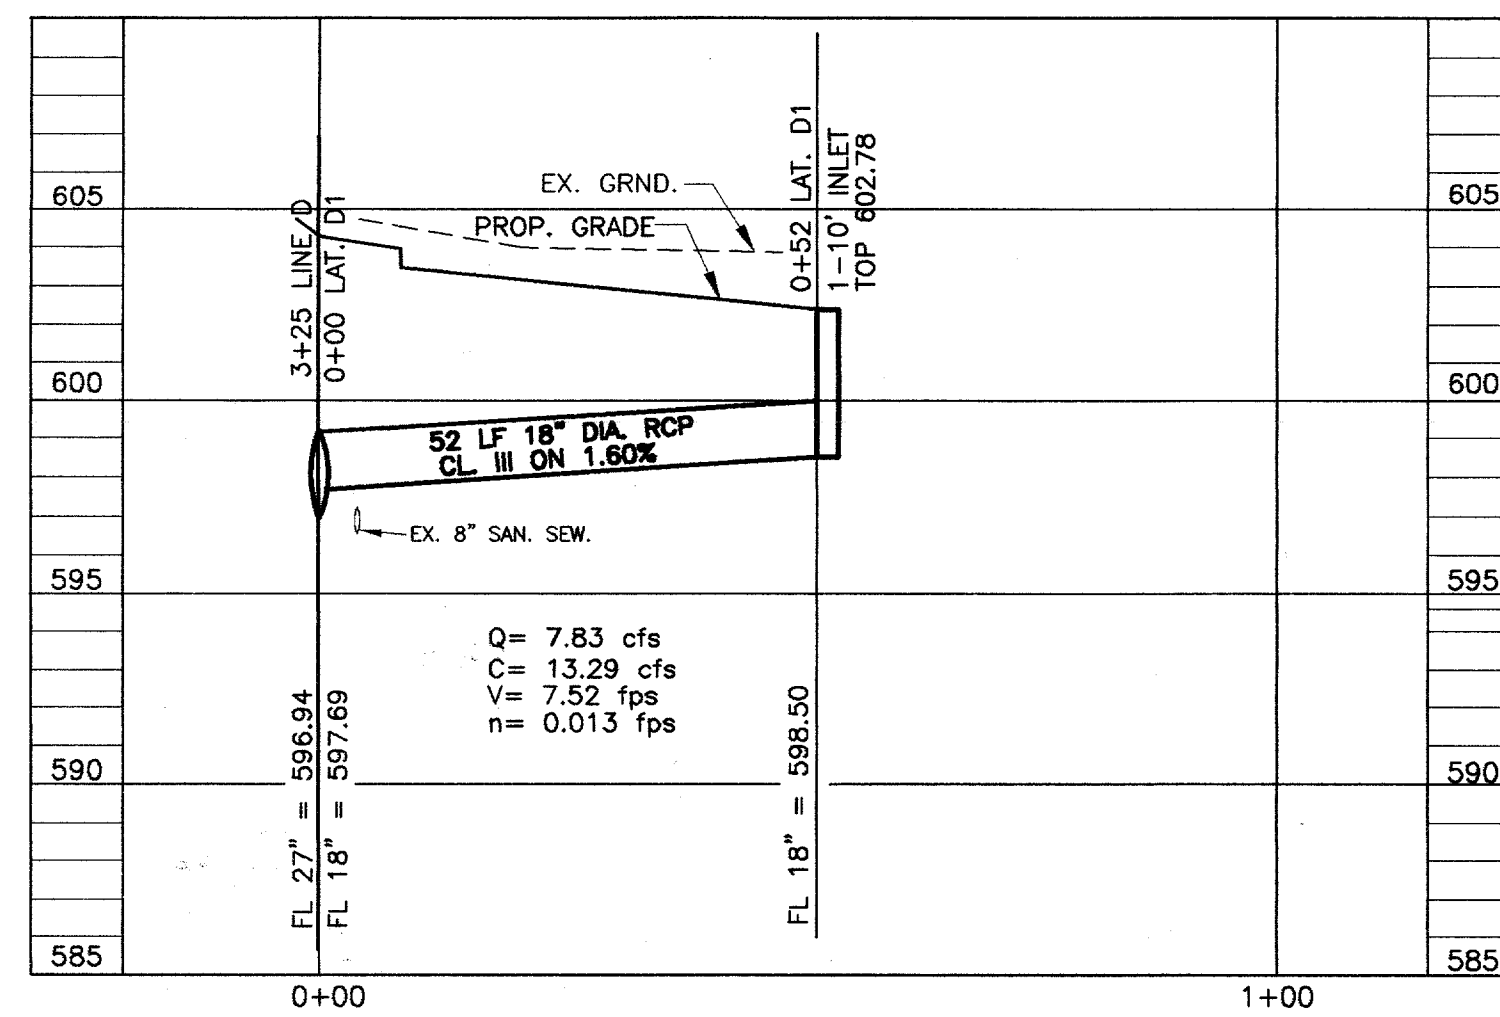

LAT. D1

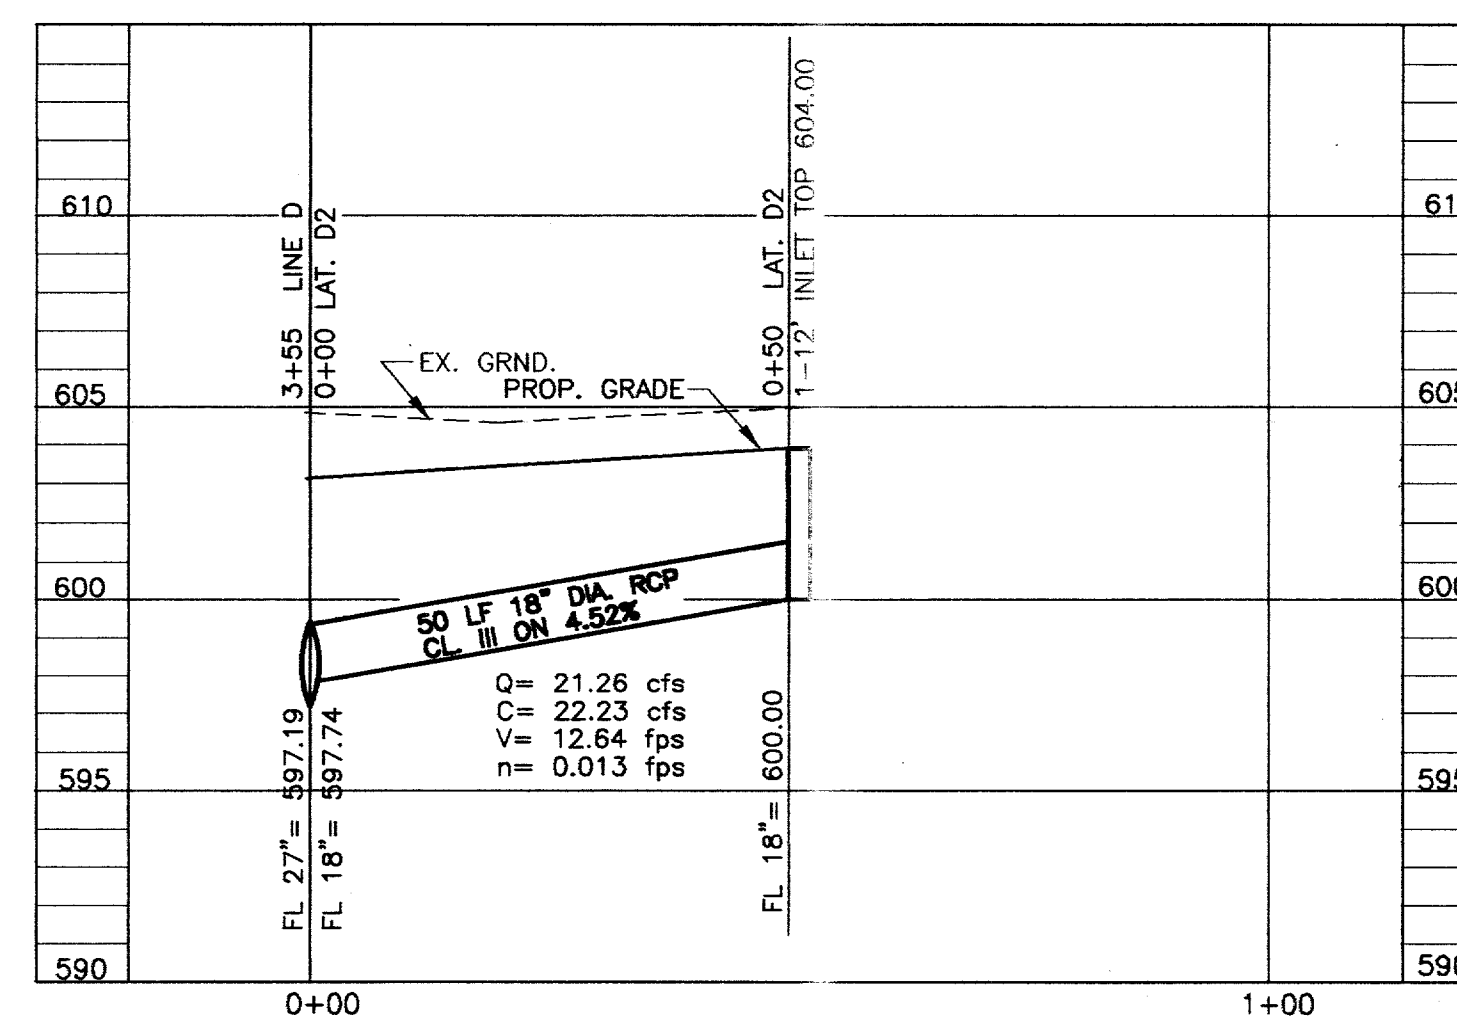

LAT. D2

THE DRAWING, SPECIFICATIONS, AND OTHER DOCUMENTS PREPARED BY COOK CONSULTANTS, INC. FOR THIS PROJECT ARE INSTRUMENTS OF PROFESSIONAL SERVICE, AND AS SUCH, ARE RESERVED AND PROTECTED BY STATUTE. COOK CONSULTANTS, INC. AS AUTHOR RETAINS OWNERSHIP OF THE DOCUMENTS, INCLUDING THE COPYRIGHT. THE DRAWINGS AND OTHER DOCUMENTS MAY NOT BE REPRODUCED OR USED BY ANYONE FOR ANY REASON WITHOUT THE EXPRESS WRITTEN CONSENT OF COOK CONSULTANTS, INC.

THESE DRAWINGS ARE PROVIDED FOR "AS-BUILT" DRAWINGS BY OTHERS FOR THE CITY OF ADDISON

NOTE:

STORM SEWER EMBEDMENT SHALL CONFORM TO THE TOWN OF ADDISON SPECIFICATIONS

STORM SEWER PROFILES						
TOWN HOMES OF ADDISON						
DEPARTMENT OF PUBLIC WORKS						
TOWN OF ADDISON, TEXAS						
DESIGN	DRAWN	DATE	SCALE	NOTES	FILE	NO.
LD	LAC	12/5/95	1"=20'H 1"=5'V	CCI		

REV. NO.	PROJ. NO.	DESCRIPTION	DATE
		ADDED ISLAND TO LINE D REVISED PER CITY COMMENTS	7/11/96 5/03/96

DATE:	PROJECT NO.
	81215-35