


RECOMMEND ISLAND BE INCLUDED IN CONSTRUCTION PLANS. LANDSCAPING MUST MEET SIGHT DISTANCE REQUIREMENTS.

NOTE: THE SITE PLAN SHALL CONFORM TO THE REQUIREMENTS OF THE FINAL PLAT FOR THE TOWN HOMES OF ADDISON AND APPLICABLE ORDINANCES.

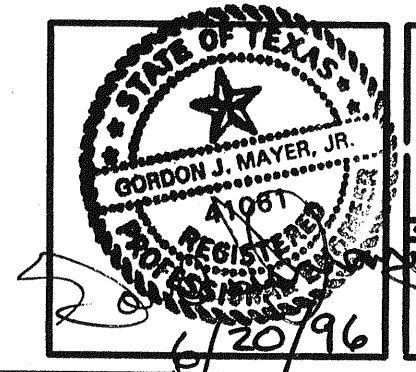

**NDM**

NATHAN D. MAIER  
CONSULTING ENGINEERS, INC.

Three Northpark / 8800 N. Central Expwy. / Suite 300  
Dallas, Texas 75231 / (214) 739-4741

**TRAFFIC SIGNS & MARKINGS PLAN**  
**TOWN HOMES OF ADDISON**

design	drawn	scale	date	notes
DESIGN	DRAWN	1"=40'	6/18/96	NOTES

sheet no.	1
job number	96-5-56

PROJECTS\960505\TRAFFIC Thu Jun 20 14:19:14 1996