



FILE: 9120P52.DGN VI-MAP
 REF. FILE: 9120AL.DGN
 VIEW: WS
 DATE: 10-17-91

RUNOFF COMPUTATIONS

DRAIN. AREA NO.	AC.	ACRES DRAINED				REMARKS
		RES. C-0.5	TOTAL C.A.	T _C MIN.	I ₁₀₀ IN/HR	
1	1.00	0.5	0.50	15	7.52	3.76 TO INLET NO. 1
2	2.10	"	1.05	"	"	7.90 TO INLET NO. 2
3	0.41	"	0.21	"	"	1.54 TO INLET NO. 2
4	0.64	"	0.32	"	"	2.40 TO INLET NO. 4
5	1.79	"	0.90	"	"	6.70 TO INLET NO. 3
6	0.39	"	0.20	"	"	1.47 TO OFFSITE
7	0.66	"	0.33	"	"	2.50 TO OFFSITE
8	0.59	"	0.30	"	"	2.22 TO OFFSITE
9	1.04	"	0.52	"	"	3.91 TO OFFSITE


LEGEND

- ==== PROP. STORM SEWER
- PROP. CURB INLETS
- PROP. CONC. HEADWALL
- EXIST. STORM SEWER
- DRAINAGE AREA DIVIDE
- FLOW ARROW
- 10 DRAINAGE AREA NO.

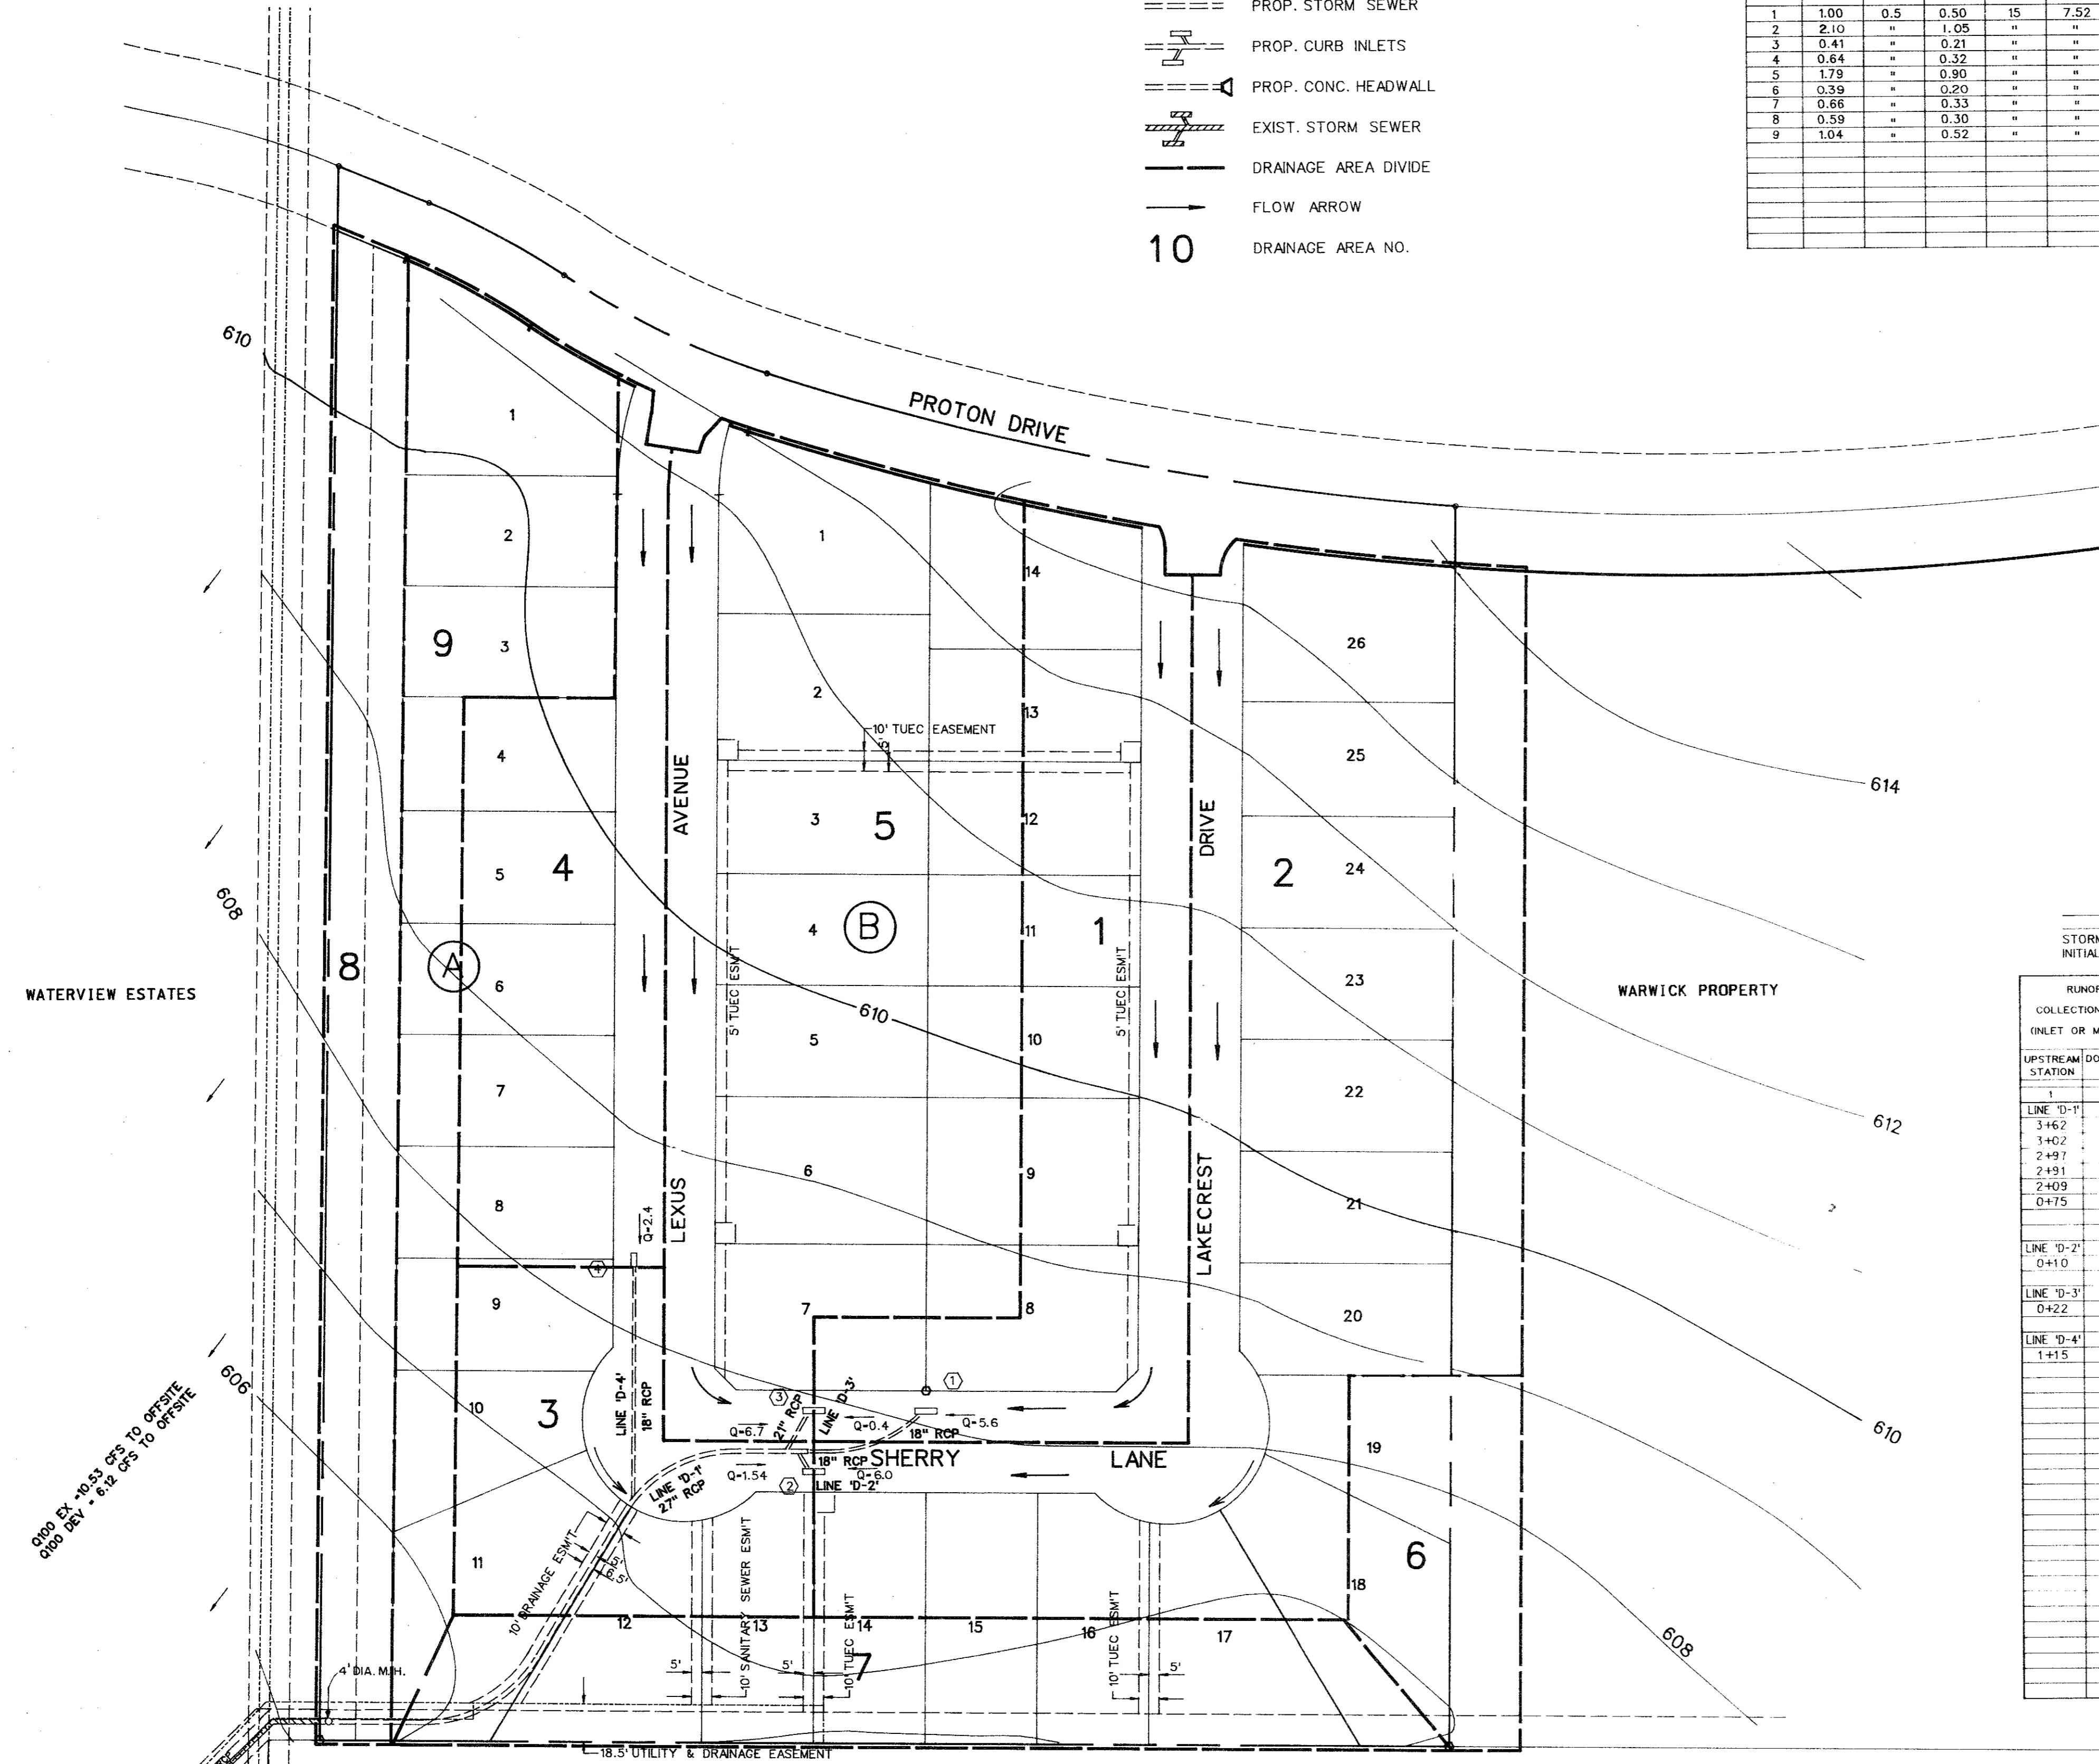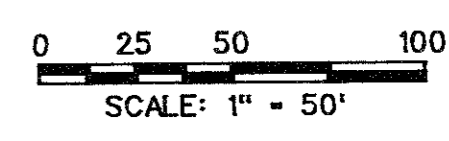

INLET COMPUTATIONS

INLET No	Station	D.A. No	Q _a		Total Q _a	z	z/n	s	y	p	a	q _l	L _r	L _a	L _a /L _r	a/y	Q _l /Q _a Curb	Q _l cfs	Q _l -Q _a cfs	Carry Over cfs	Outer Capacity cfs	Remarks	
			cfs	sq ft																			
1	2	3	4	5	6	7	8	9	10	11	12	13	14	15	16	17	18	19	20	21	22	23	
1	1+29	142	5.6	0.00	5.60	26	1667	0.0075	0.37	8.24	0.33	0.661	0.47	10	1.18	0.91	1.88	6.04	0.00			5.8	LOW POINT
2	0+74	243	7.54	0.00	7.54	26																	LOW POINT
3	0+74	145	7.10	0.00	7.10	26																	
4	0+86	4	2.40	0.00	2.40	26	1667	0.0120	0.24	6.36	0.33	0.543	4.42	6	1.36	1.36	1.18	2.83	0.00			6.9	

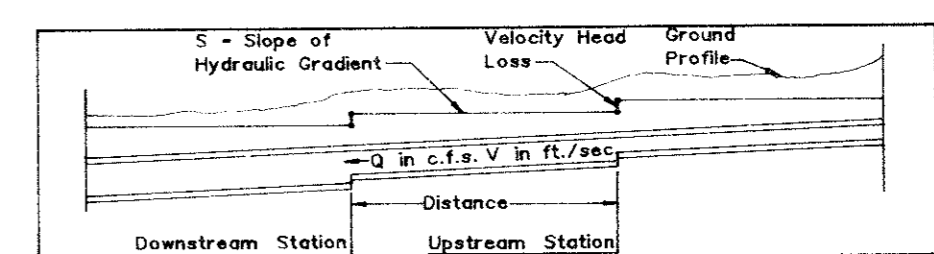

STORM SEWER CALCULATIONS

STORM SEWER LINE INITIAL INLET TIME _____ MINUTES

RUNOFF COLLECTION POINT (INLET OR MANHOLE)	Distance Between Collection Points	INCREMENTAL DRAINAGE AREA				Accum. "CA"	Time at Upstream Station (minutes)	Design Storm Frequency (yrs)	Intensity "i" (inches/hr.)	Storm Water Runoff "q" (c.f.s.)	Slope of Hydraulic Gradient "S" (%)	Selected Storm Sewer Size	Velocity in Sewer Between Collection Points "V" (f.p.s.)	Head Loss Coeff. K _j	Velocity Head Loss at Upstream Station "V ² /2g" (feet)	Flow Time in Sewer Distance "V x 60" (minutes)	Time at Downstream Station (minutes)	Remarks	
		Area No.	Drainage Area (Acres)	Runoff Coeff. "C"	Incremental "CA"														
LINE D-1 3+62	0+00	10	28.3	1.84	0.5	0.92	0.92	15.00	100	7.52	6.9	0.372	18"	6.0	1.25	0.71	0.03	15.03	
LINE D-2 0+10	0+00	10	28.3	1.84	0.5	0.92	0.92	15.00	100	7.52	6.9	0.372	18"	6.0	1.25	0.71	0.03	15.03	
LINE D-3 0+22	0+00	22	18.5	1.89	0.5	0.94	0.94	15.00	100	7.52	7.1	0.171	21"	6.1	1.25	0.72	0.06	15.06	
LINE D-4 1+15	0+00	115	4	0.64	0.5	0.32	0.32	15.00	100	7.52	2.4	0.045	18"	4.9	1.25	0.47	0.39	15.39	



The seal appearing on this document was authorized by James E. Harrington, P.E. 69239, on October 17, 1991

AS-BUILT (FEB. 1992)

CORWIN ENGINEERING, INC.
 3023 Routh Street Dallas, Texas 75201 (214) 220-9136

DEVELOPMENT PLANS FOR
 LES LACS I
 ADDISON, TEXAS

DRAINAGE AREA MAP

DRAWN BY JEH	DESIGNED BY CEI	CHECKED BY WLC	SHEET NO. 3 of 19
JOB NUMBER 9120	DATE OCTOBER 1991	SCALE: 1" = 50'	