


CITY OF ADDISON DALLAS COUNTY, TEXAS

CONSTRUCTION PLANS FOR:

LINDBERG ROAD EXTENSION

FROM ADDISON RD. TO 1,635 FEET WEST
PROJECT LENGTH 1,635 FEET ±

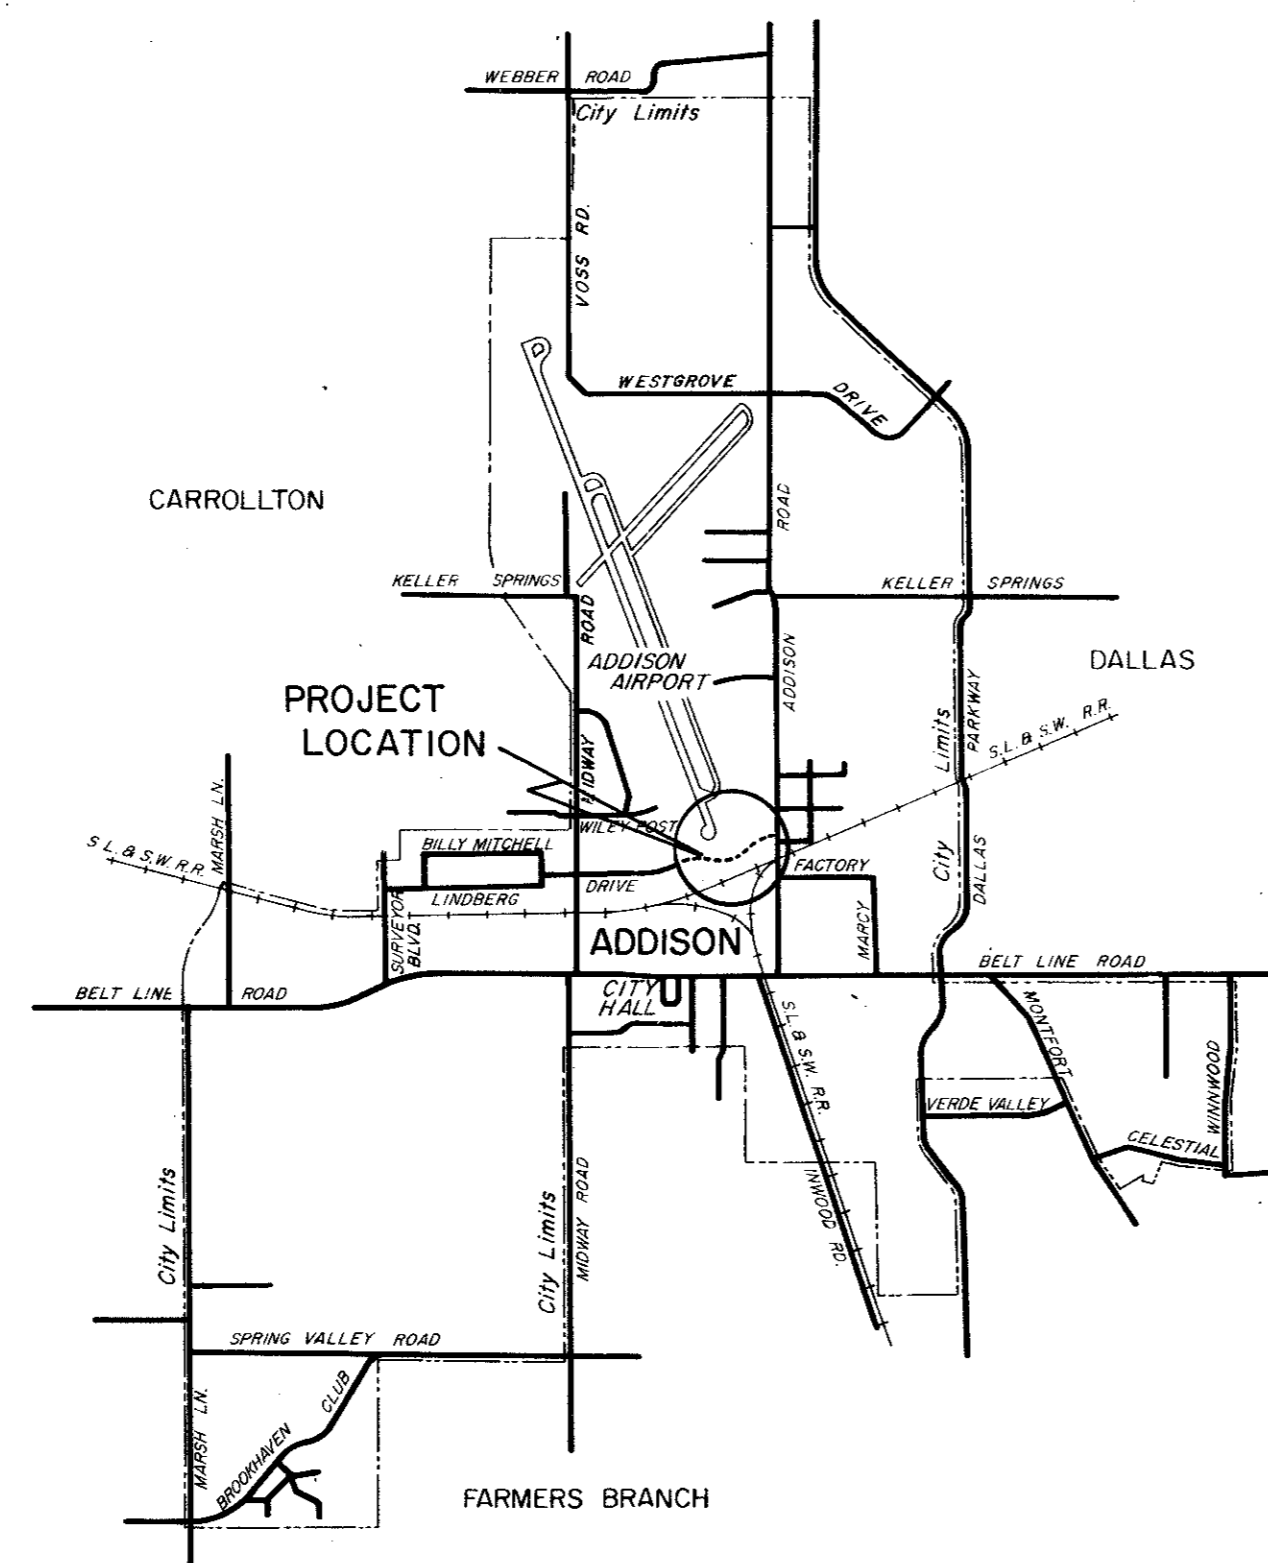

JERRY J. REDDING - MAYOR
COUNCILMEN:

JOHN B. ALLEN
RICHARD RÖDER
WILLIAM F. SELLMAYER
JACK DINGLER
TERRY ROBERTS
C.J. WEBSTER - CITY ADMINISTRATOR
DON PREECE - DIRECTOR OF PUBLIC WORKS

GINN  **INC.**
CONSULTING ENGINEERS
DALLAS, TEXAS

Record Drawing 4/9/85

CITY OF ADDISON

APPROVED BY:  MAYOR

DATE: November 3, 1980