

CHANNEL CURVE DATA

$\Delta = 37^\circ 52' 57''$
 $R = 325'$
 $T = 111.53'$
 $L = 214.88'$

CHANNEL CURVE DATA


$\Delta = 79^\circ 12' 08''$
 $R = 71.5'$
 $T = 59.15'$
 $L = 98.84'$

CHANNEL CURVE DATA

$\Delta = 75^\circ 21' 42''$
 $R = 44.62'$
 $T = 34.46'$
 $L = 58.68'$


CHANNEL CURVE DATA

$\Delta = 67^\circ 00' 00'' \pm$
 $R = 50'$
 $T = 33.09'$
 $L = 58.47'$

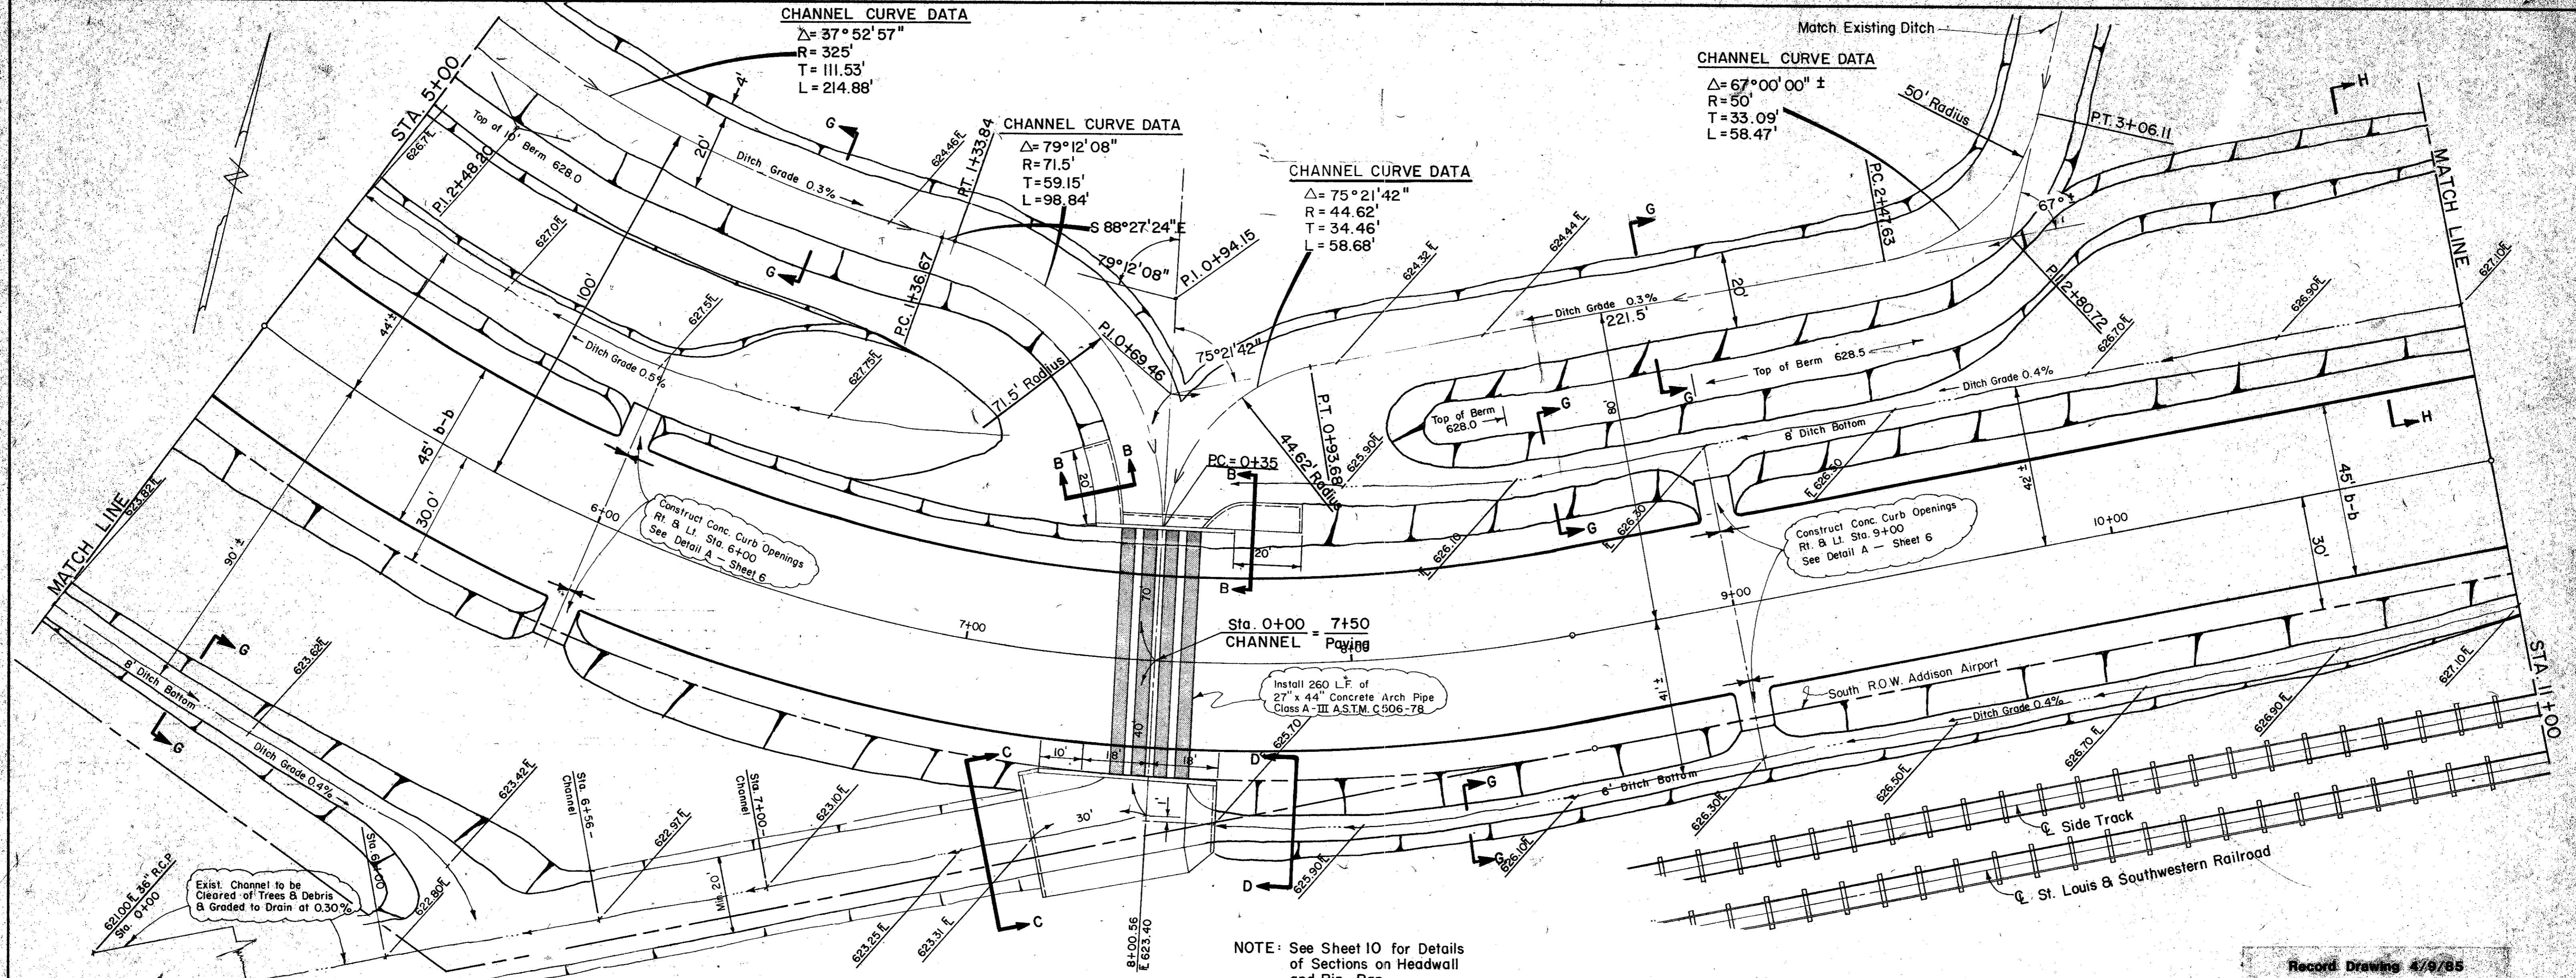

NOTE: See Sheet 10 for Details of Sections on Headwall and Rip-Rap.

Record Drawing 4/9/85

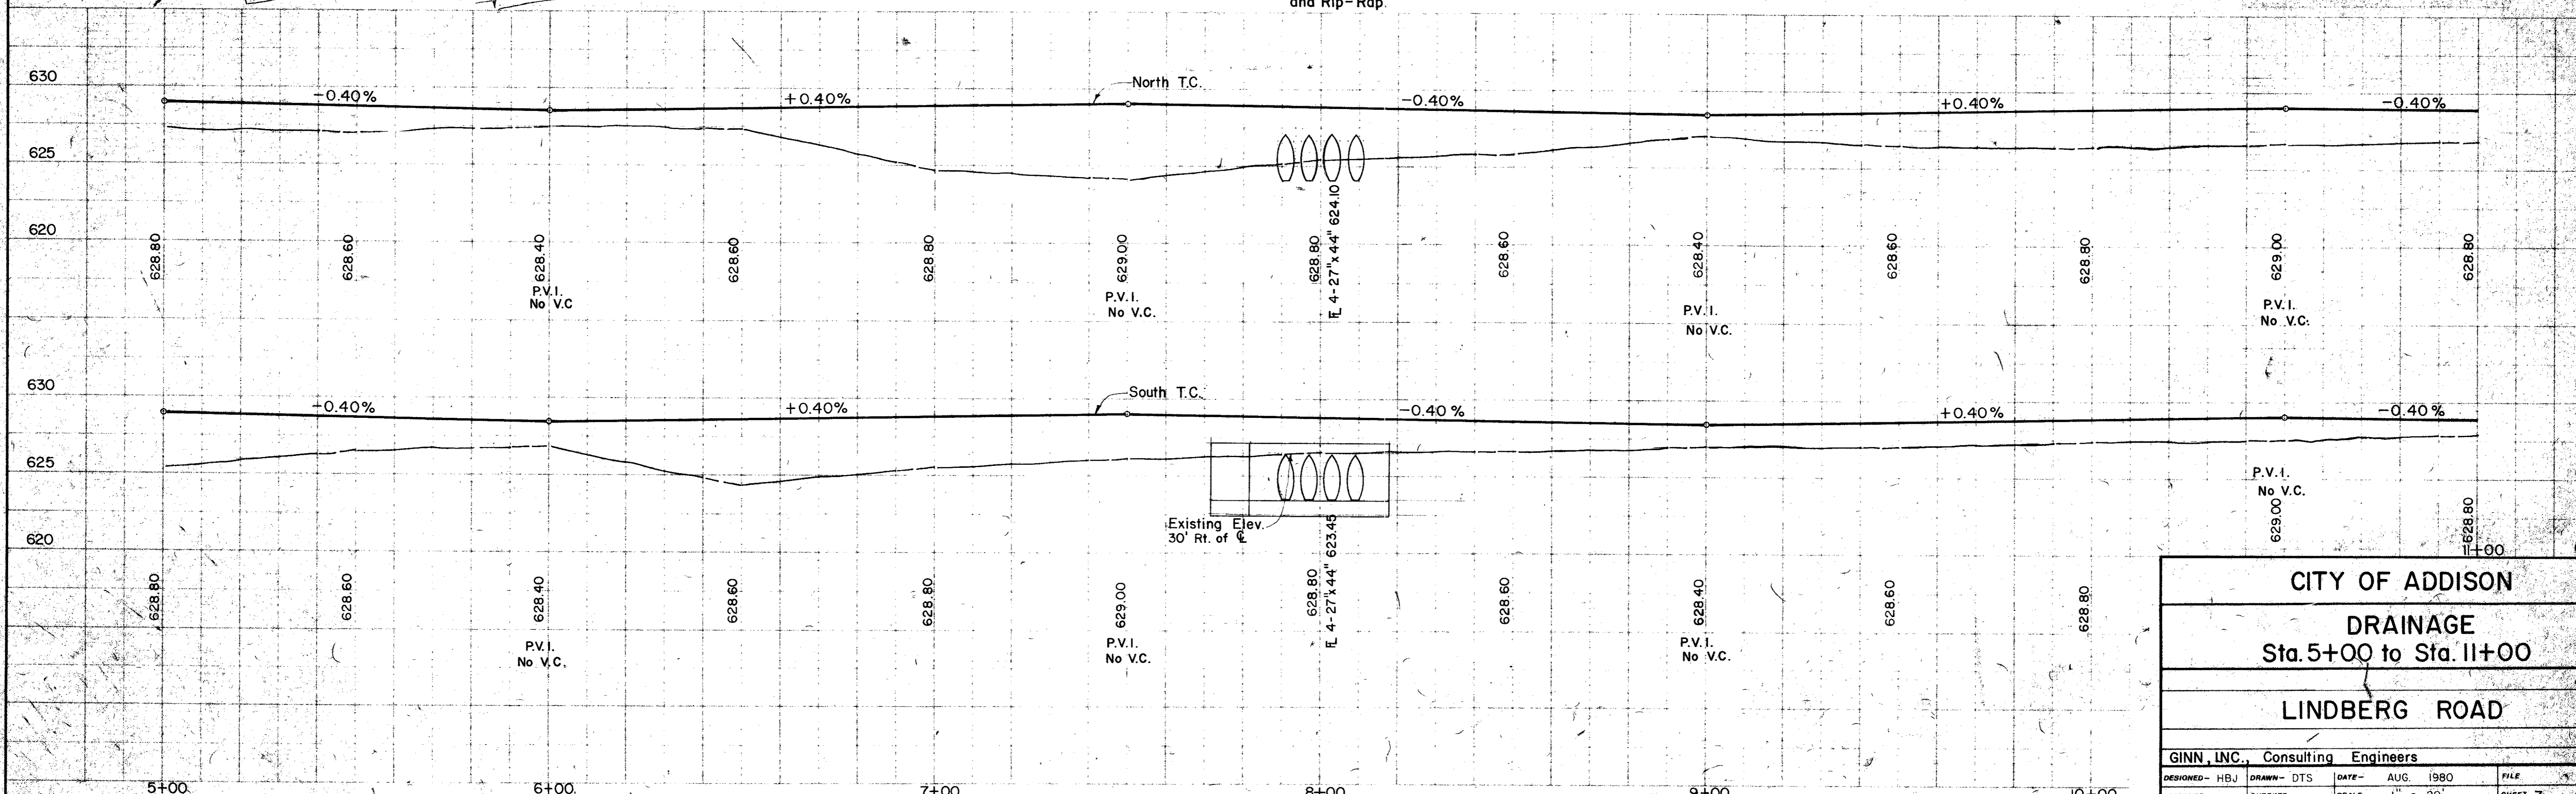

CITY OF ADDISON			
DRAINAGE			
Sta. 5+00 to Sta. 11+00			
LINDBERG ROAD			
GINN, INC., Consulting Engineers			
DESIGNED - HBJ	DRAWN - DTS	DATE - AUG. 1980	FILE
APPROVED -	CHECKED -	SCALE - 1" = 20'	SHEET 7 OF 17