


Record Drawing 4/9/85

B.M. #3 " On Corner of Loading Dock at Howard Green
 Furniture #5288 Addition Road. (Elev. 629.854.)

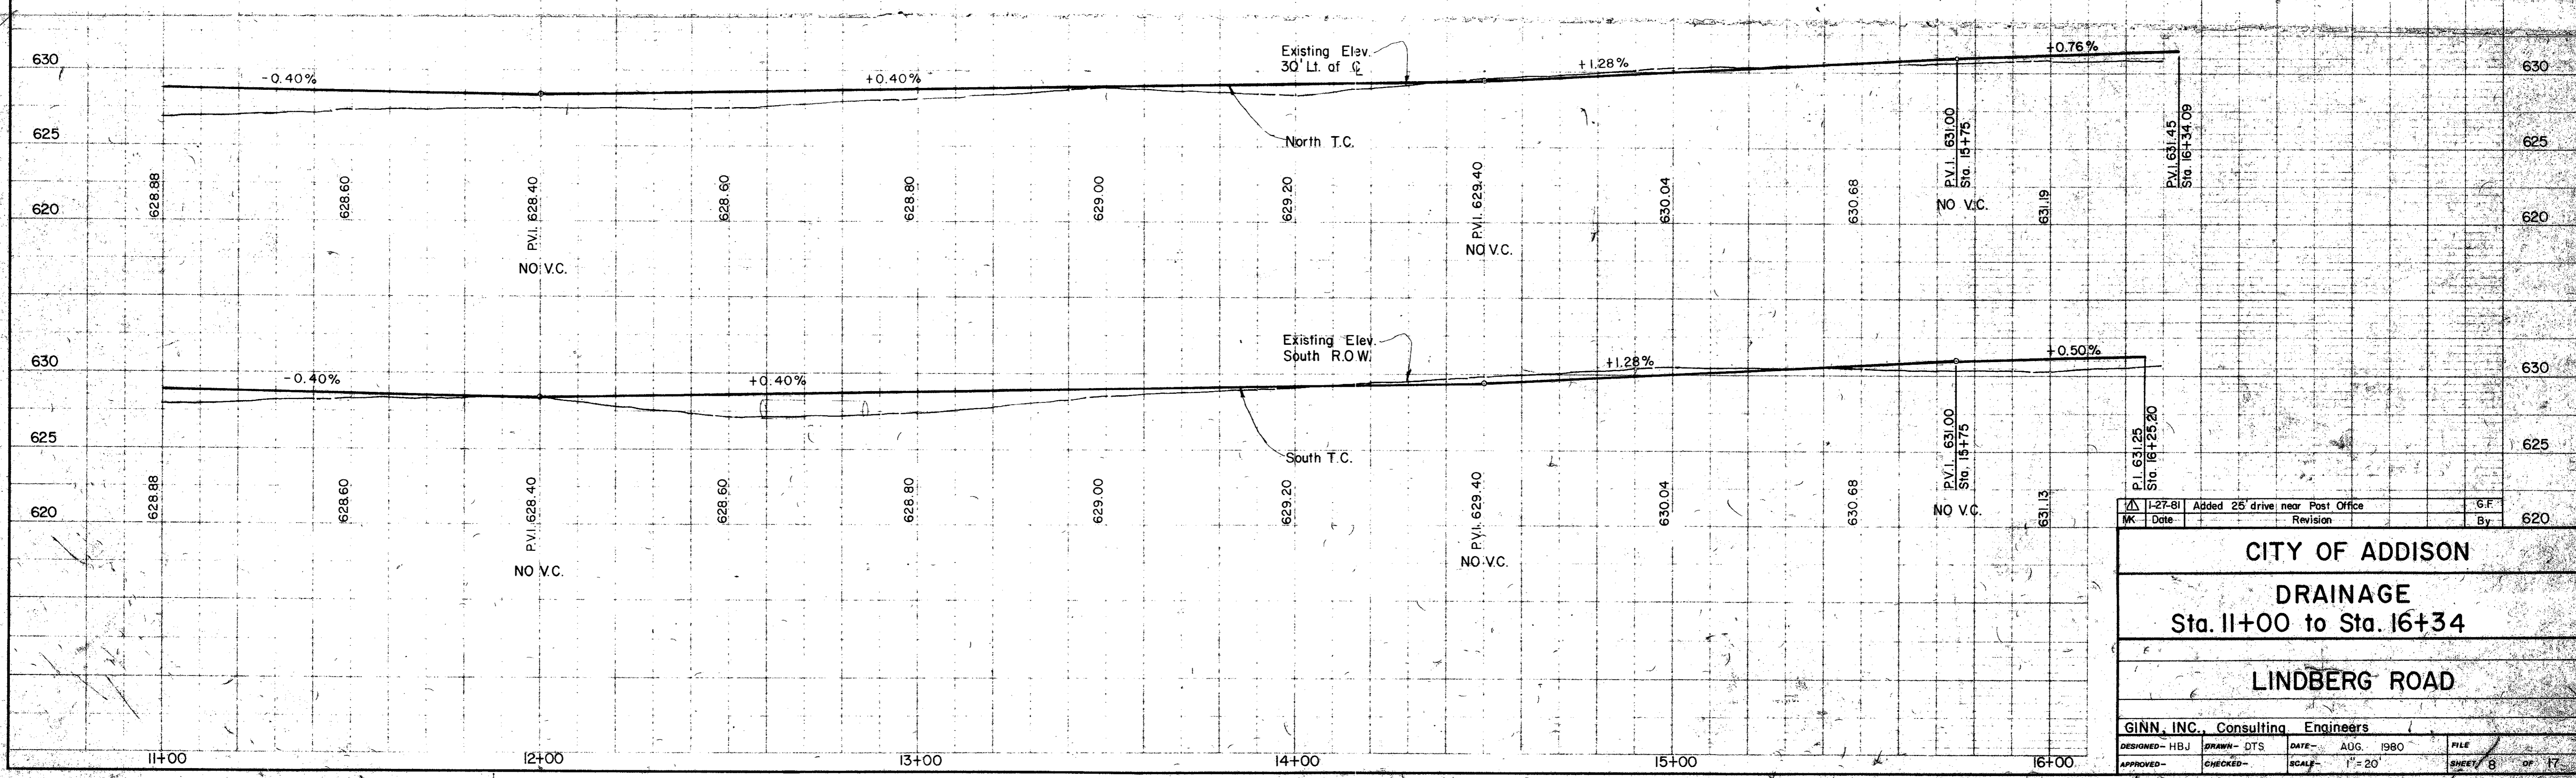

1-27-81	Added 25' drive near Post Office	G.F.
Date	Revision	By

CITY OF ADDISON

DRAINAGE
Sta. 11+00 to Sta. 16+34

LINDBERG ROAD

GINN, INC., Consulting Engineers

DESIGNED- HBJ DRAWN- DTS DATE- AUG. 1980 FILE

APPROVED- CHECKED- SCALE- 1" = 20' SHEET 8 OF 17