


Record Drawing 4/9/85
 B.M. #1 "X" CUT ON N.W. CORNER INLET 105'± S. OF LINDBERG & ELEV. 630.75
 B.M. #3 "O" On Corner of Loading Dock at Howard Green Furniture - 15289 Addison Road (Elev. 629.854)

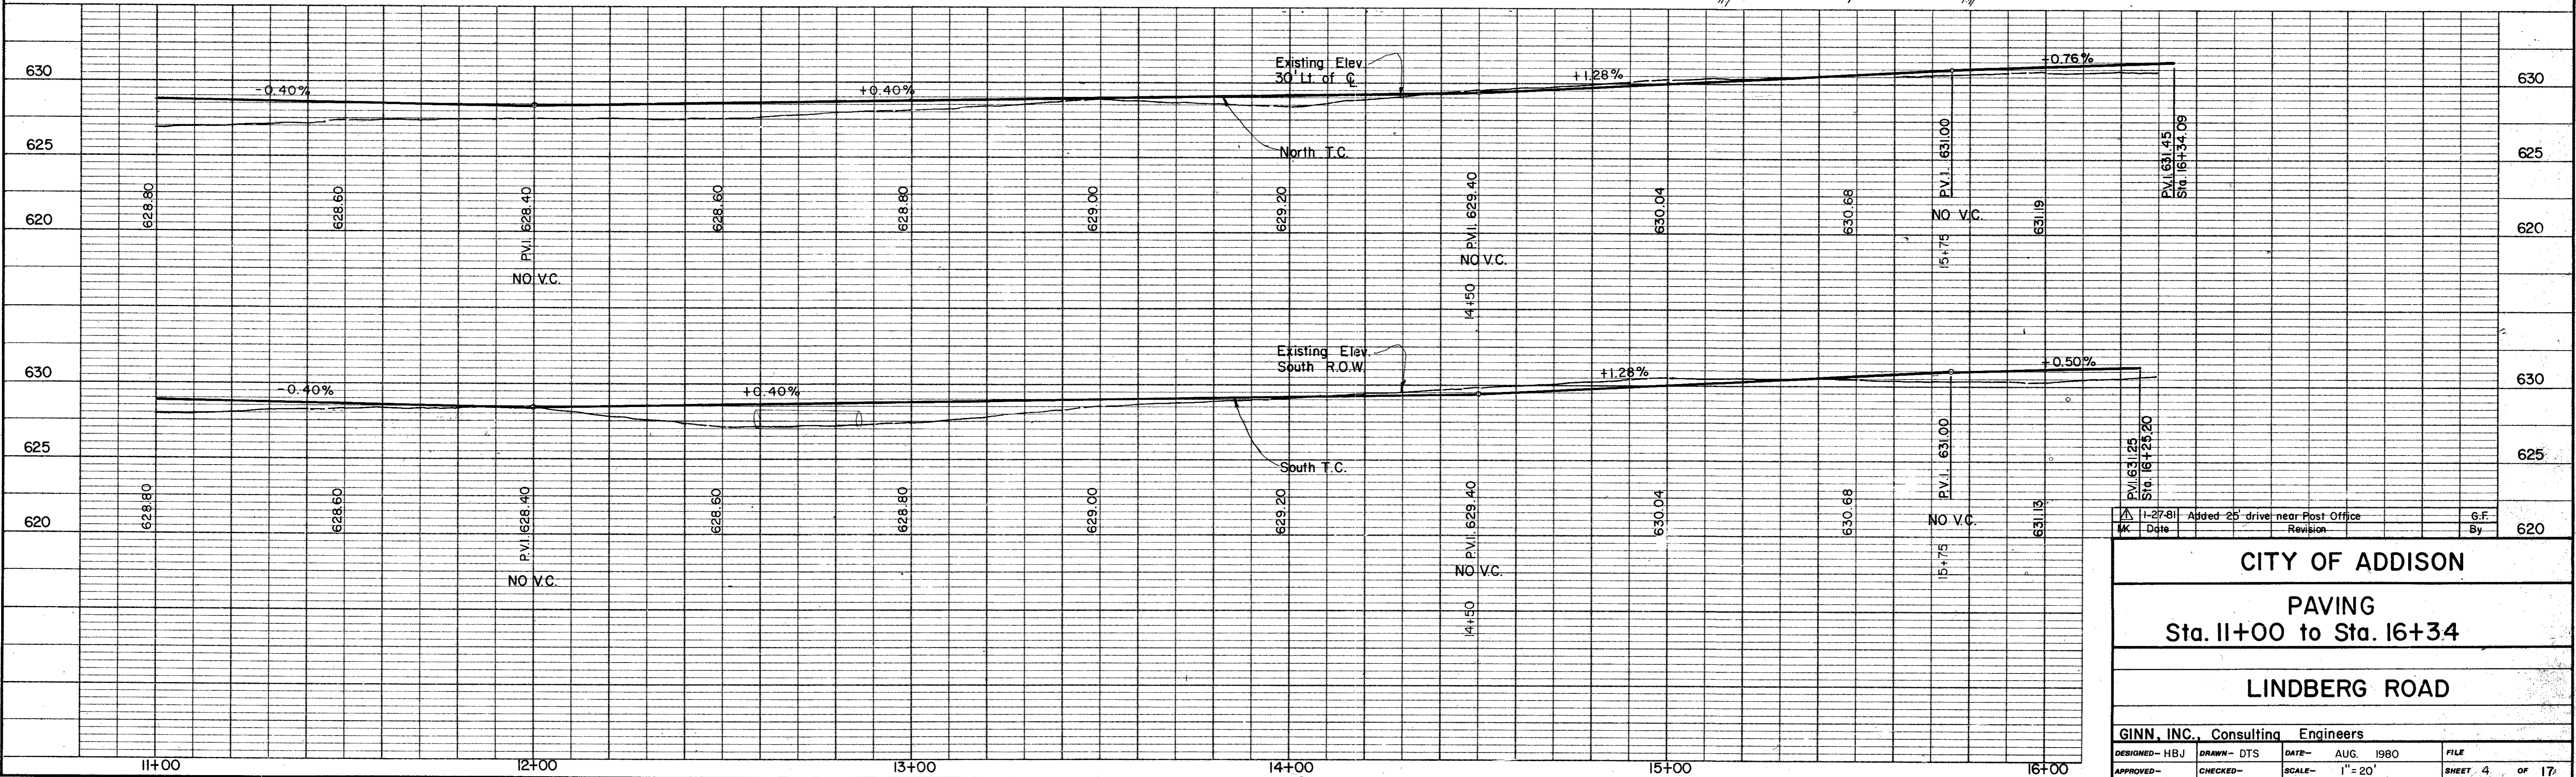

CITY OF ADDISON			
PAVING			
Sta. 11+00 to Sta. 16+34			
LINDBERG ROAD			
GINN, INC., Consulting Engineers			
DESIGNED - HBJ	DRAWN - DTS	DATE - AUG. 1980	FILE
APPROVED -	CHECKED -	SCALE - 1" = 20'	SHEET 4 OF 17