


☐ CURVE DATA
 $\Delta=63^{\circ}19'10''$
 $R=425'$
 $T=262.07'$
 $L=469.68'$

☐ CURVE DATA
 $\Delta=60^{\circ}00'00''$
 $R=333'$
 $T=192.26'$
 $L=348.72'$

- LEGEND**
- ⊙ Bench Mark
 - ⊕ Hub and Tack
 - + I.P. Iron Pin
 - C.M.W. Monument
 - ⊕ Gas Meter
 - ⊕ Gas Valve
 - Gas Line
 - Power Pole (typical pole symbol)
 - Power Line
 - Clay Wire and Anchor
 - Telephone Cable Box, or Riser
 - Telephone Line
 - Water Meter
 - Water Line
 - Water Valve
 - Fire Hydrant
 - Water Spigot
 - Manhole
 - Cleanout
 - Drainage Inlet
 - Sanitary Sewer Line
 - Storm Sewer Line
 - Fence Line
 - Flow Direction Indicator
 - Property or Right-of-Way Line
 - Easement Line

GENERAL NOTE
 I. CONTRACTOR SHALL RELOCATE PROPOSED CENTERLINE AND PROPERTY LINES PRIOR TO ANY CONSTRUCTION.

Record Drawing 4/9/85

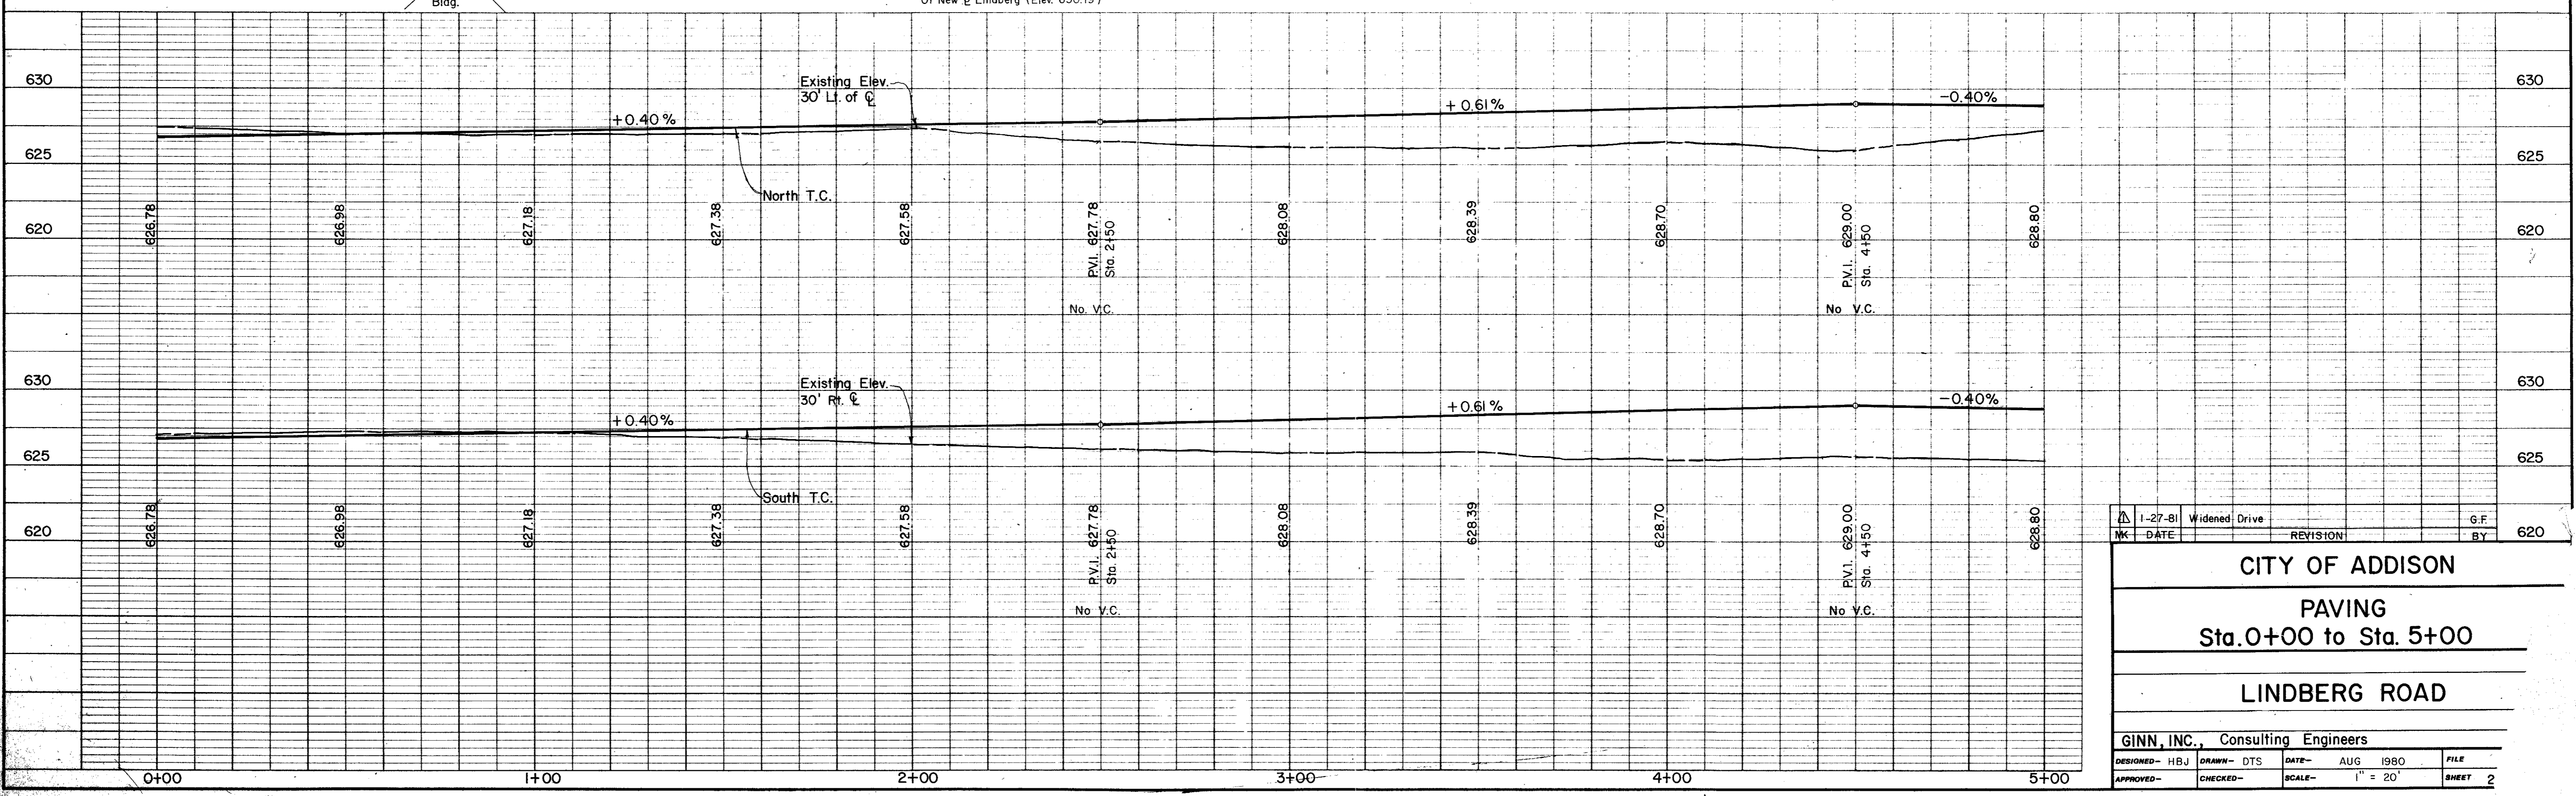

DESIGNED - HBJ	DRAWN - DTS	DATE - AUG 1980	FILE
APPROVED -	CHECKED -	SCALE - 1" = 20'	SHEET 2

CITY OF ADDISON
PAVING
Sta. 0+00 to Sta. 5+00
LINDBERG ROAD

GINN, INC., Consulting Engineers