



**℄ CURVE DATA**

Δ = 63° 19' 10"  
 R = 425'  
 T = 262.07'  
 L = 469.68'

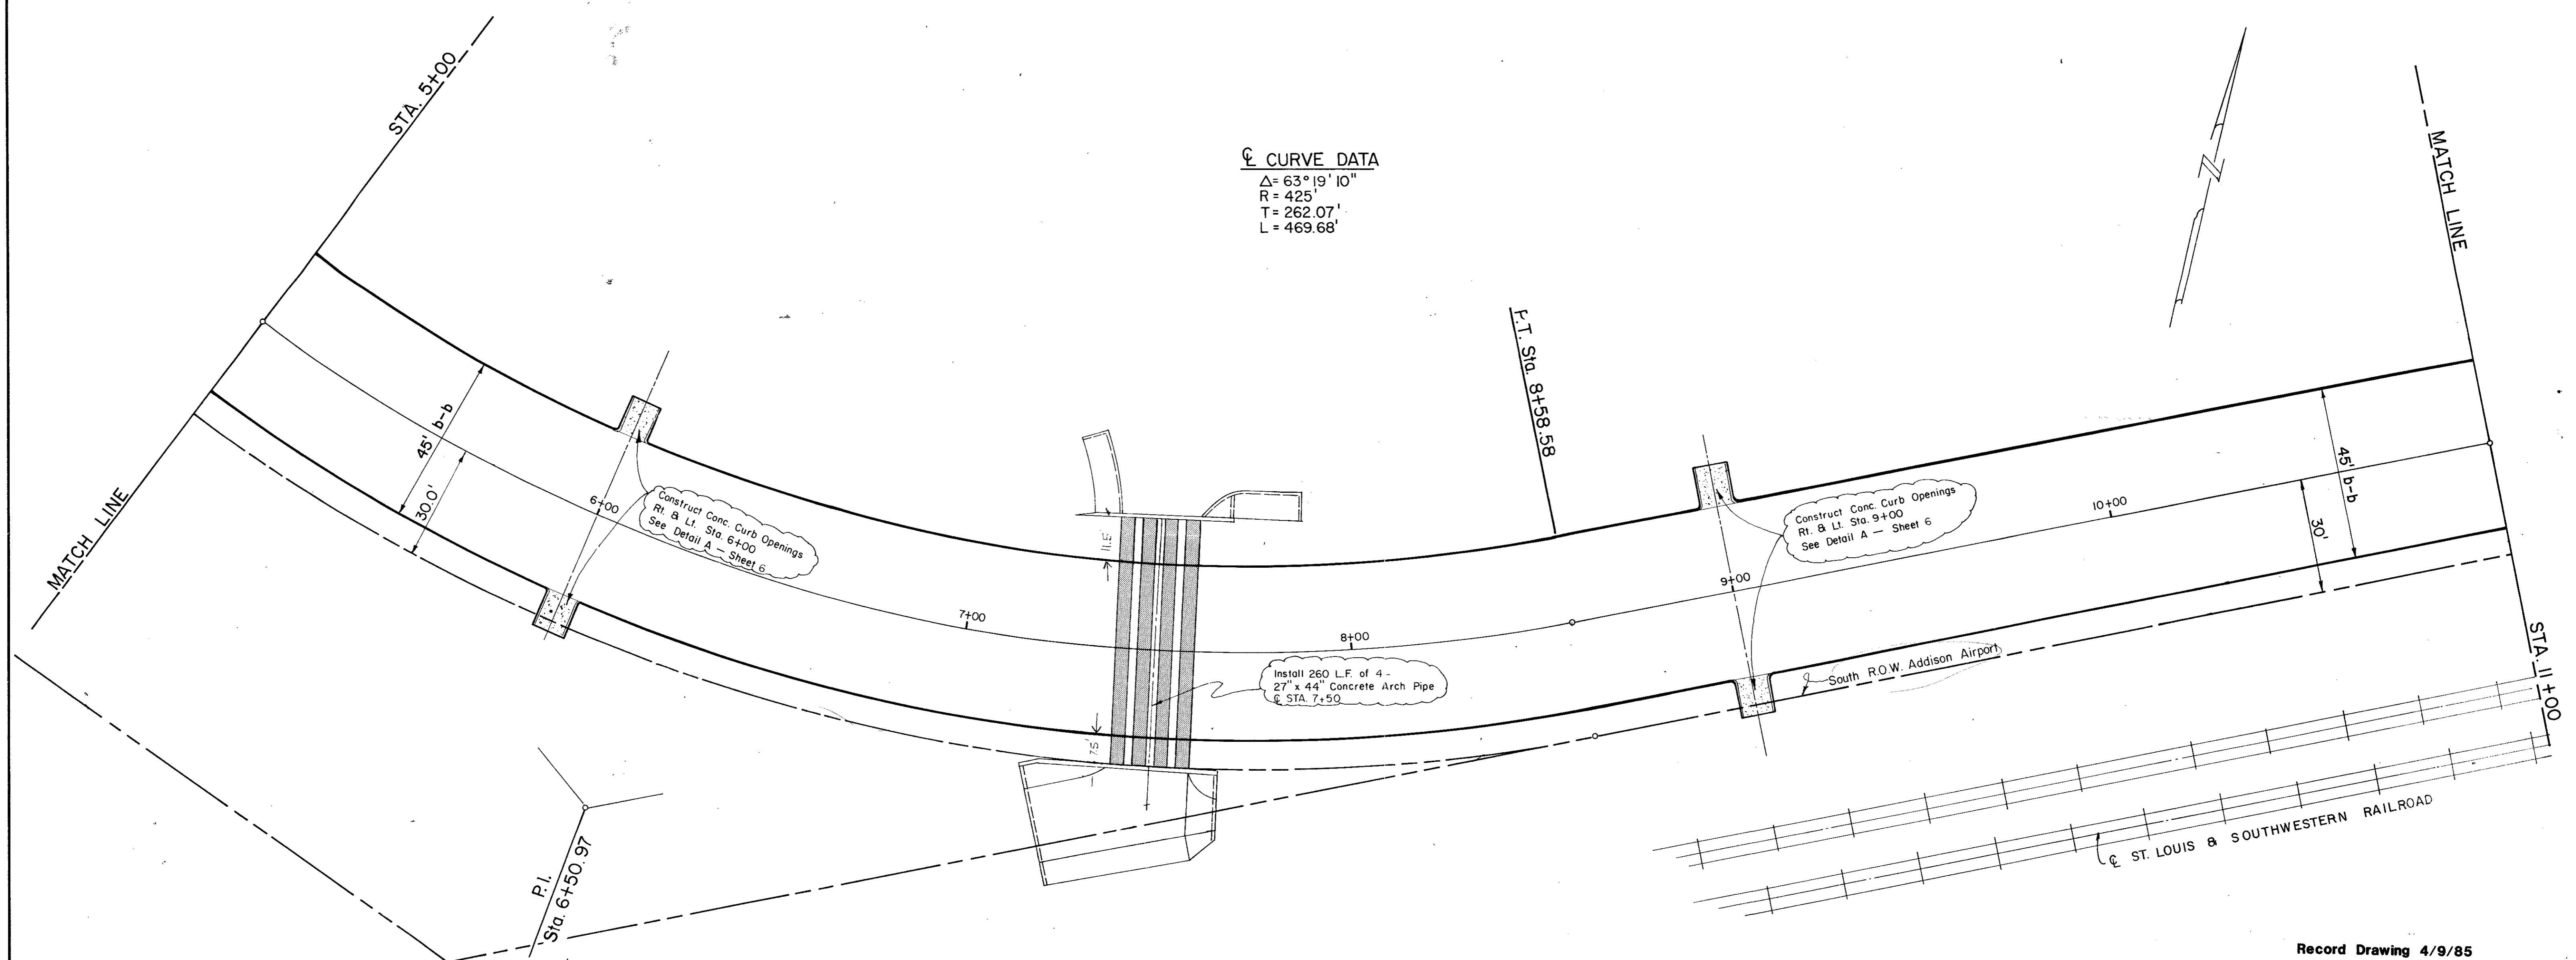

Record Drawing 4/9/85

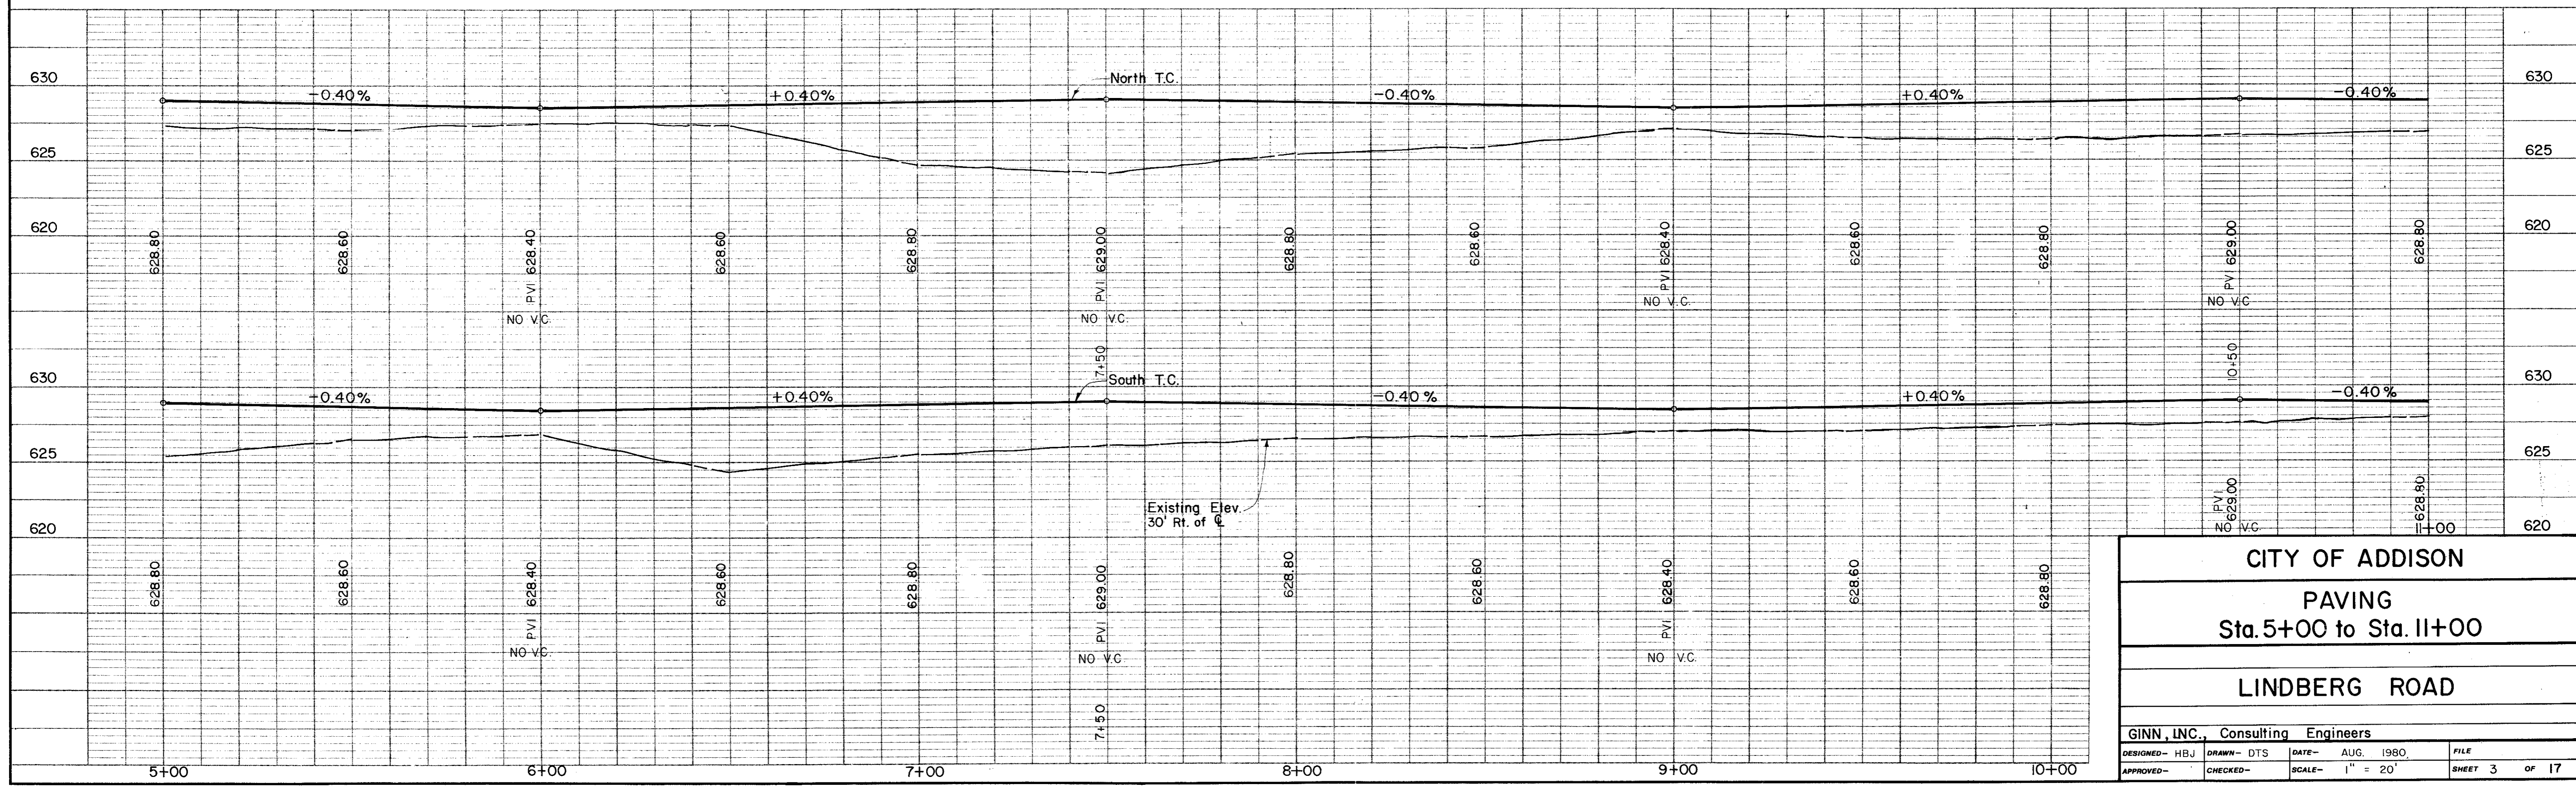

<b>CITY OF ADDISON</b>			
<b>PAVING</b>			
<b>Sta. 5+00 to Sta. 11+00</b>			
<b>LINDBERG ROAD</b>			
<b>GINN, INC., Consulting Engineers</b>			
DESIGNED - HBJ	DRAWN - DTS	DATE - AUG. 1980	FILE
APPROVED -	CHECKED -	SCALE - 1" = 20'	SHEET 3 OF 17