

☉ CURVE DATA
 $\Delta=63^{\circ}19'10''$
 $R=425'$
 $T=262.07'$
 $L=469.68'$


☉ CURVE DATA
 $\Delta=60^{\circ}00'00''$
 $R=333'$
 $T=192.26'$
 $L=348.72'$

- LEGEND**
- ⊙ Bench Mark
 - ⊕ Hub and Tack
 - ⊕ Iron Pin
 - ⊕ Monument
 - ⊕ Gas Meter
 - ⊕ Gas Valve
 - ⊕ Gas Line
 - ⊕ Power Pole (typical pole symbol)
 - ⊕ Power Line
 - ⊕ Telephone Cable Box or Riser
 - ⊕ Telephone Line
 - ⊕ Water Meter
 - ⊕ Water Valve
 - ⊕ Water Line
 - ⊕ Fire Hydrant
 - ⊕ Water Spout
 - ⊕ Manhole
 - ⊕ Cleanout
 - ⊕ Drainage Inlet
 - ⊕ Sanitary Sewer Line
 - ⊕ Storm Sewer Line
 - ⊕ Fence Line
 - ⊕ Flow Direction Indicator
 - ⊕ Property or Right-of-Way Line
 - ⊕ Easement Line

GENERAL NOTE
 I. CONTRACTOR SHALL RELOCATE PROPOSED CENTERLINE AND PROPERTY LINES PRIOR TO ANY CONSTRUCTION.

Record Drawing 4/9/85

B.M. # 1 - □ On Conc. Walk At S.E. Corner Of Bld. At 15301 Midway Rd. (Elev. 621.43)
 B.M. # 2 - □ Open-Nut Of F.H. At Sta. 0+35, 30.5' Lt. Of New ☉ Lindberg (Elev. 630.19)

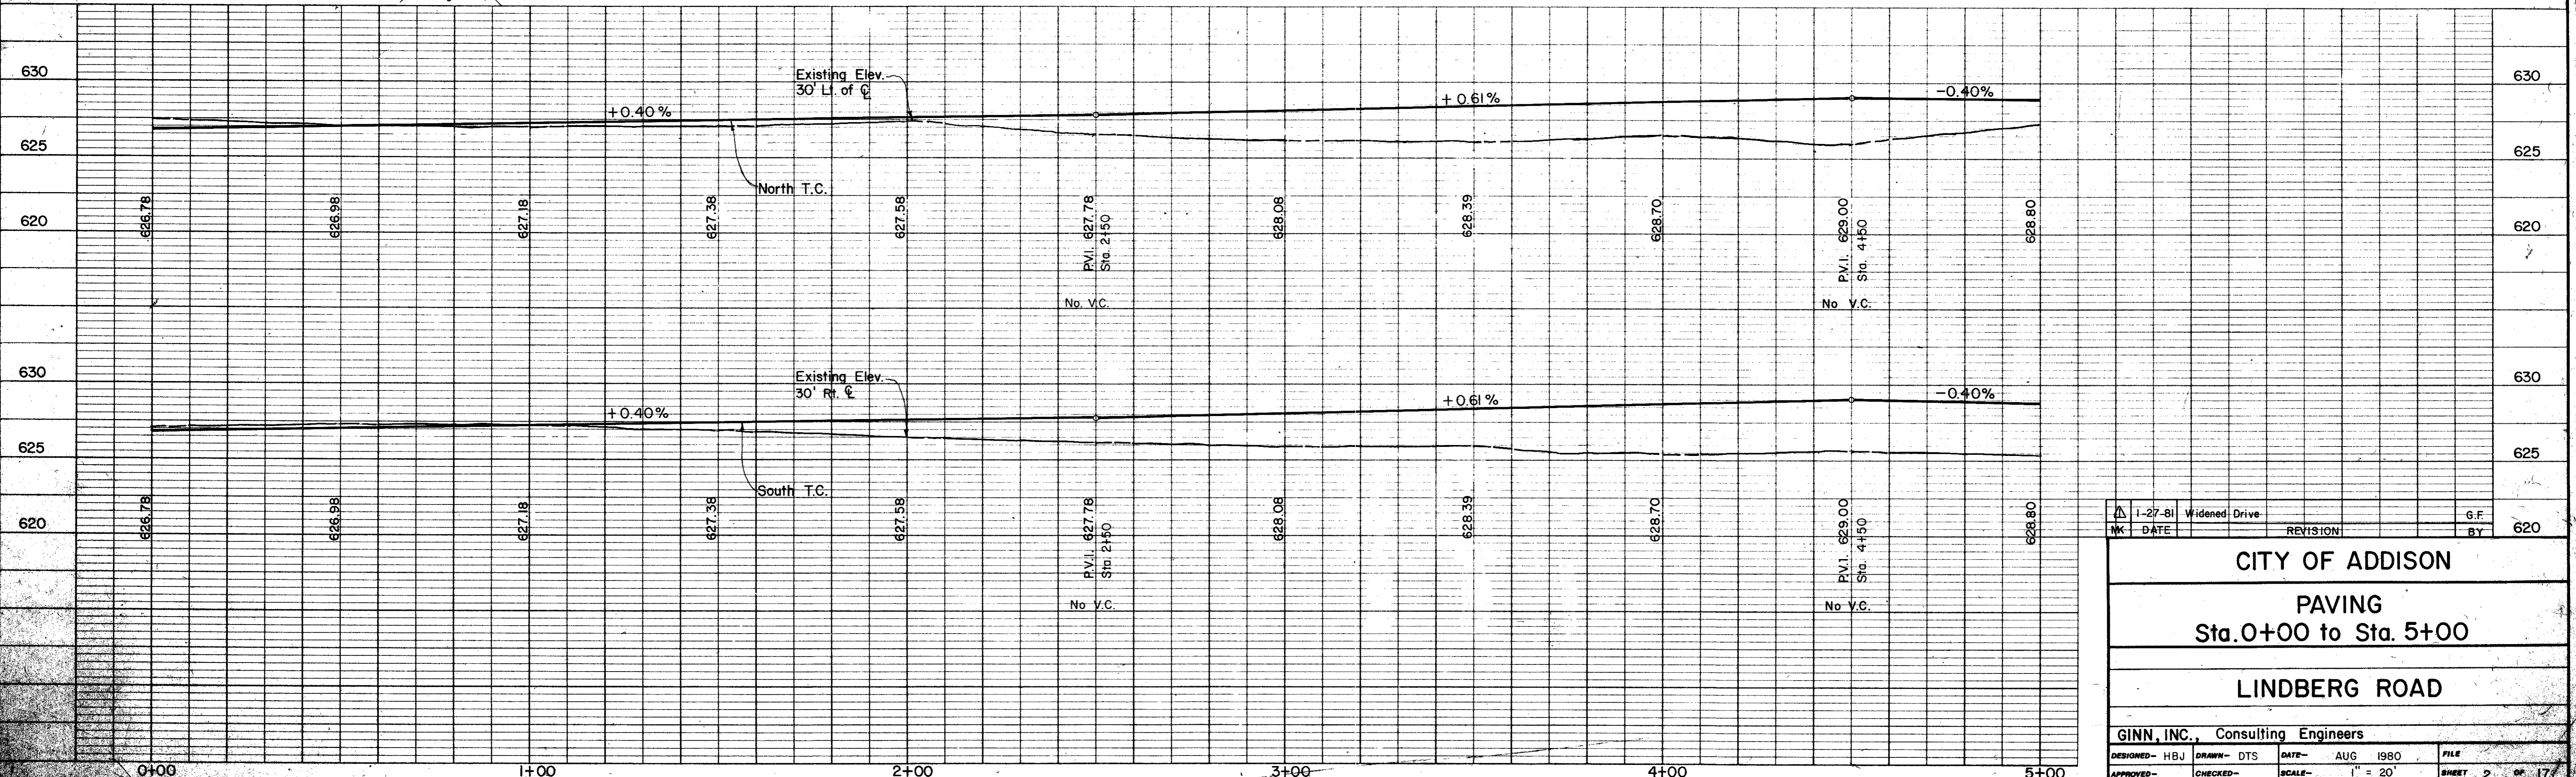

DESIGNED - HBJ	DRAWN - DTS	DATE - AUG 1980	FILE
APPROVED -	CHECKED -	SCALE - 1" = 20'	SHEET 2 OF 17

CITY OF ADDISON
PAVING
Sta. 0+00 to Sta. 5+00
LINDBERG ROAD

GINN, INC., Consulting Engineers