

TRACT "D"
FIELD NOTES


Being a tract or parcel of land in the Edward Cook Survey, Abstract No. 326, CITY OF ADDISON, DALLAS COUNTY, TEXAS, and being part of a 3.644 acres, further described as Lots 5 and 6 of Block D of Addison Airport Industrial District, filed October 29, 1962, Volume 50-207.

BEGINNING at an iron pin, said pin being the point of intersect of Addison Airport west property line and the south right-of-way line of Lindberg Drive;


THENCE, South 20°39'35" East for a distance of 76.24 feet along the Addison Municipal Airport west property line to a point where it intersects with a curve having a radius of 303 feet and a central angle of 41°33'03";

THENCE, along the arc of said curve in a westerly direction curving to the left for a distance of 219.74 feet;


THENCE, North 69°10'30" East for a distance of 201 feet along the south right-of-way line of Lindberg Drive to the POINT OF BEGINNING, containing 0.110 acres of land more or less. (4,792 square feet)

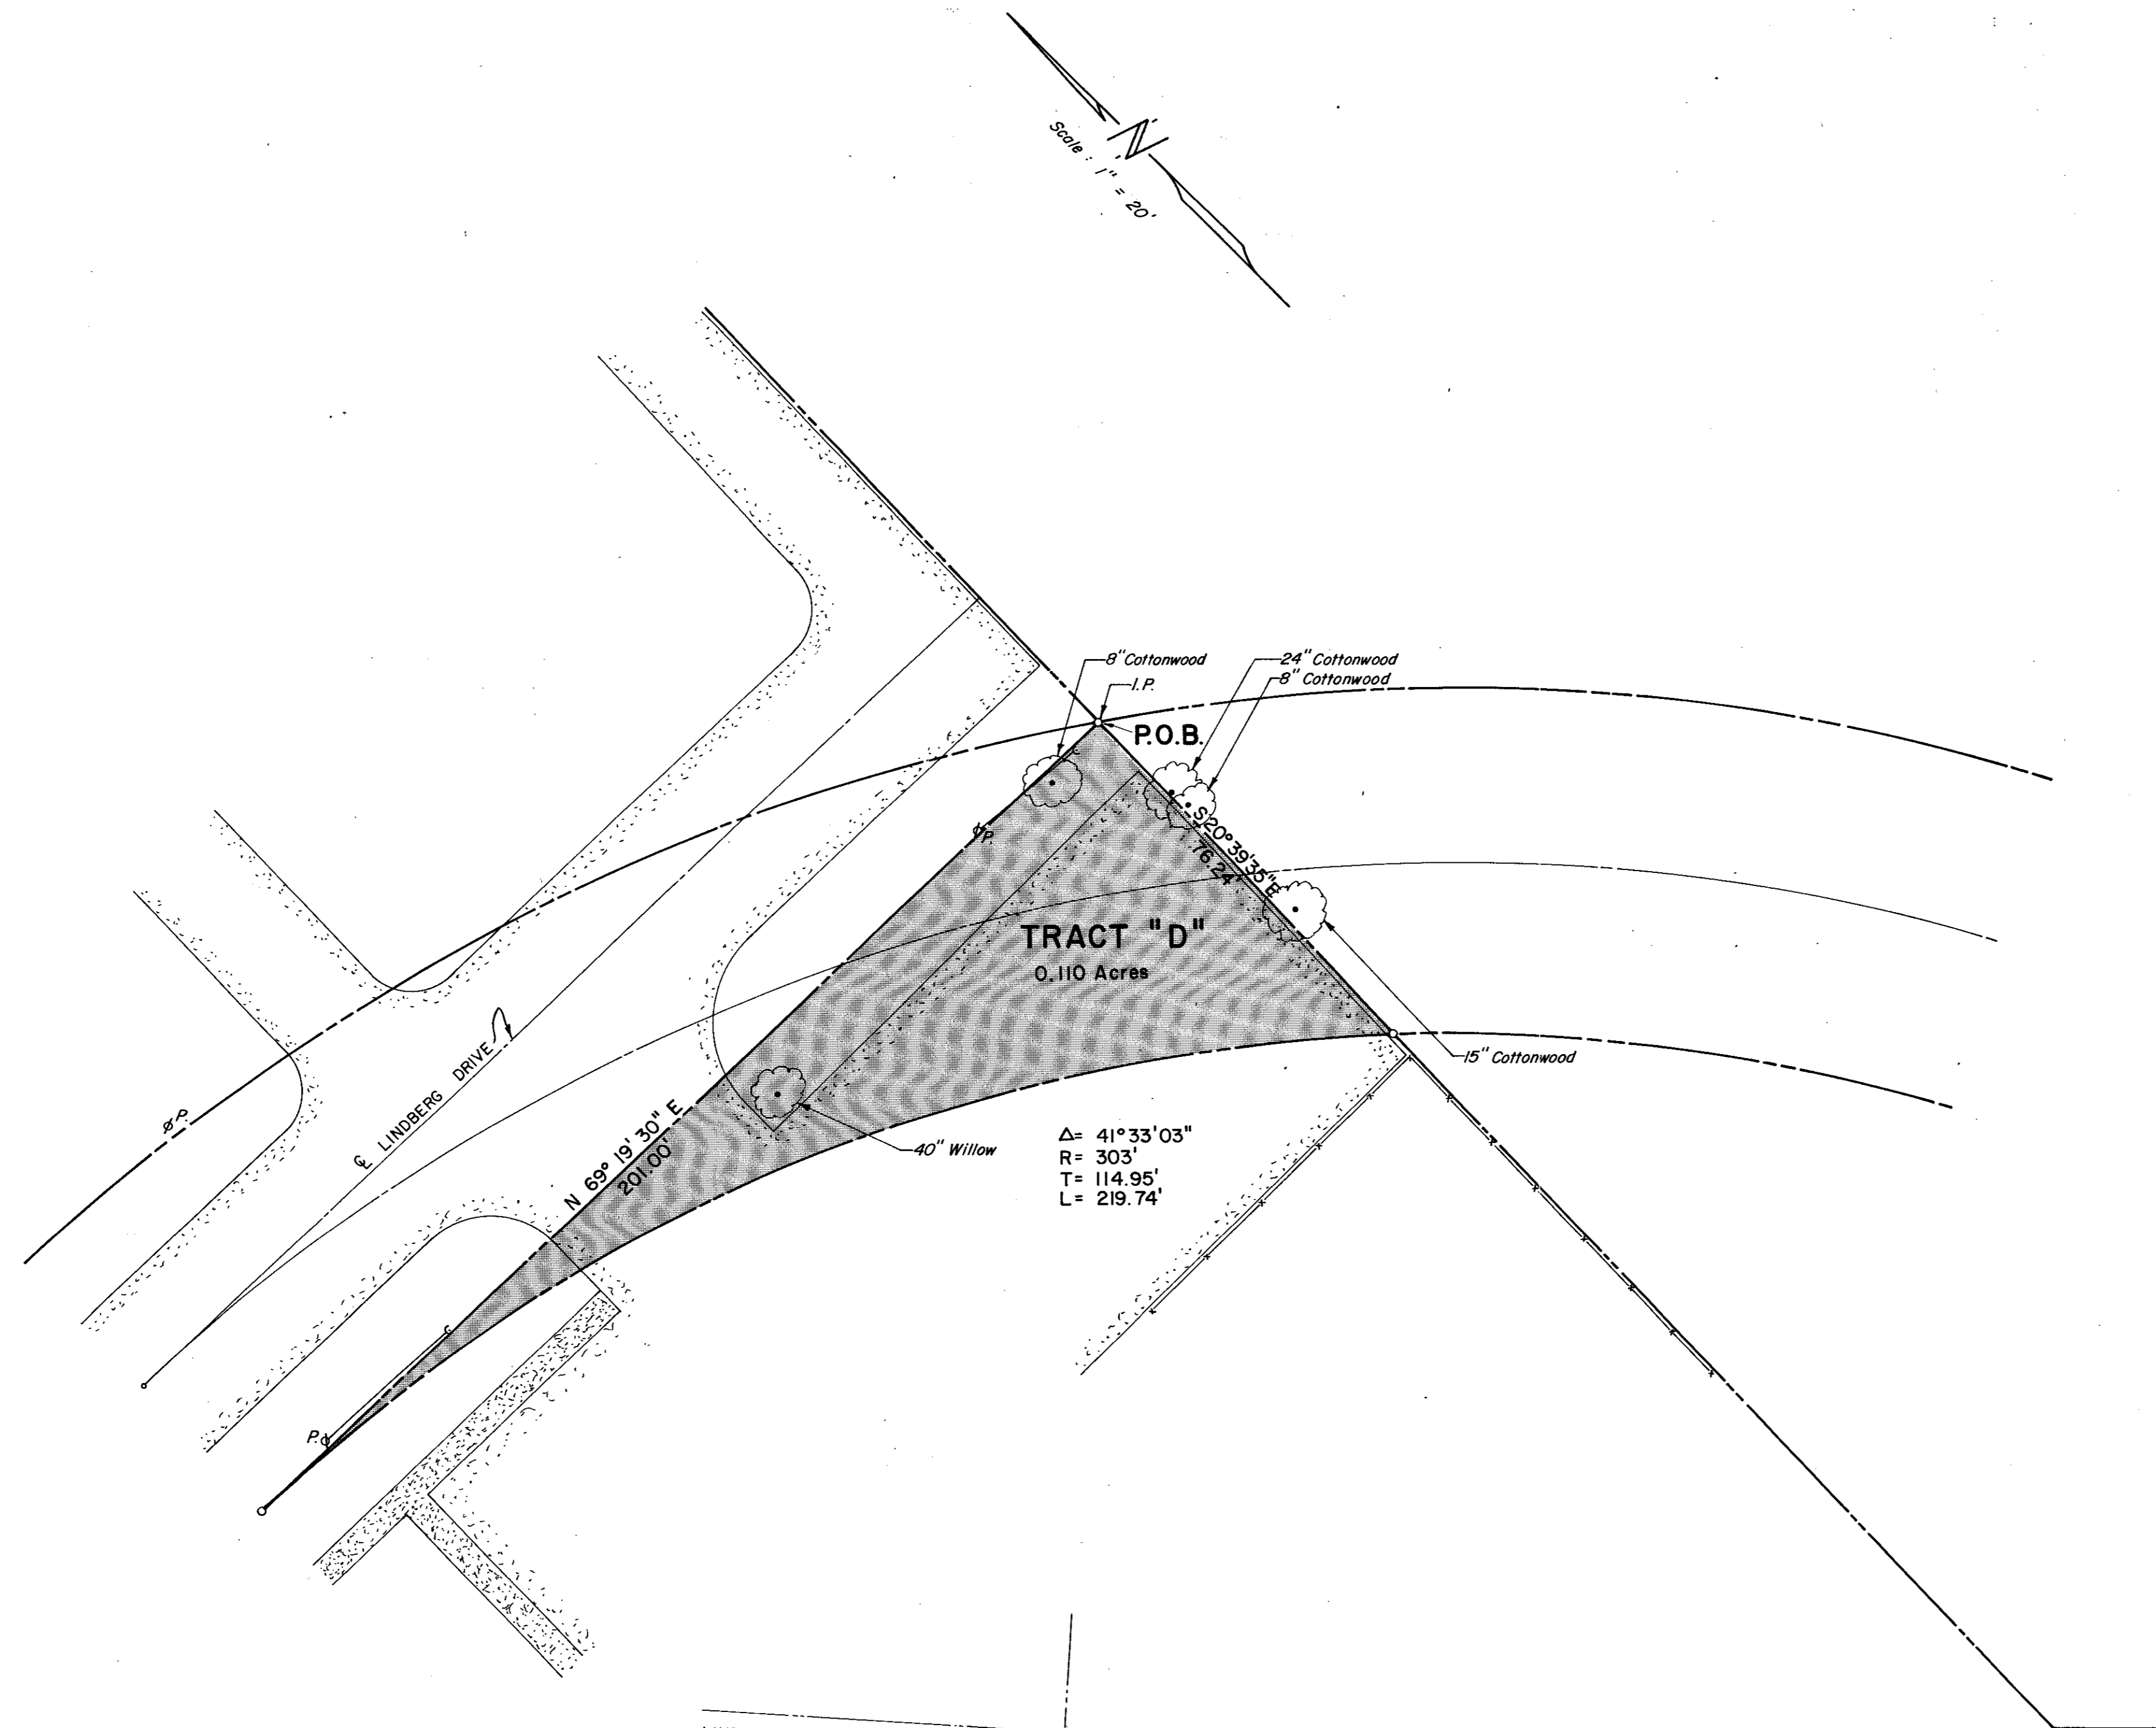

Δ= 41°33'03"
R= 303'
T= 114.95'
L= 219.74'

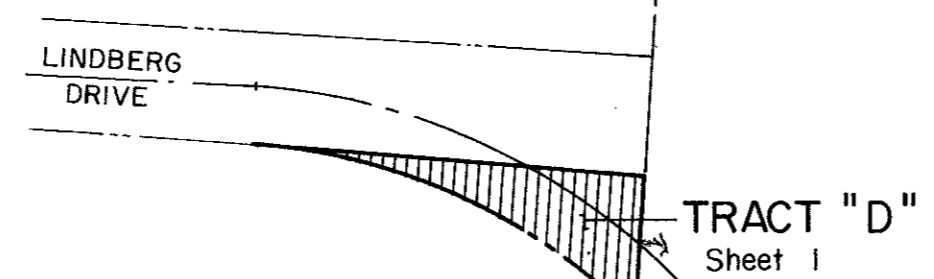

LOCATION PLAN
Scale: 1"=100'

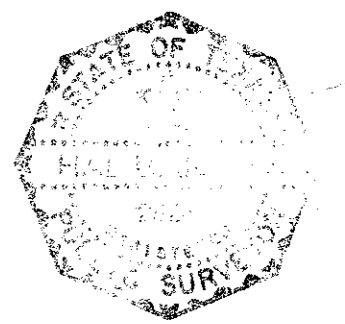

Record Drawing 4/9/85

| | | | |
|-----------------------------------|------------|-----------------|--------------|
| CITY OF ADDISON LINDBERG DRIVE | | | |
| DALLAS COUNTY, | | TEXAS | |
| PROPOSED RIGHT-OF-WAY | | | |
| GINN, INC., CONSULTING ENGINEERS | | | |
| DESIGNED- HBJ | DRAWN- DTS | DATE- AUG. 1980 | FILE |
| APPROVED- | CHECKED- | SCALE- 1"=20' | SHEET 1 OF 3 |

E-H